

830A

3099

Samuel Shanks

J.E. Sunderland
Map of the
"Coal Bank Meadow"

Showing
Location of Sunderlands Mine,
Lawrence Twp. Clearfield Co. Pa.

Clearfield Pa. Office of E. W. Hess,
Jan. 5-1911
RE-SURVEYED
OCT. 17-1913
Scale 1"=50'
Engineer


830A

John Thompson

Leavy Estate

19.5 A²

Probable Outcrop

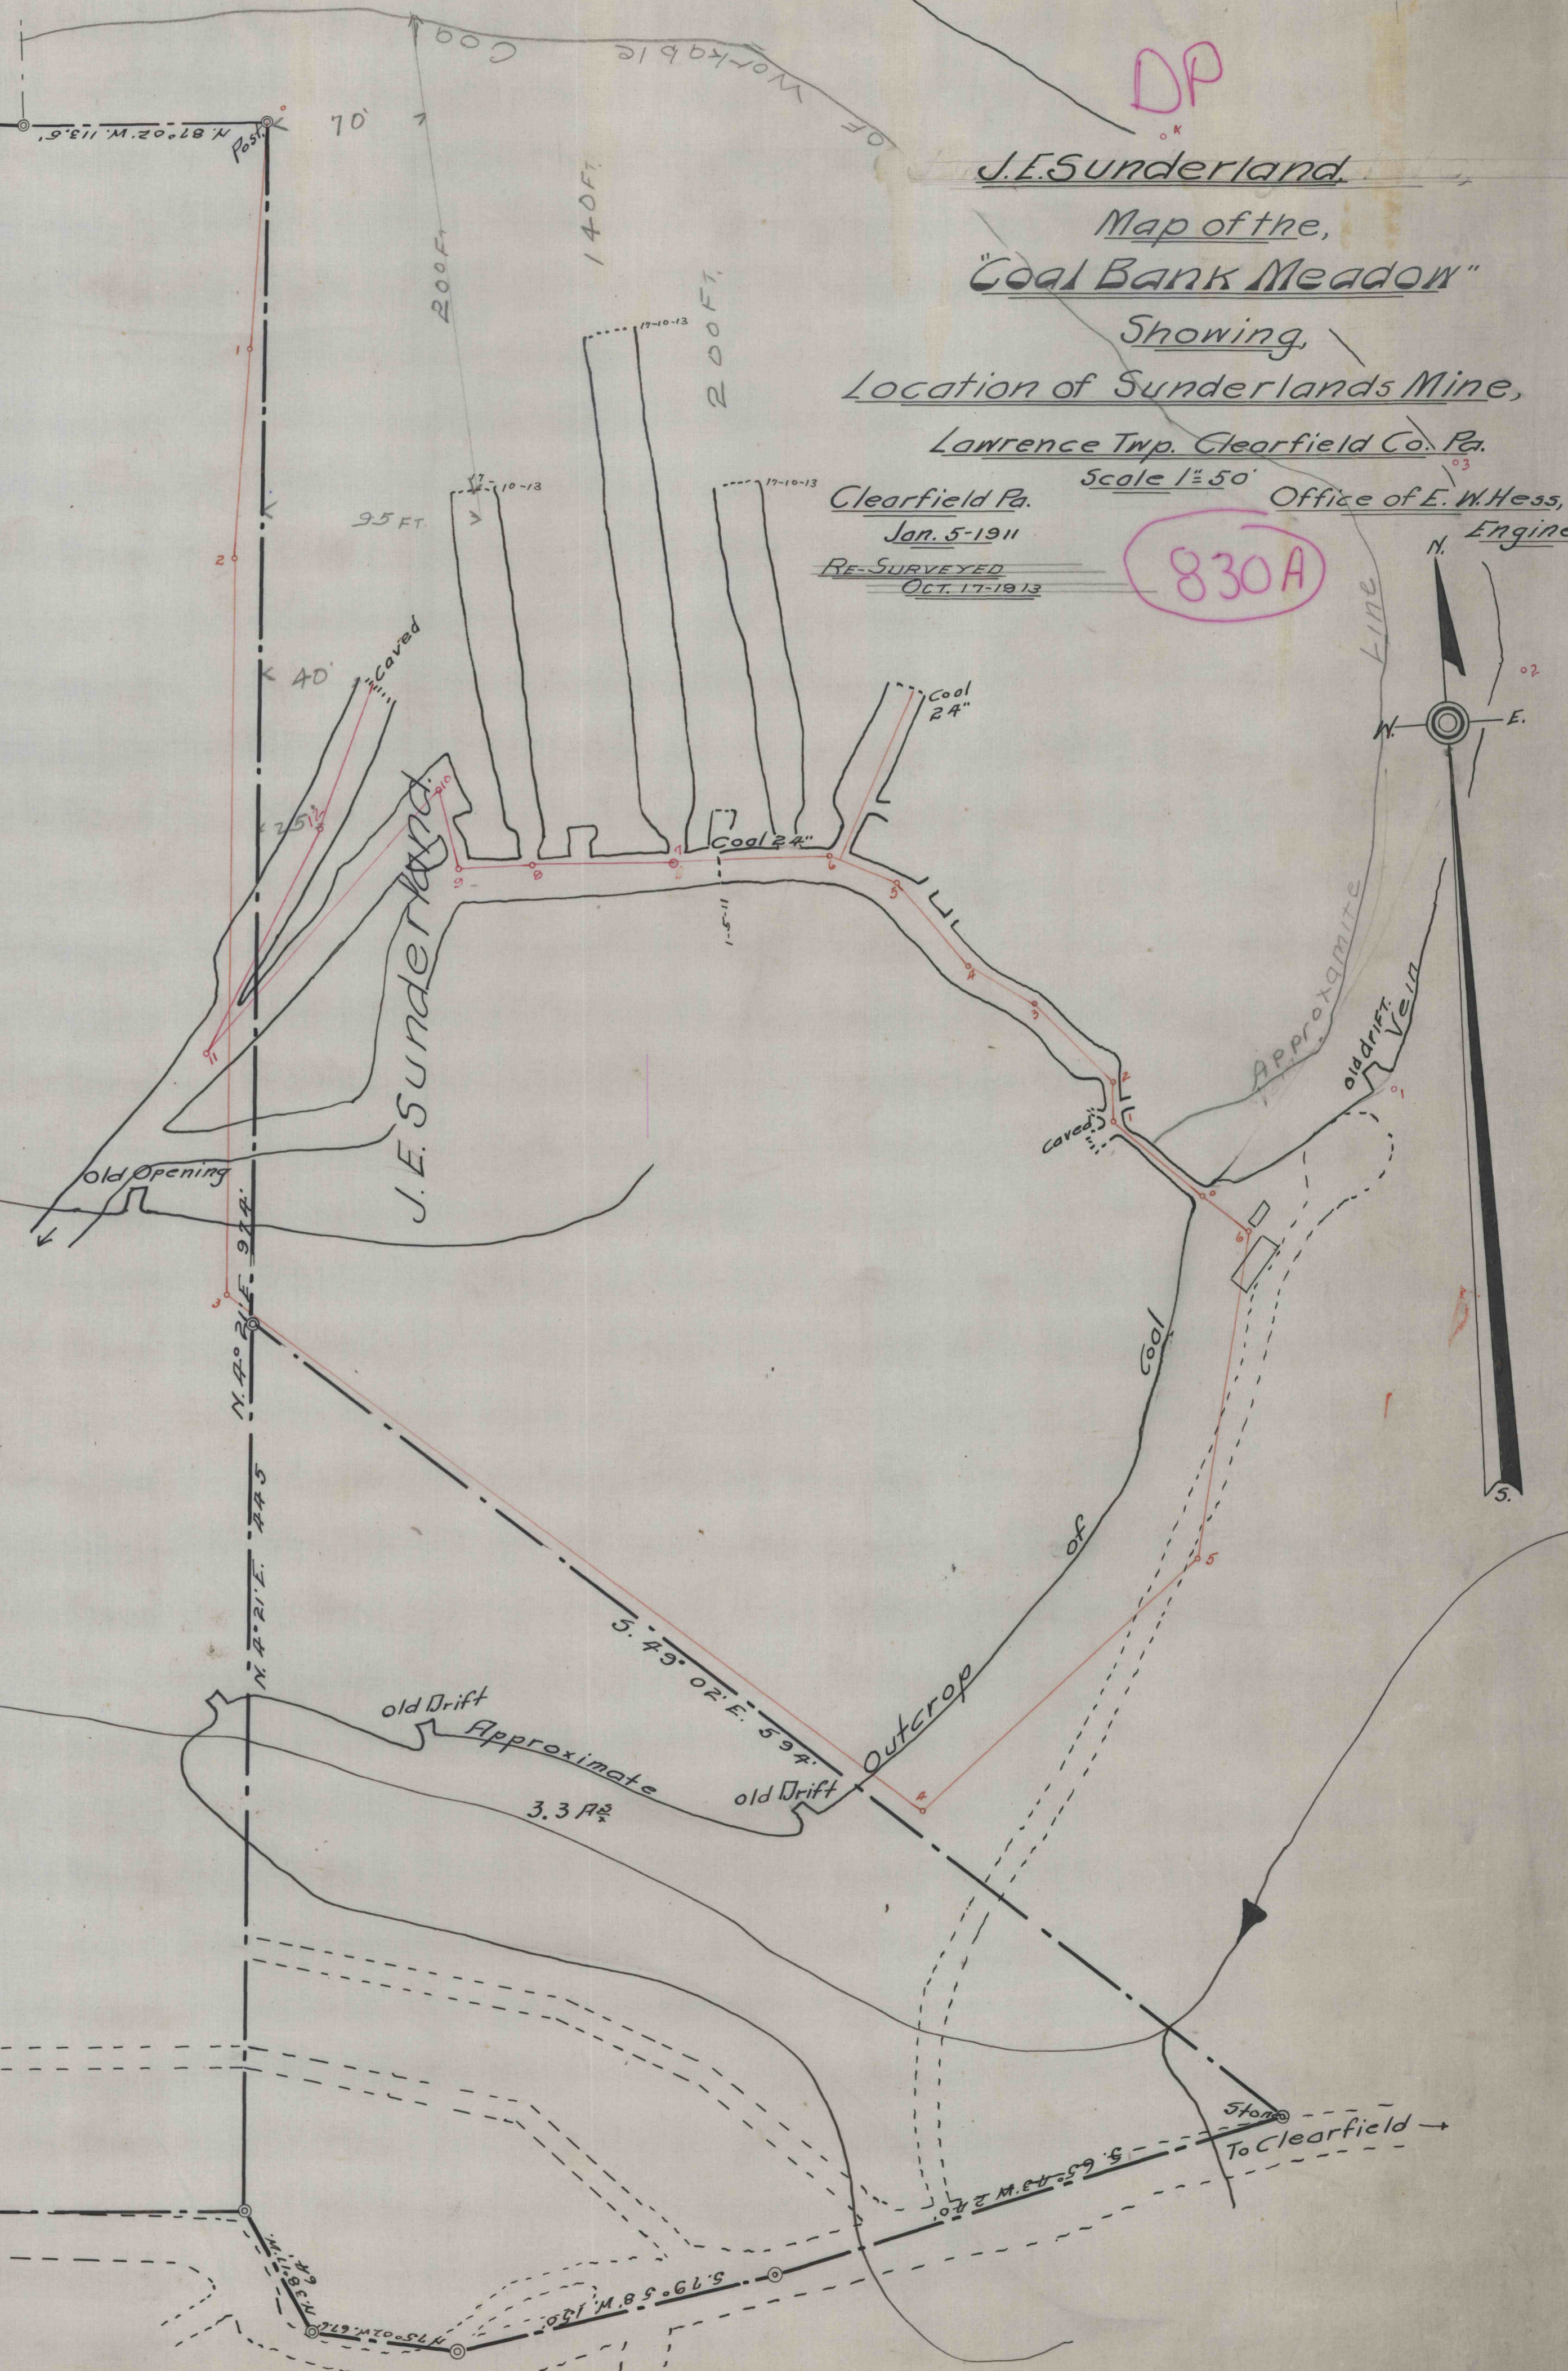

Robert Cowen

Stop
To Clearfield

3098