


10/27/22
W.A. Swann
Irvin Hopkins & Swann

Josiah Lamborn

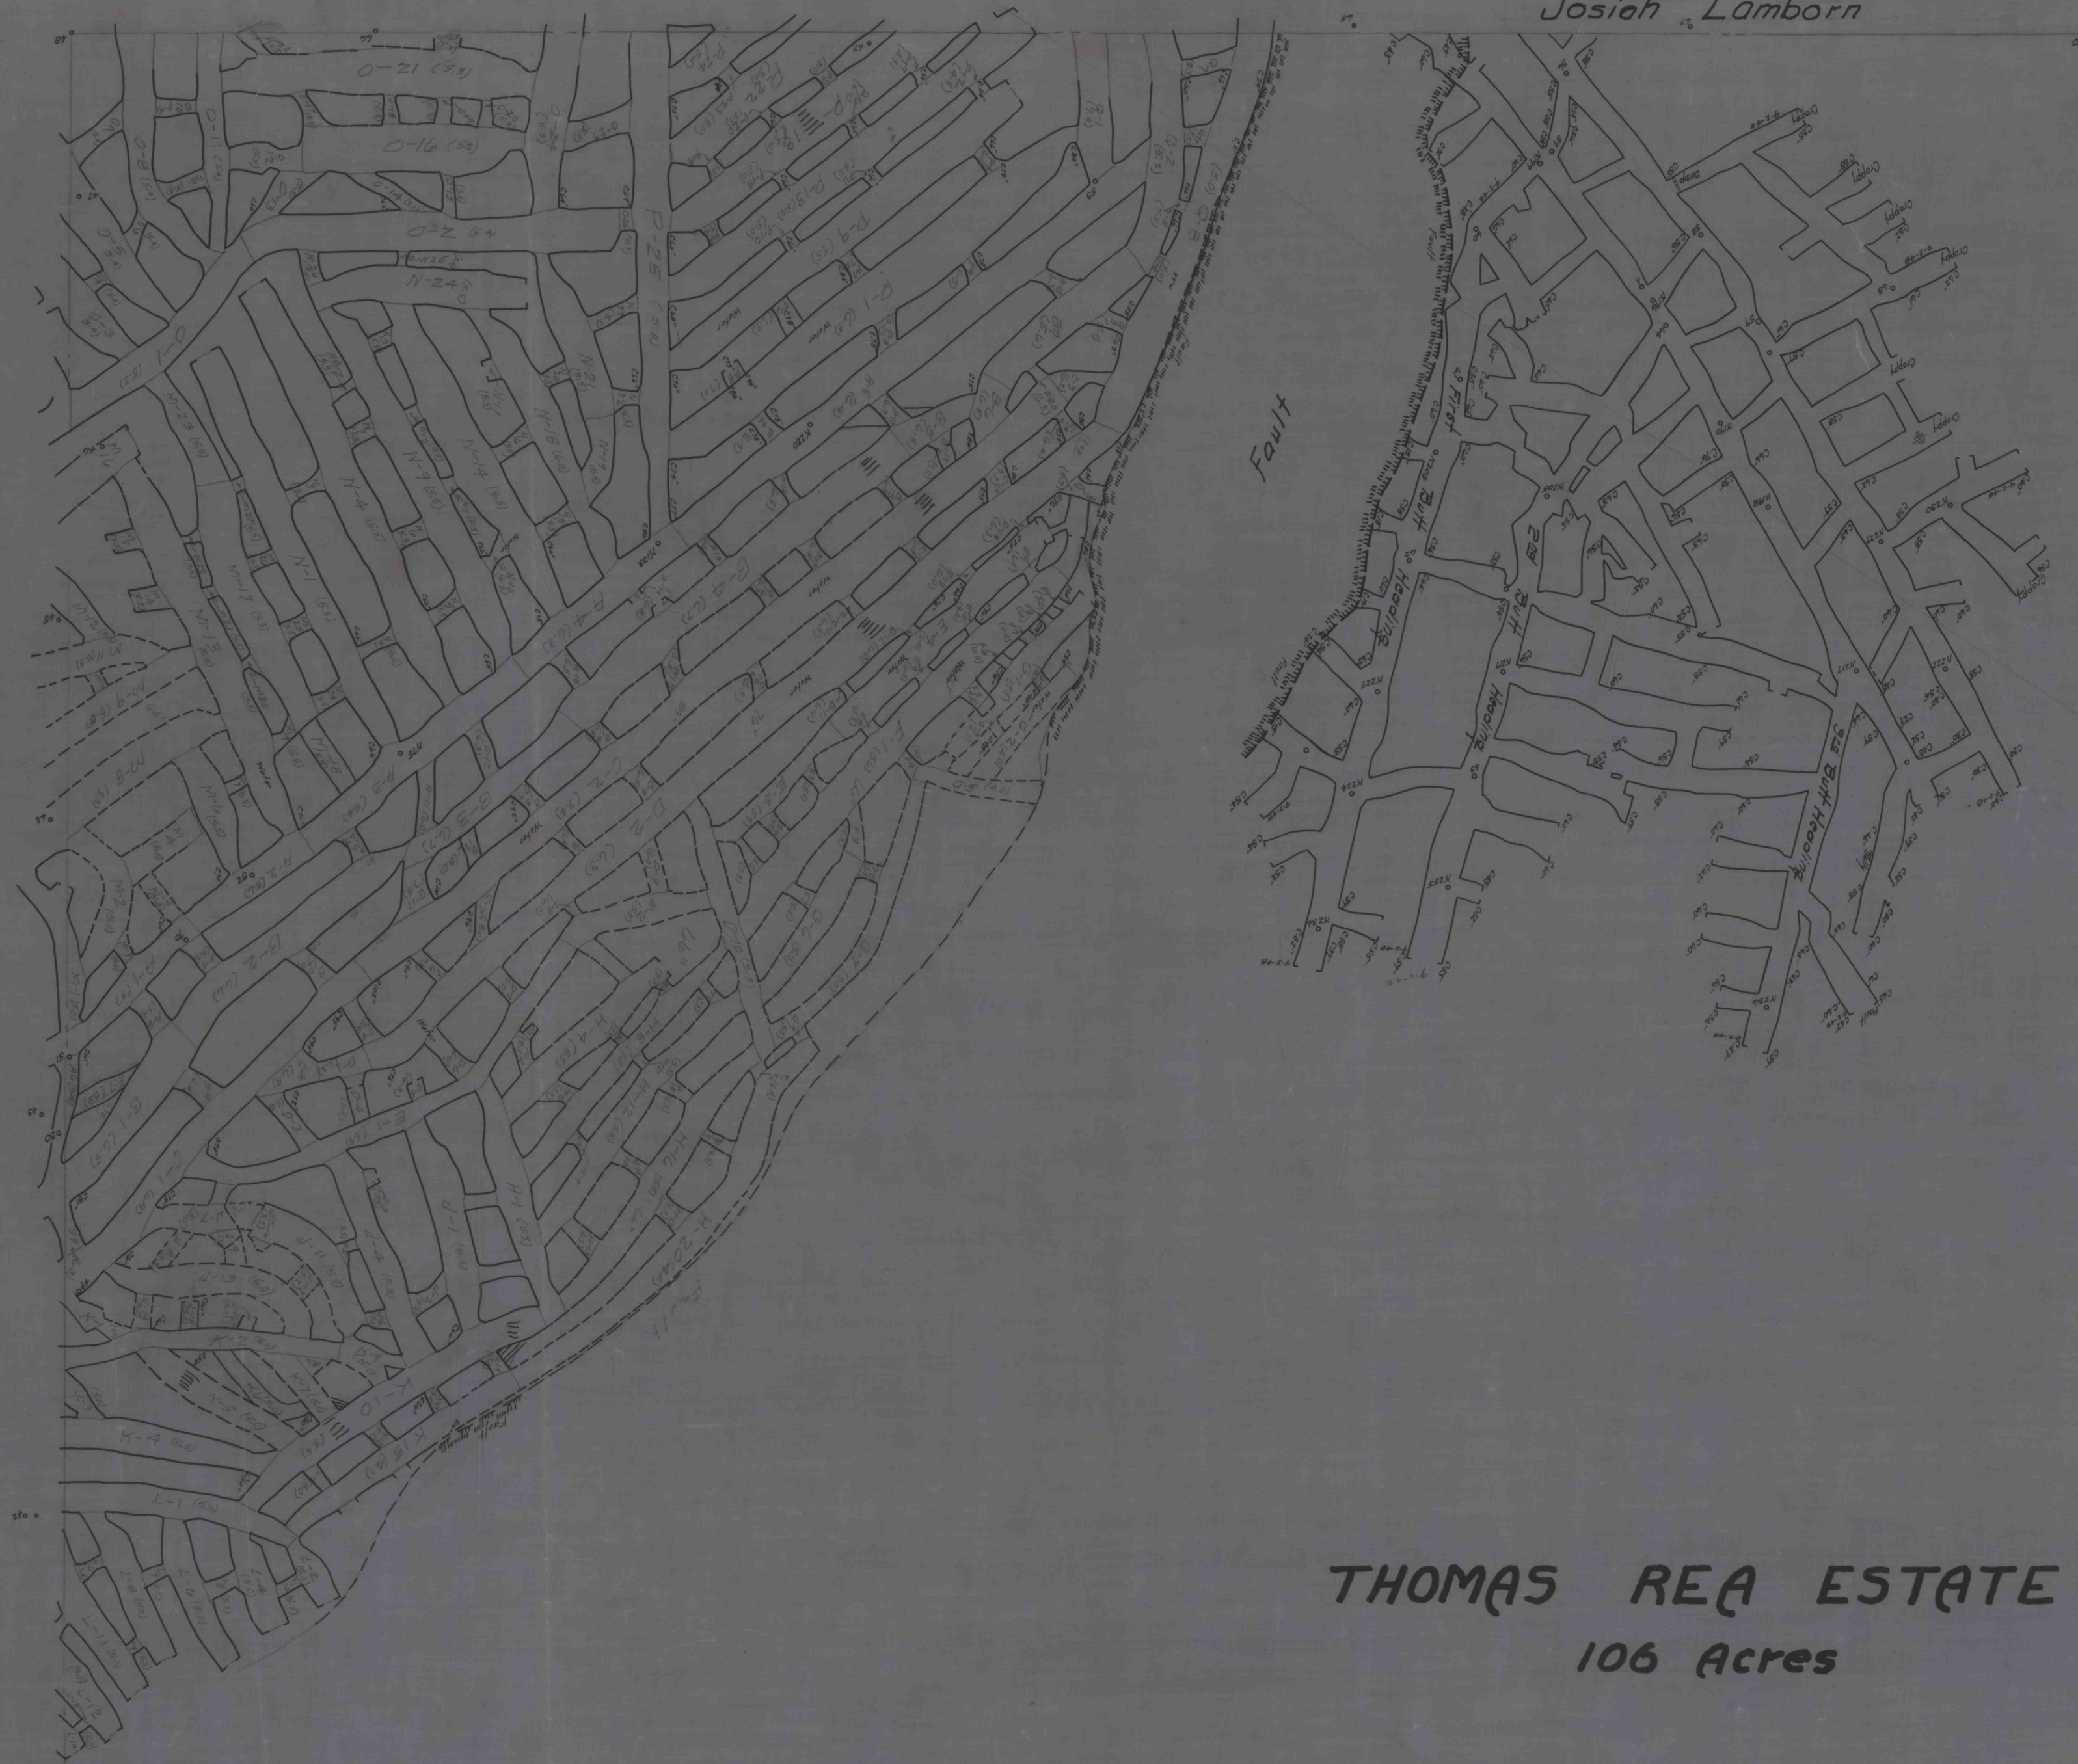

5 Miles Bloom Est

THOMAS REA ESTATE
106 Acres

Irvin Hopkins & Swann

By Showing
JORDAN COAL CO MINE
in Fee
THOMAS REA ESTATE
Jordan Twp. Clearfield Co. Penna.
Scale 1"=50'
October 11, 1922
Clearfield, Penna. Engineering Office
1027 BROADVIEW AVE.

W.A. Swann
Irvin Hopkins & Swann