


3334
1054-A

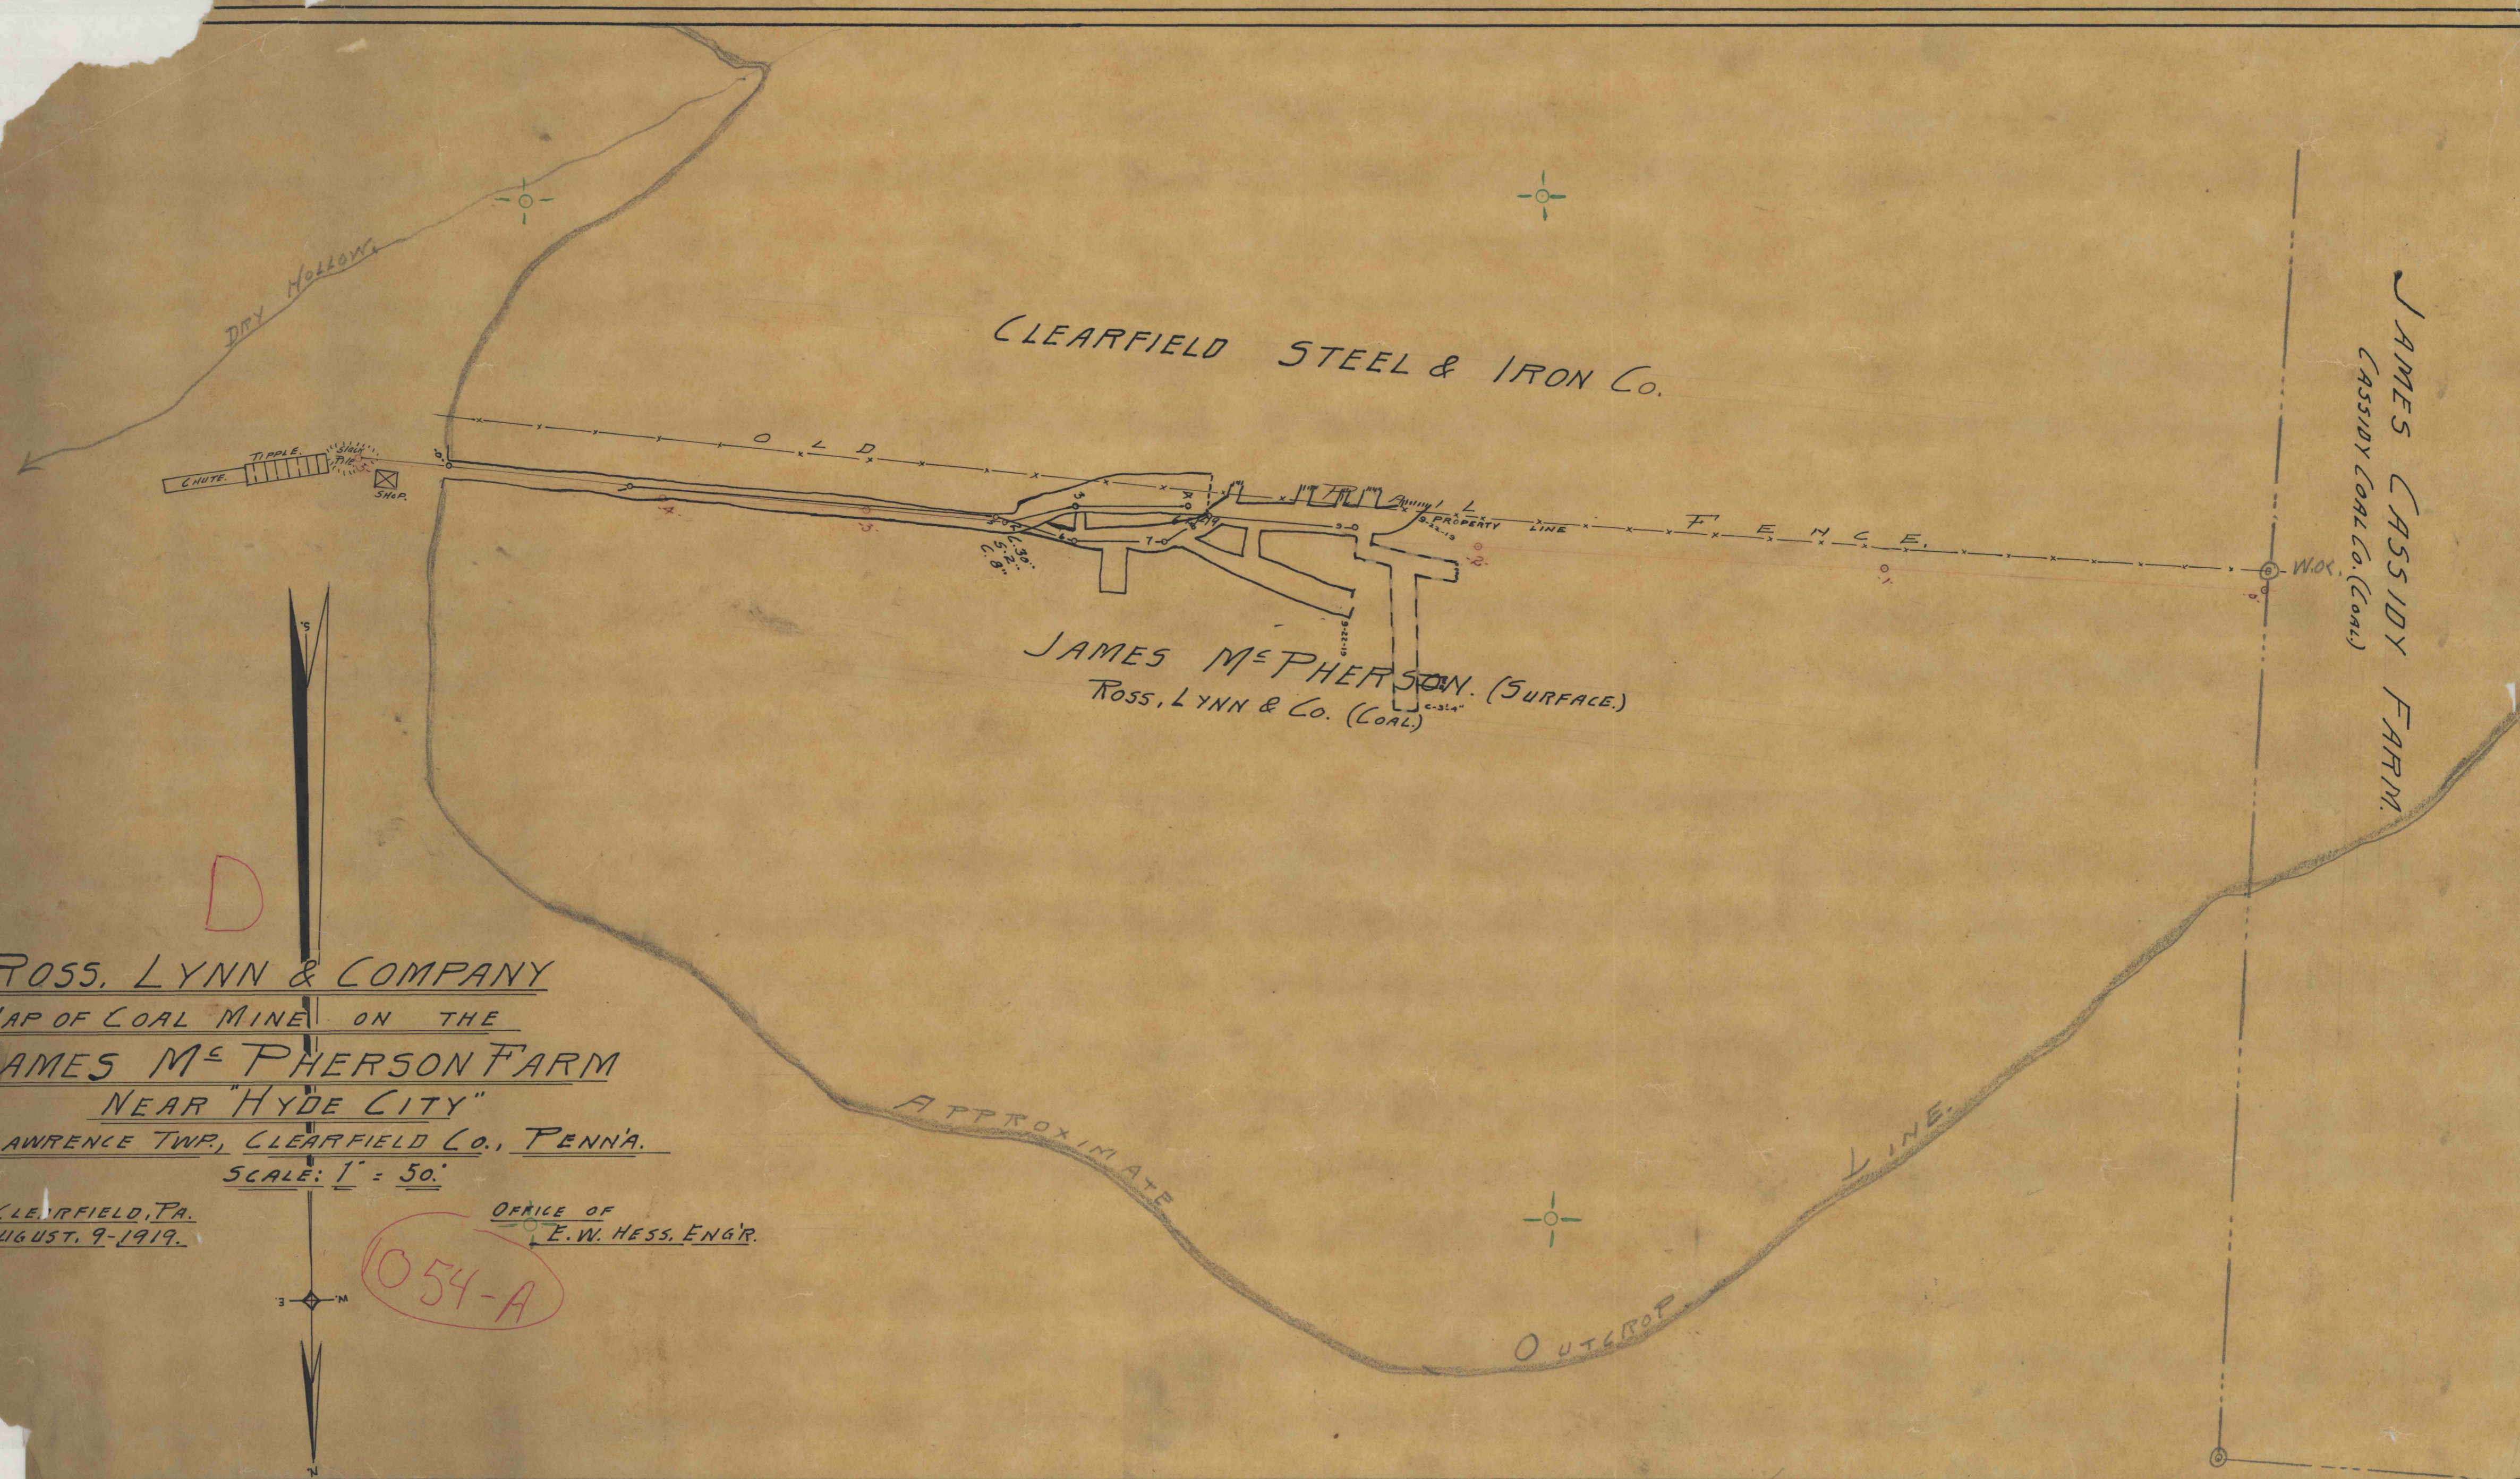

ROSS, LYNN & COMPANY
 MAP OF COAL MINE ON THE
 JAMES McPHERSON FARM
 NEAR "HYDE CITY"
 LAWRENCE TWP., CLEARFIELD CO., PENNA.
 SCALE: 1" = 50'

CLEARFIELD, PA.
 AUGUST, 9-1919.

OFFICE OF
 E.W. HESS, ENGR.

1054-A

M. BAILEY EST.

3334
1054-A