


2529

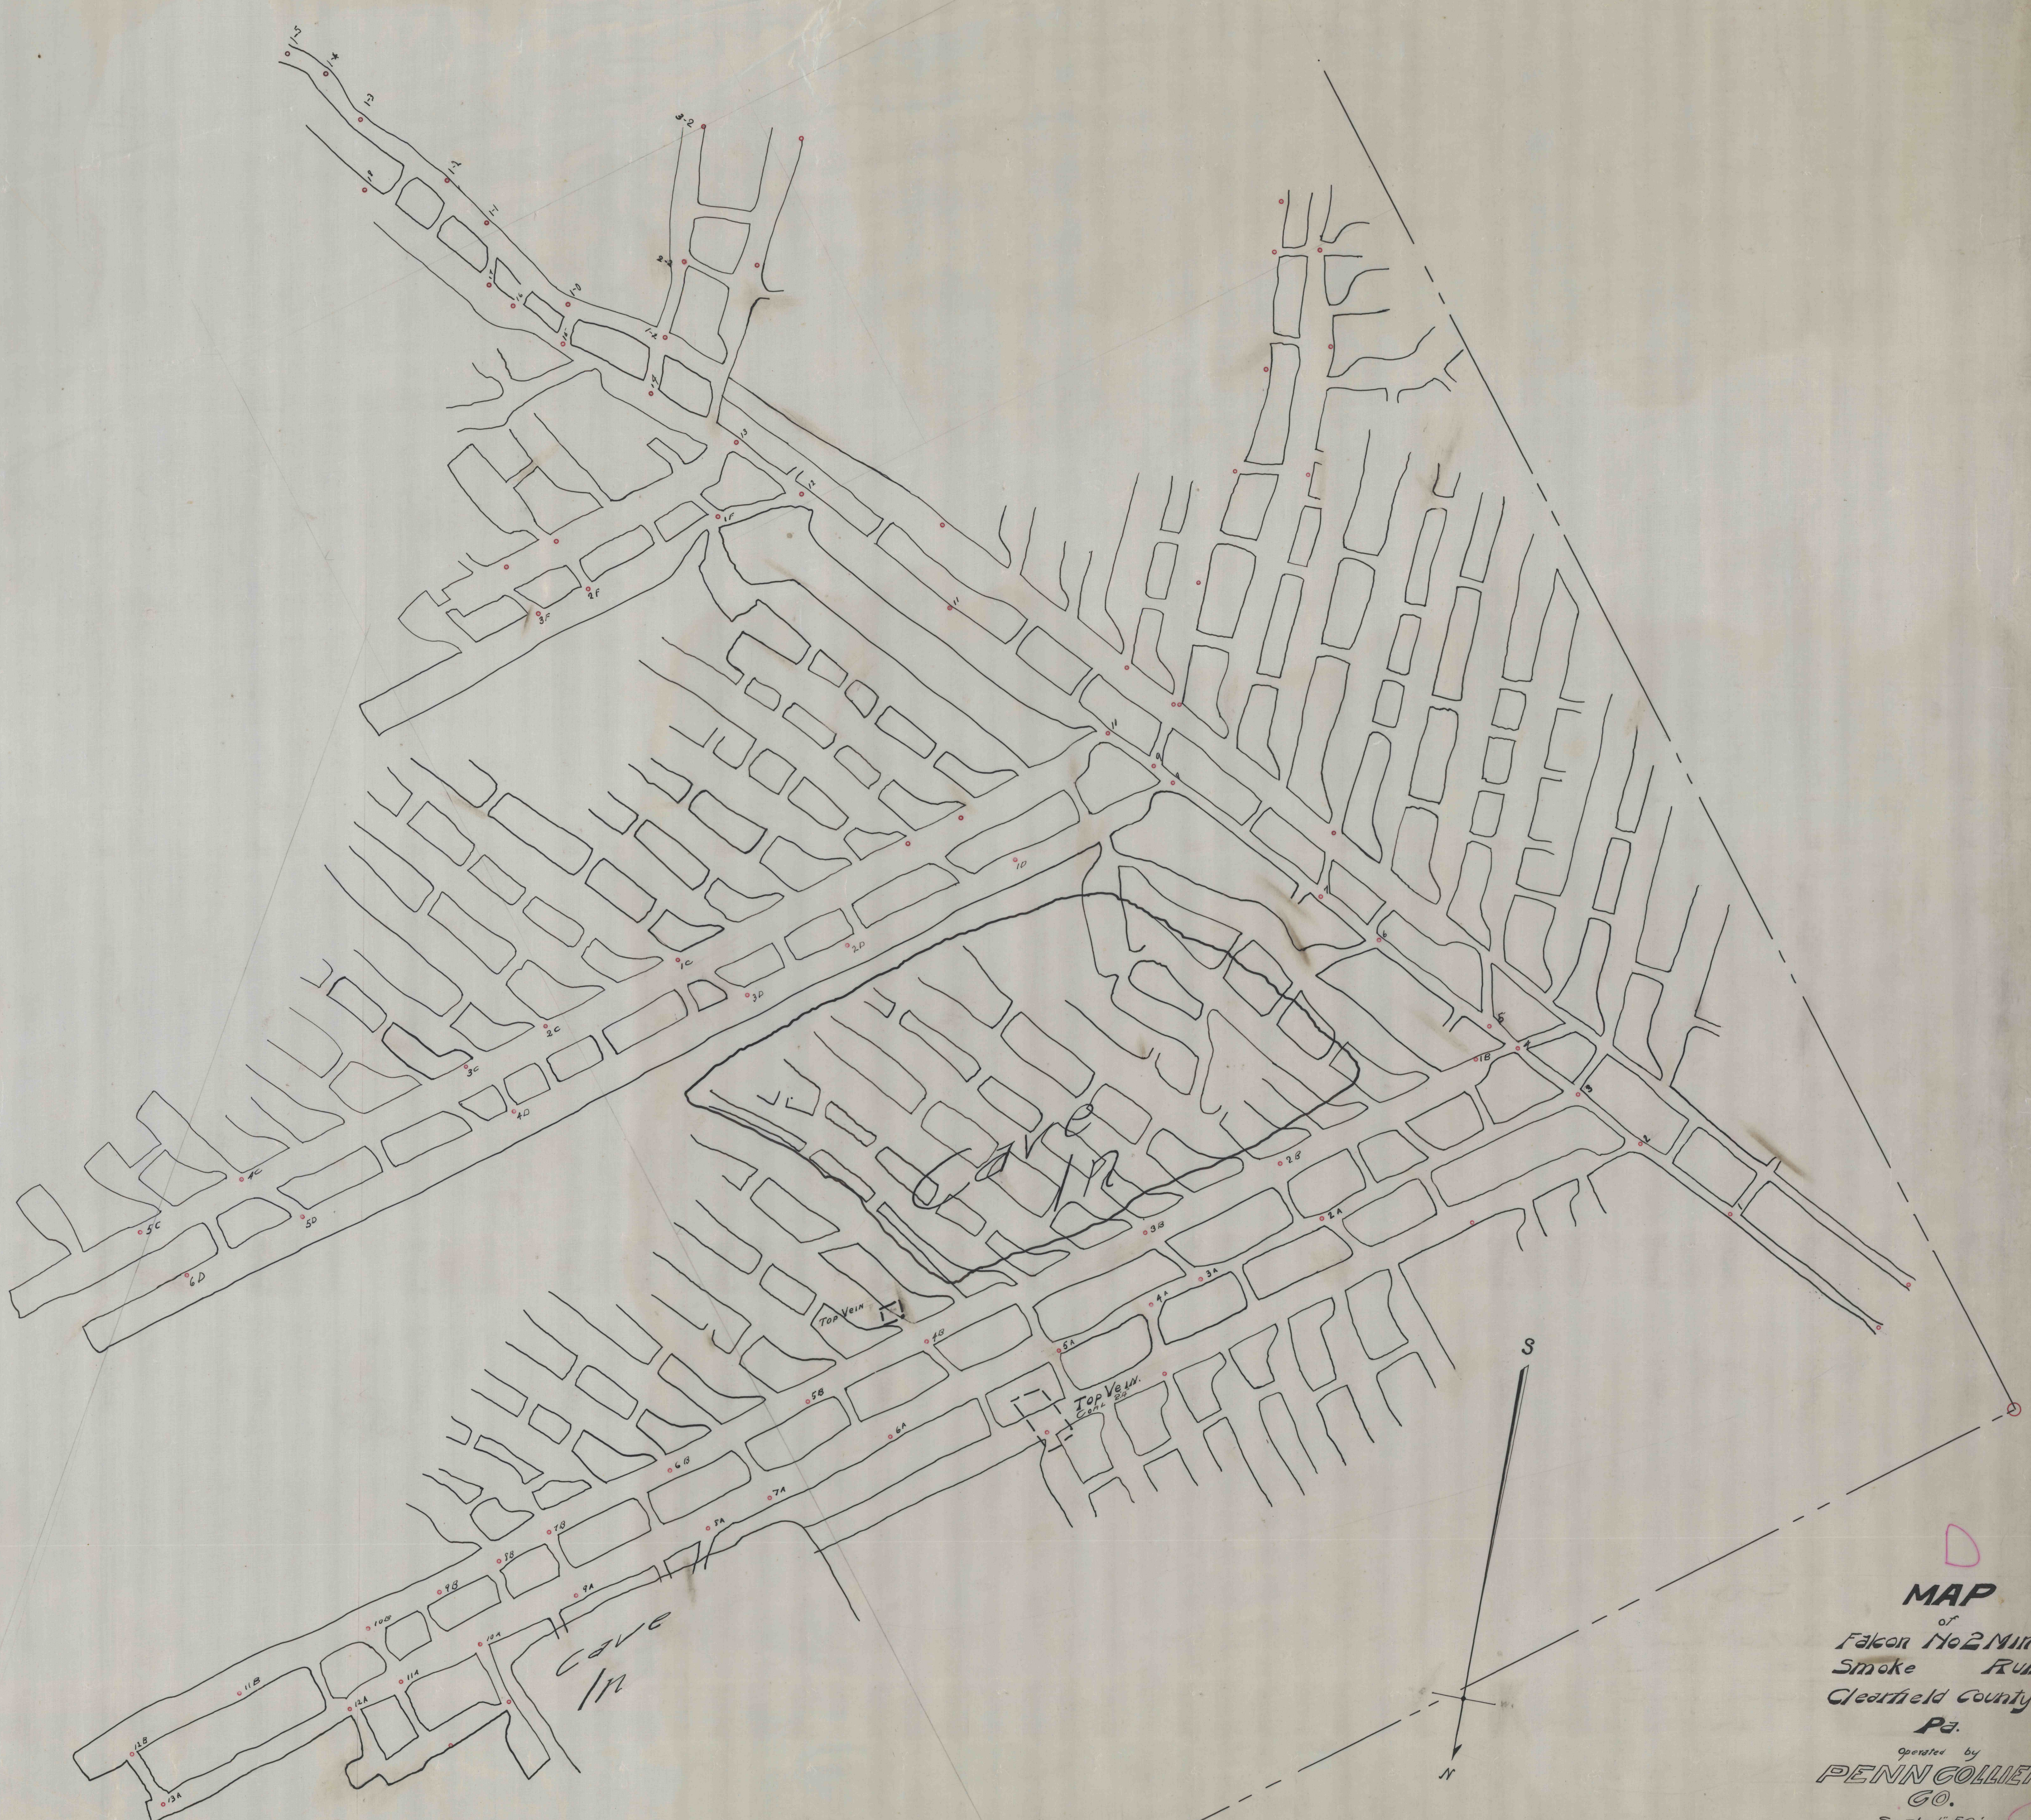

D  
**MAP**  
 of  
 Falcon No 2 Mine  
 Smoke Run  
 Clearfield County  
 Pa.  
 Operated by  
**PENN COLLIERY**  
 CO.  
 Scale 1"=50'

829

330