


032

360

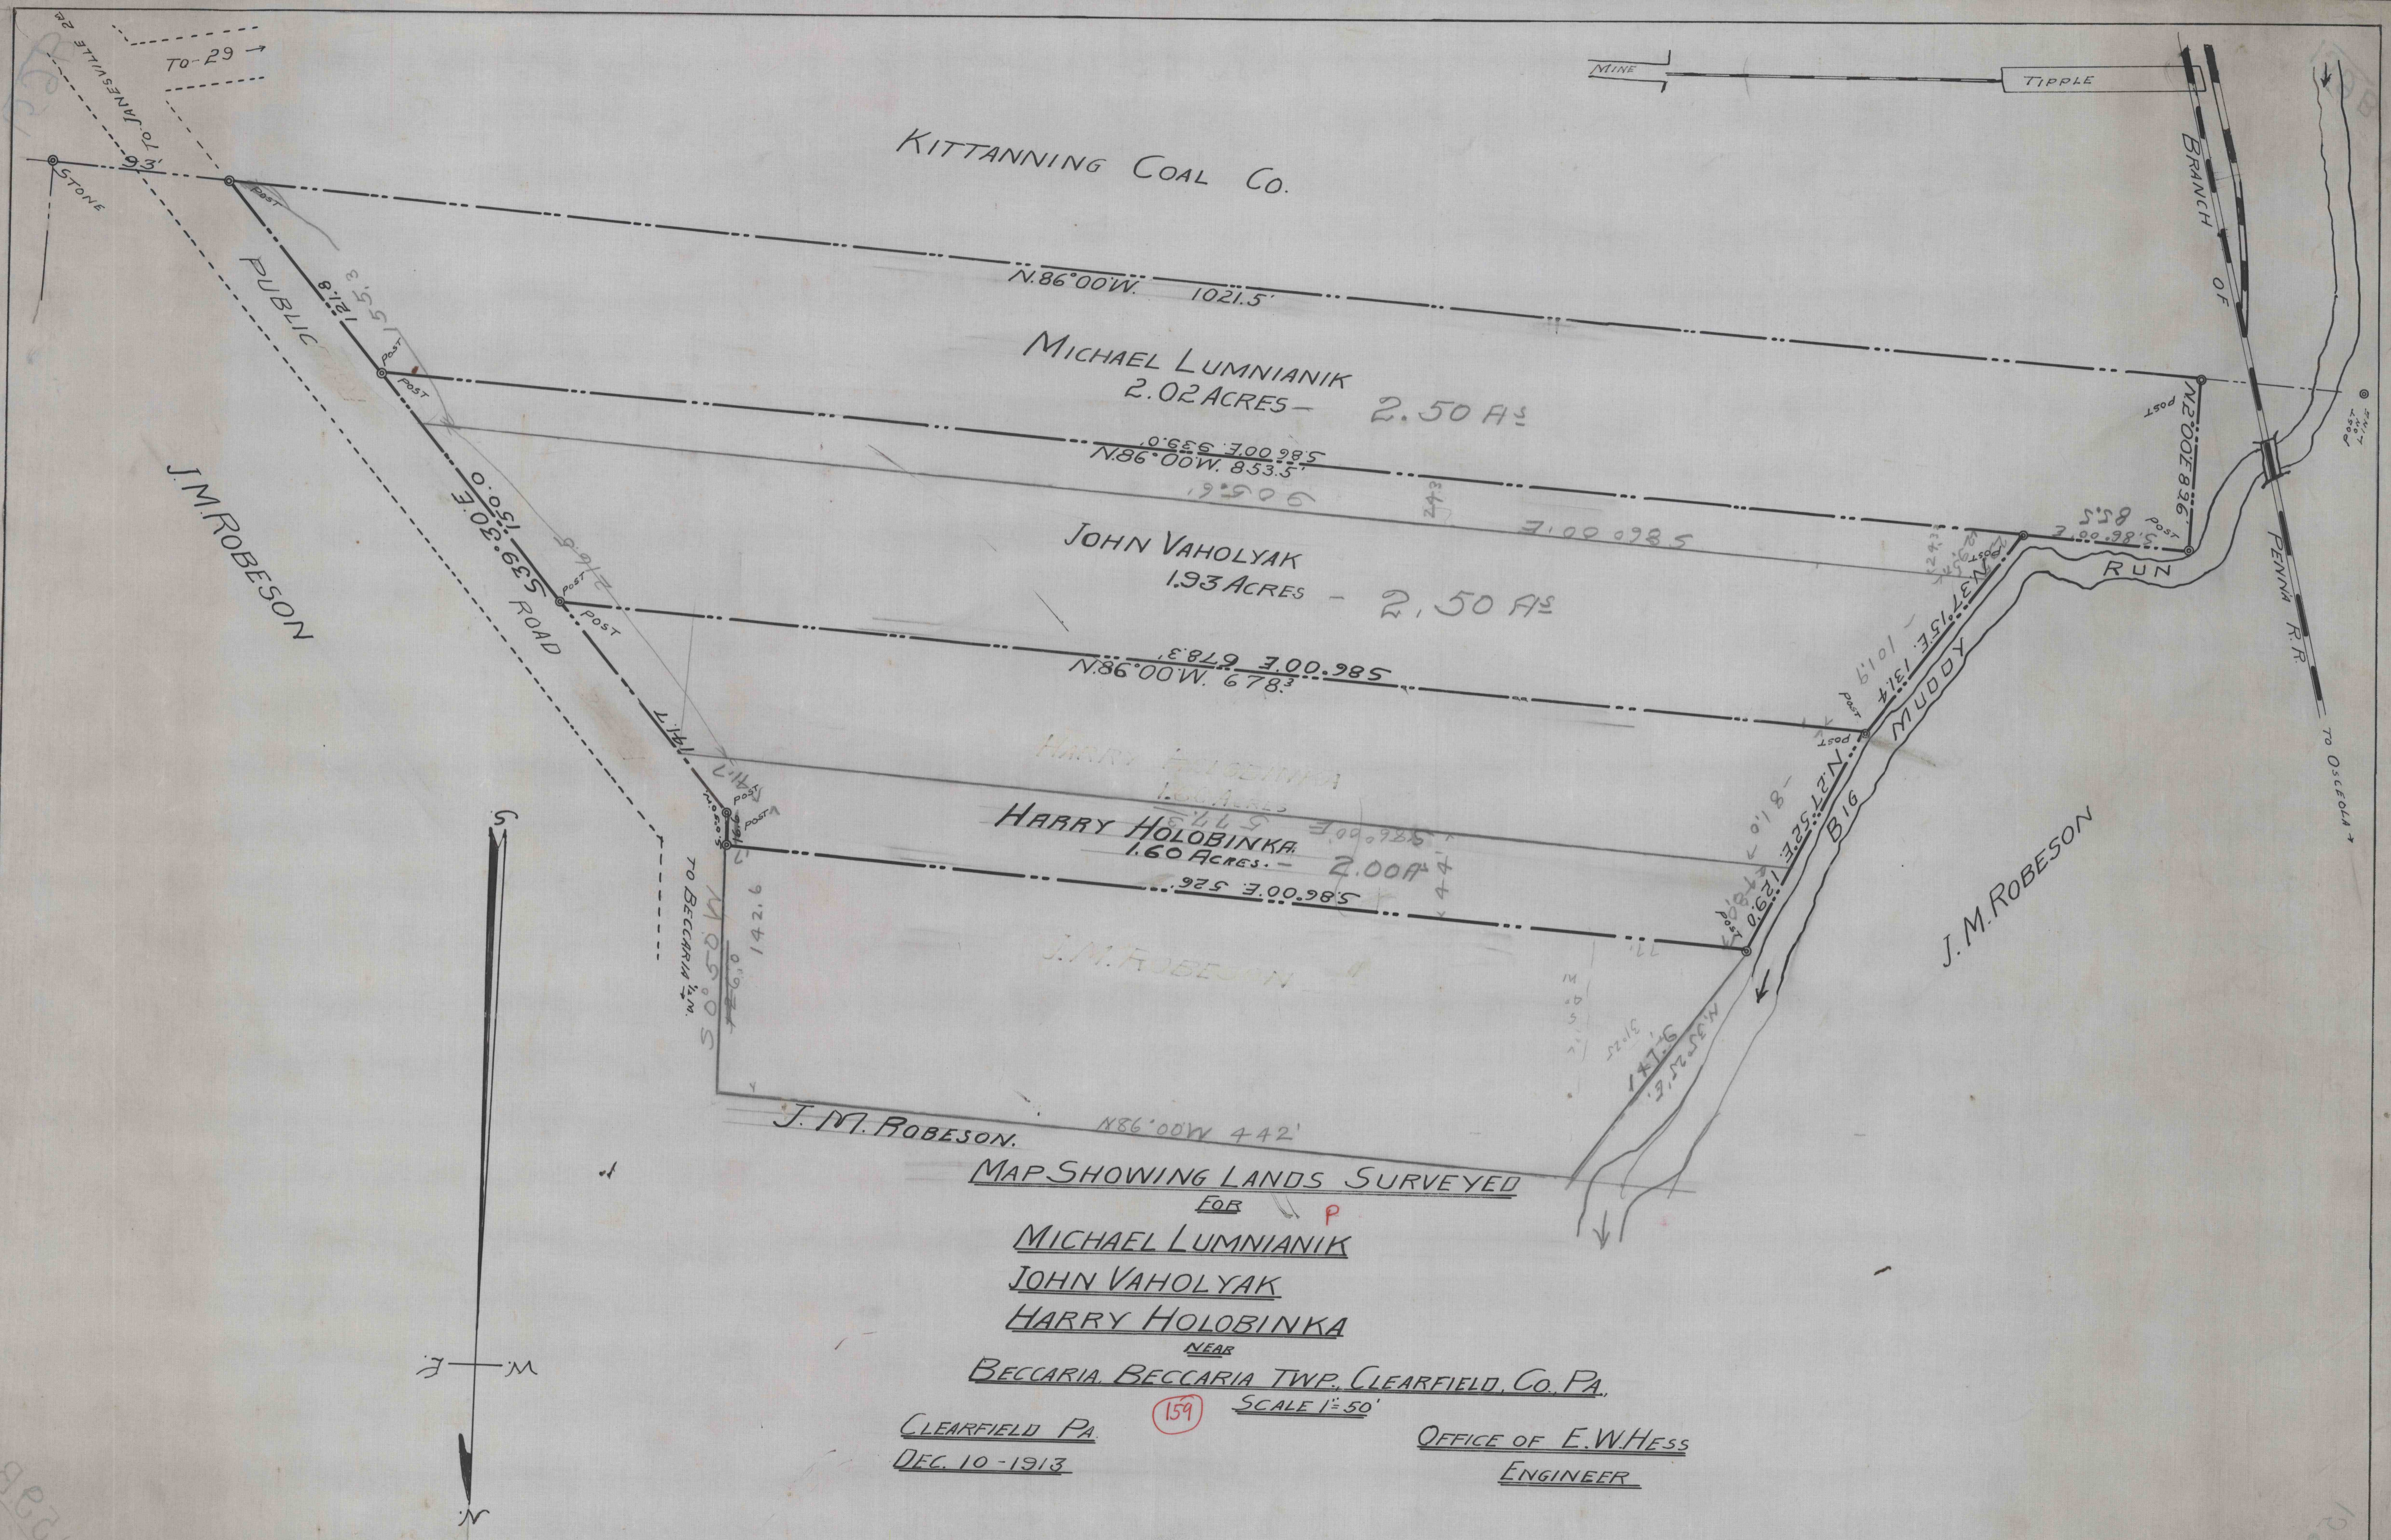

KITTANNING COAL CO.

MICHAEL LUMNIANIK
2.02 ACRES - 2.50 A±

JOHN VAHOLYAK
1.93 ACRES - 2.50 A±

HARRY HOLOBINKA
1.60 ACRES - 2.00 A±

PUBLIC ROAD

J.M. ROBESON

J.M. ROBESON

MAP SHOWING LANDS SURVEYED

FOR P
MICHAEL LUMNIANIK
JOHN VAHOLYAK
HARRY HOLOBINKA

NEAR
BECCARIA, BECCARIA TWP., CLEARFIELD CO., PA.

CLEARFIELD PA
DEC. 10 - 1913

SCALE 1" = 50'

OFFICE OF E.W. HESS
ENGINEER

