


4619

1846 Net Tons mined Out and removed on East side of Property Line

SCALE = 1" = 50'

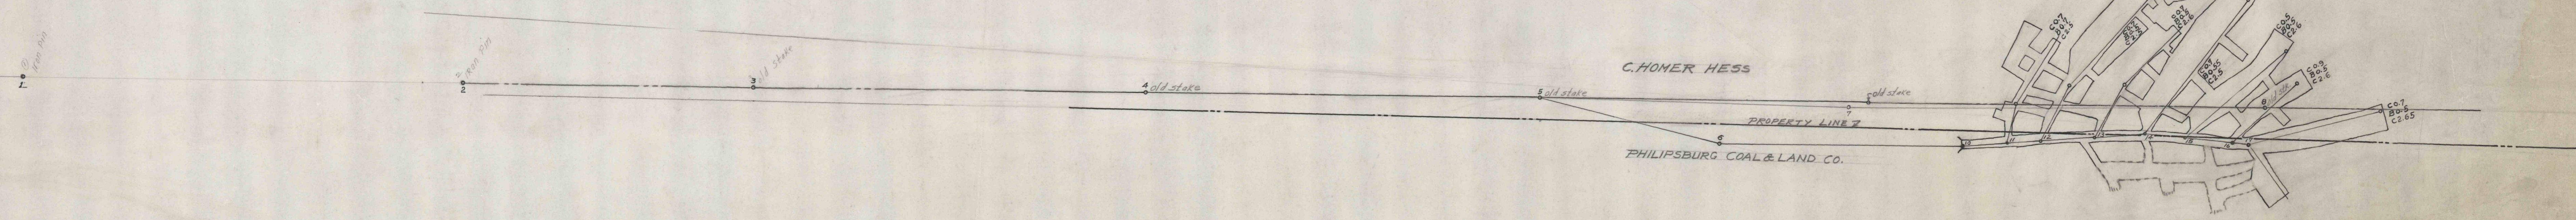

D  
 MAP OF DEPALMA MINE  
 scale 1"=50'      Oct. 27, 1943  
 Revised 11-12-43      Bernard Lucas  
                                      Thos. F. Morgan  
                                      Engineers

C.D. 203

4619

1.28  
1.30