

M
J.H. FRANCE REFRACTORIES CO.
CLAY HILL STRIPPING MEASUREMENTS

SNOWSHOE TWP., CENTRE CO., PENNA.

SCALE — **PLAN 1" = 50'**
X-SECTION — { **HOR. - 1" = 10'**
VERT. - 1" = 10'

FEBRUARY 17, 1956
 CLEARFIELD, PENNA.

YOST, BEAMFIELD & HESS
 ENGINEERS

1396 A


YARDAGE REMOVED

Sta. 4+00 to 5+83
 665,909 cu. ft.
 24,663 cu yds. - 2/14/56

Sta. 0+40 to 4+25
 1,608,590 cu. ft.
 59,577 cu yds. - 4/17/56

+ Clay Removed
 9143.9 cu. ft.
 338.7 " yds. - 4/17/56

North
 1" = 50'
 1/2" = 10'

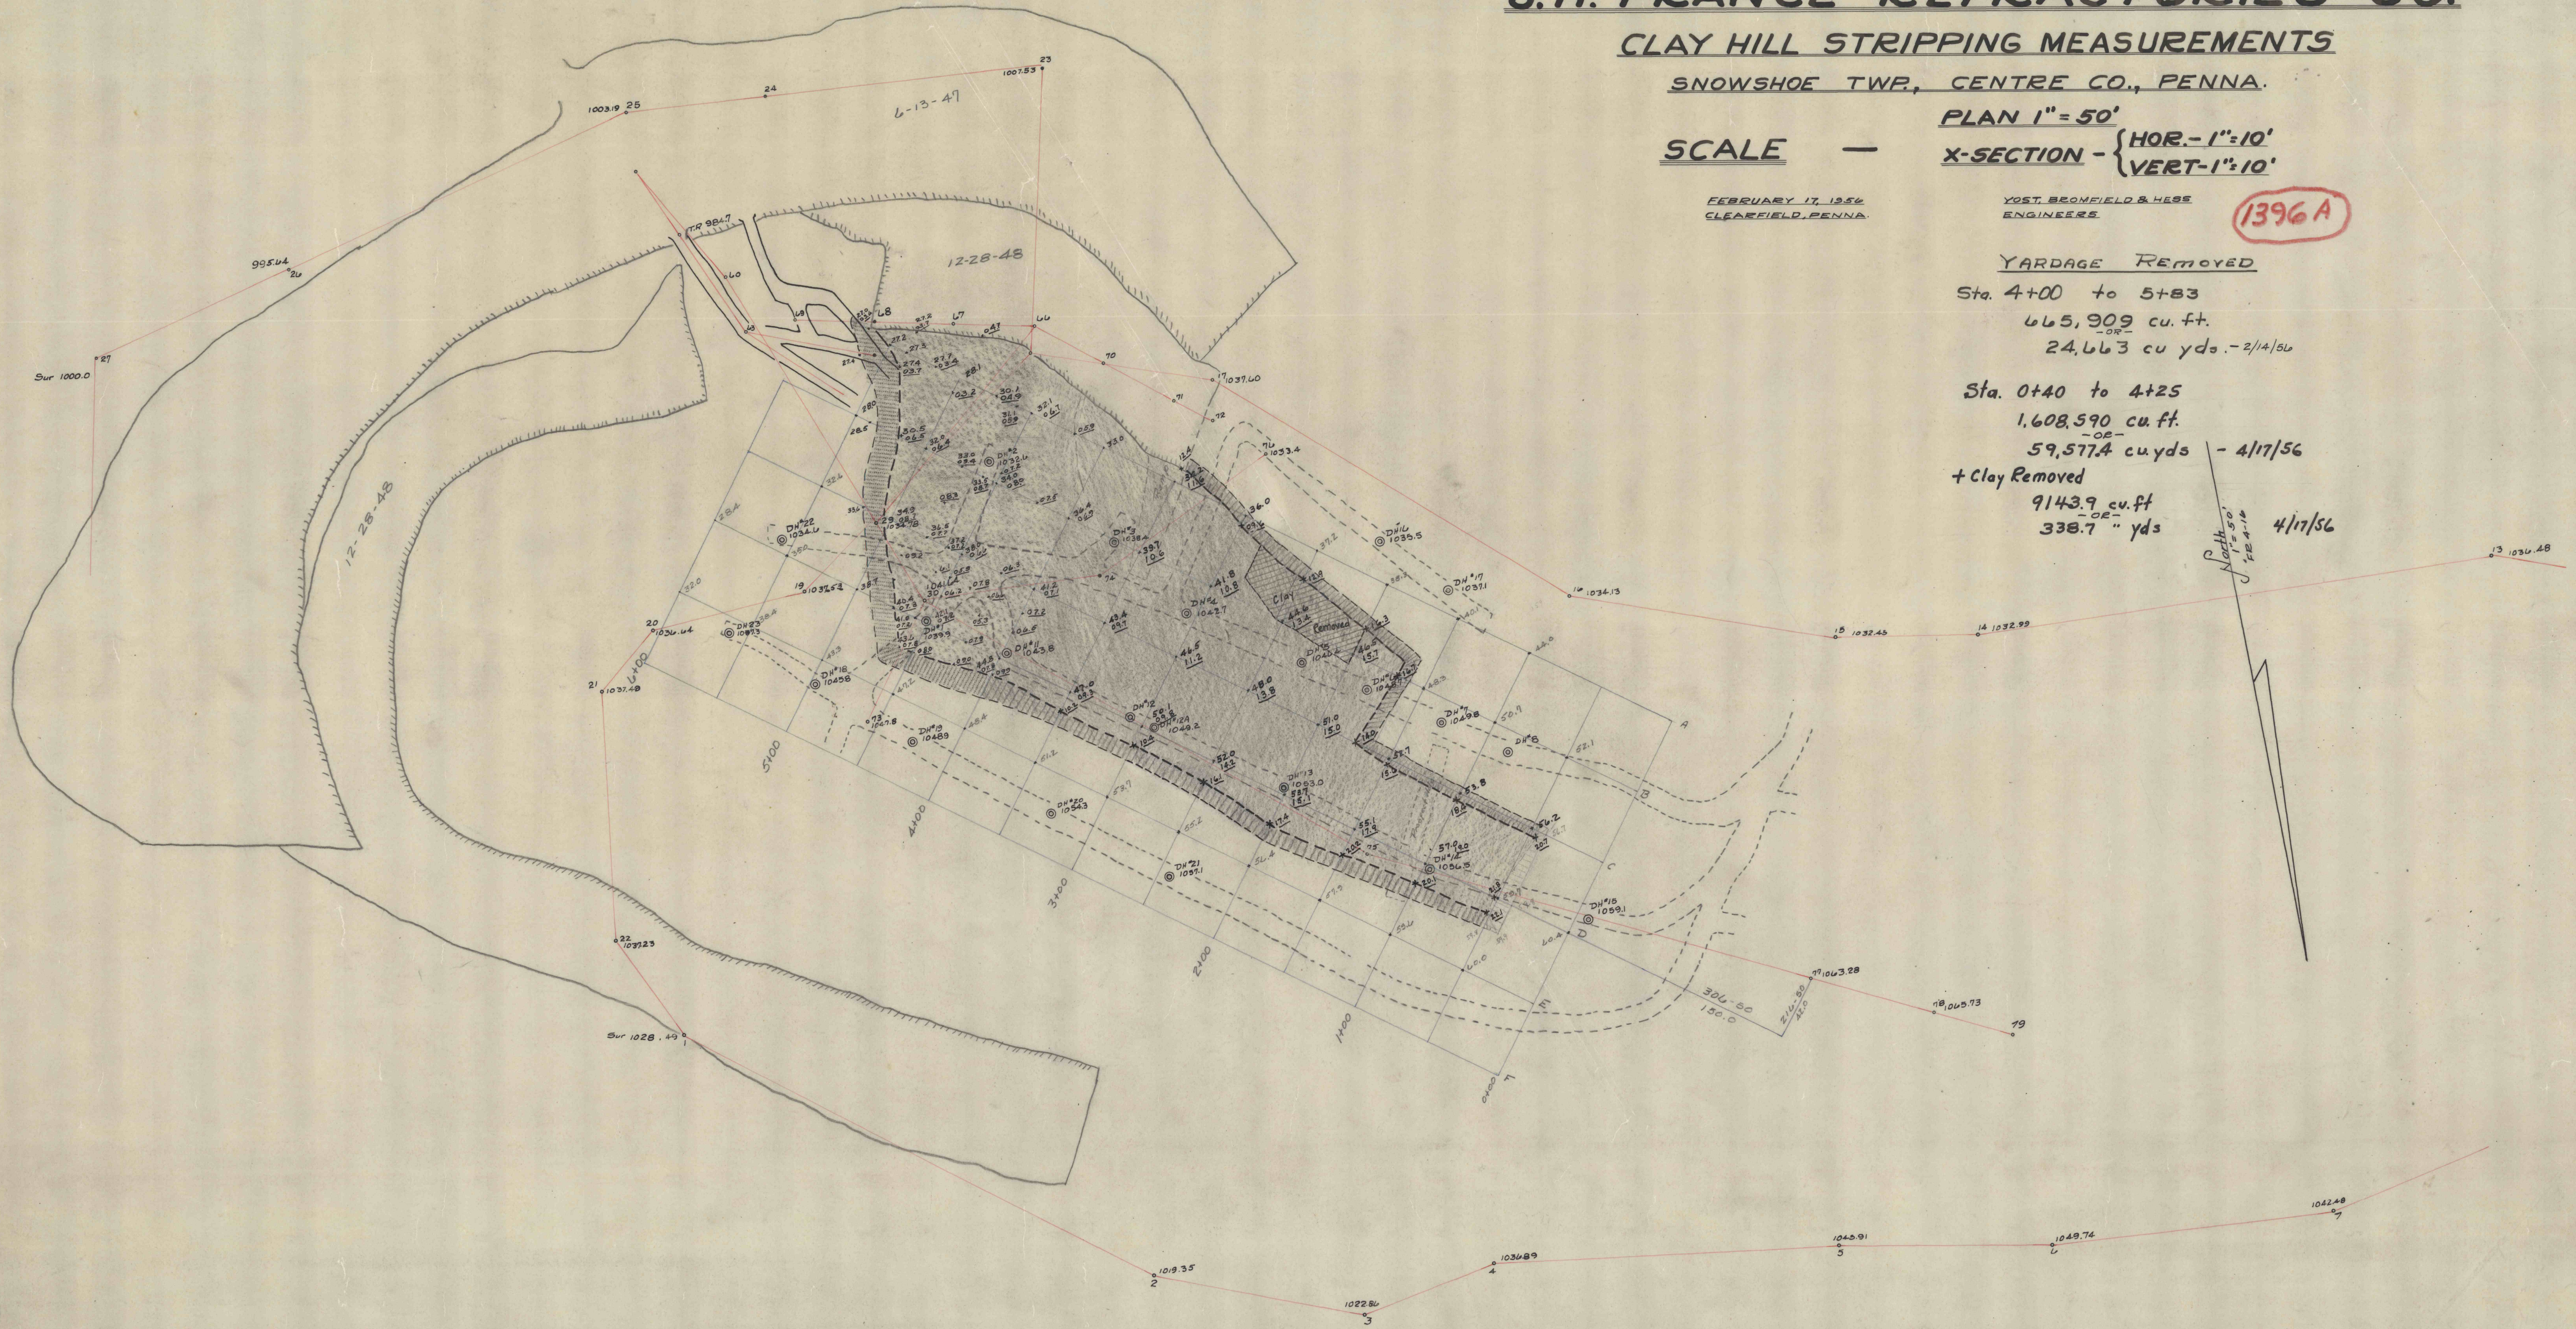

5002

5005

4981