

—MAP—

—ENCROACHMENT OF NARCO ON HARBISON-WALKER—
FROM THE DRAUCKER MINE — UNION TWP. — CLFD. CO. — PA.

REFERENCE DATA

GEO. S. GOOD FIRE BRICK CO.

CURWENSVILLE, CLEARFIELD COUNTY, PA.

ENGINEERING DEPARTMENT


ENV. No.

SHEET No.

51-2-14

SCALE 1 inch = 50 Ft.

DATE JAN. 18, 1937

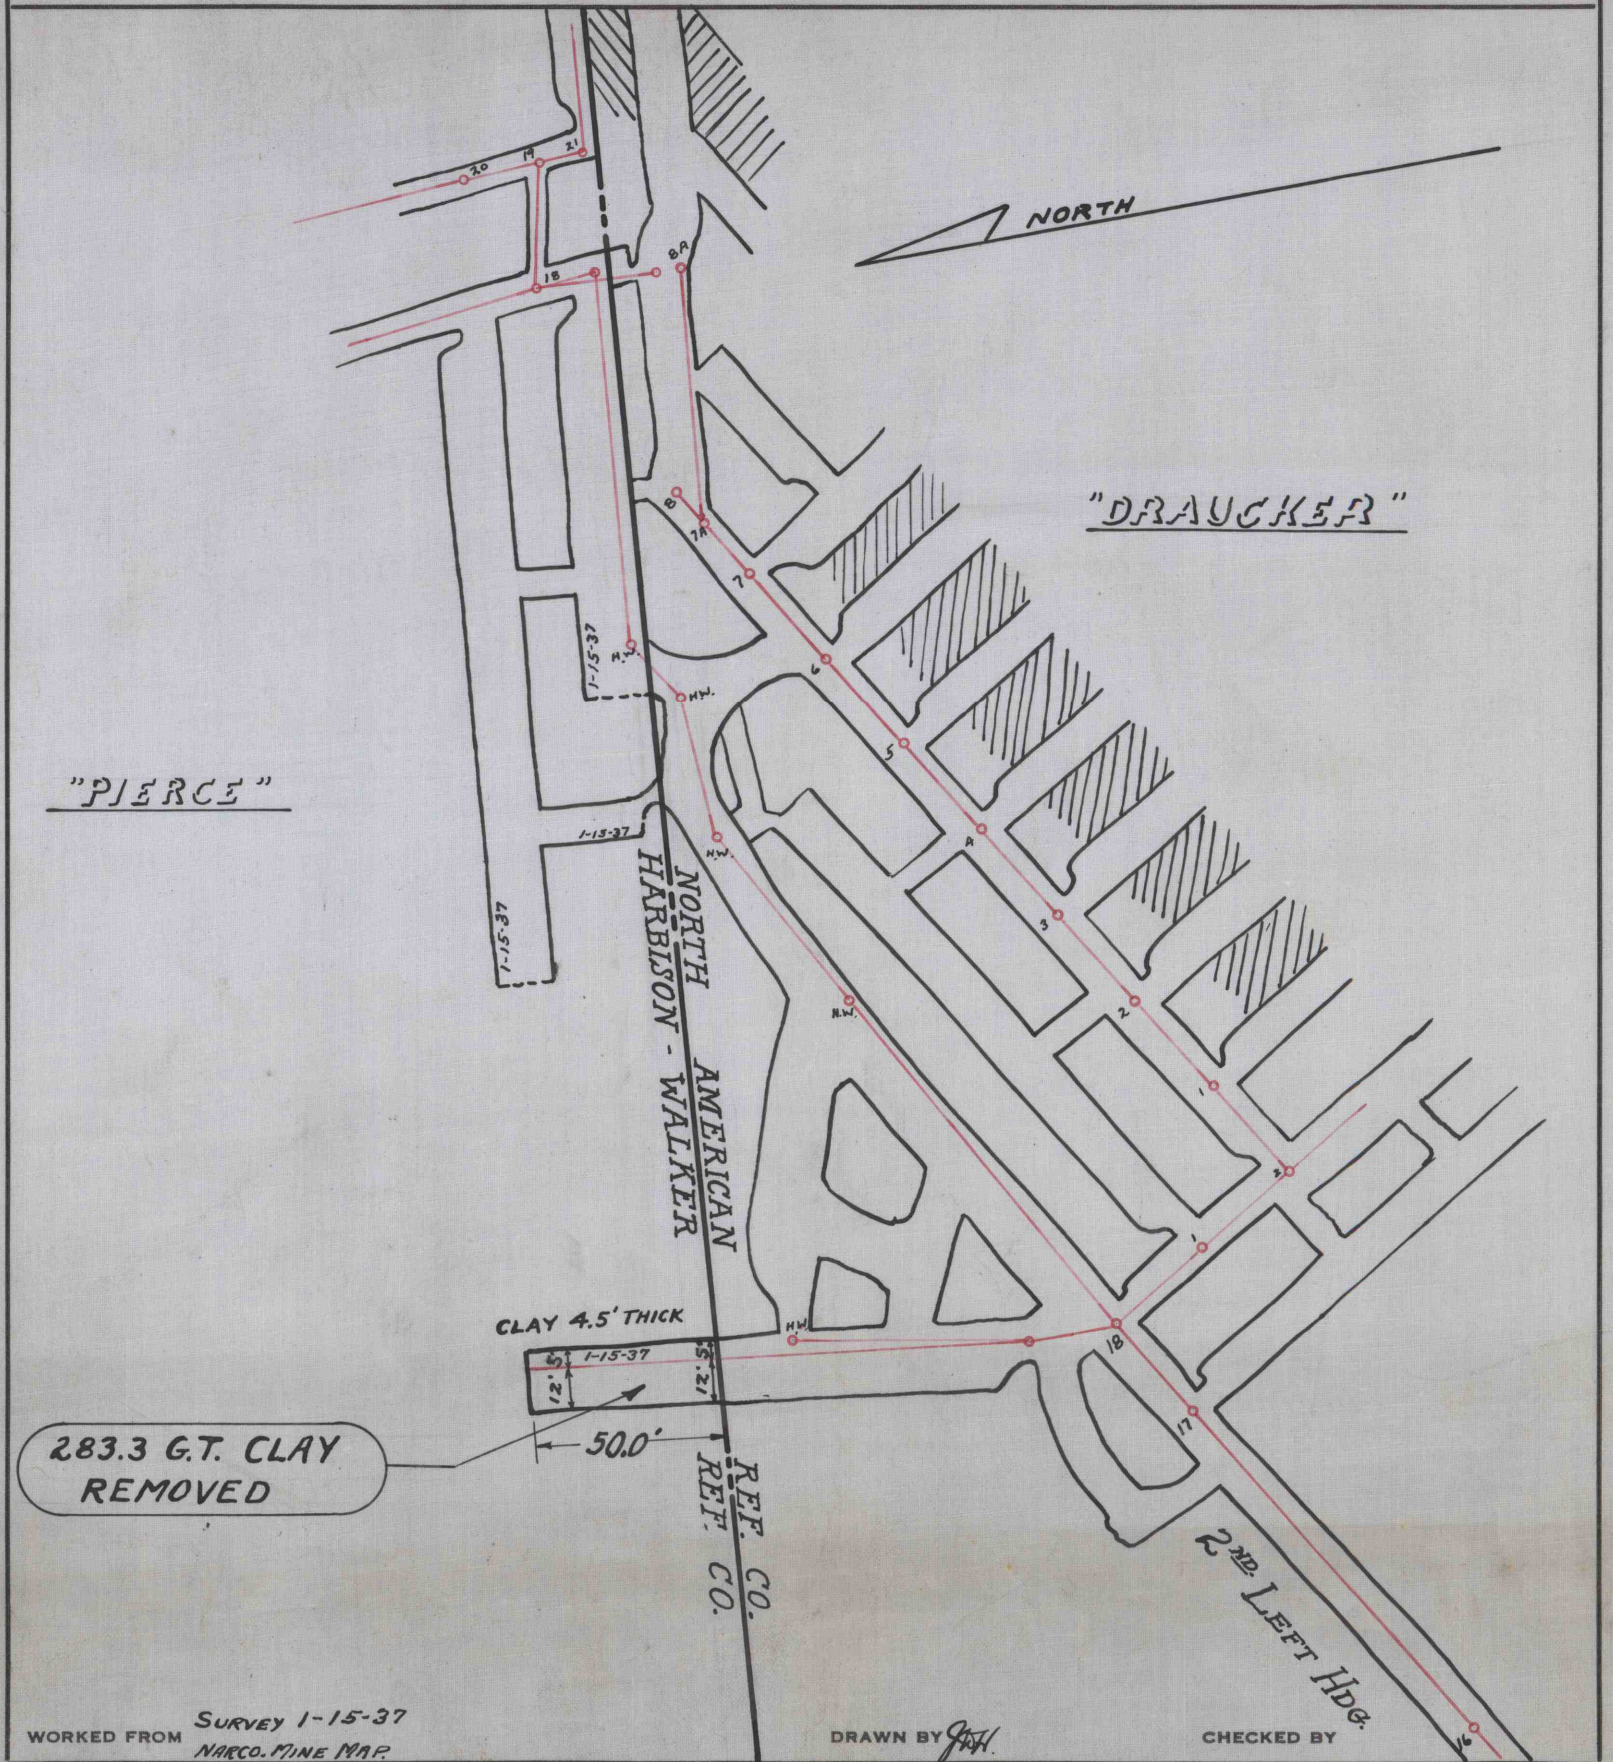

WORKED FROM SURVEY 1-15-37
NARCO. MINE MAP.

DRAWN BY [Signature]

CHECKED BY