

DDH#13
 Surf. 1129.8
 Bot.C. 1096.8
 11' Measure Faulty H.C.
 4' Bot. Core 33'
 Sil. 46.9%
 Alu. 37.25%
 Iron 2.35%

DD.H.#55
 ELEV. SURF. 1149.3
 ELEV. BOT. CLAY 1093.8
 (1929)
 3' Sandy H.C.

D.D.H.#53
 ELEV. SURF. 1136.4
 ELEV. BOT. CLAY 1095.4
 (1929)
 2' Sandy H.C.

D.D.H.#56
 ELEV. SURF. 1125.6
 ELEV. BOT. HOLE 1104.6
 (1929)
 Blank

DD.H.#54
 ELEV. SURF. 1139.8
 ELEV. BOT. CLAY 1093.8
 (1929)
 3' Faulty H.C.

DD.H.#52
 ELEV. SURF. 1150.4
 ELEV. BOT. CLAY 1093.9
 (1929)
 1'-6" Faulty H.C.

DDH#11
 SURF. 1152.1
 Bot.C. 1071.1
 4' Faulty H.C.

D.D.H.#46
 ELEV. SURF. 1157.8
 ELEV. BOT. CLAY 1087.3
 (1928)
 1' Sandy H.C.

DDH#14
 Surf. 1136.0
 Bot.C. 1105.0
 5' Faulty H.C.

D.D.H.#50
 ELEV. SURF. 1165.1
 ELEV. BOT. CLAY 1093.6
 (1929)
 1'-6" Faulty H.C.


D.D.H.#47
 ELEV. SURF. 1139.4
 ELEV. BOT. CLAY 1085.4
 (1928)
 1'-6" Sandy H.C.

D.D.H.#49
 ELEV. SURF. 1157.9
 ELEV. BOT. CLAY 1091.4
 (1928)
 1'-6" Faulty H.C.

DDH#26
 Surf. 1134.1
 Bot.C. 1082.1
 8' Faulty H.C.

D.D.H.#48
 ELEV. SURF. 1129.5
 ELEV. BOT. HOLE 1078.5
 (1928)
 Blank

DDH#27
 Surf. 1133.6
 Bot.C. 1087.6

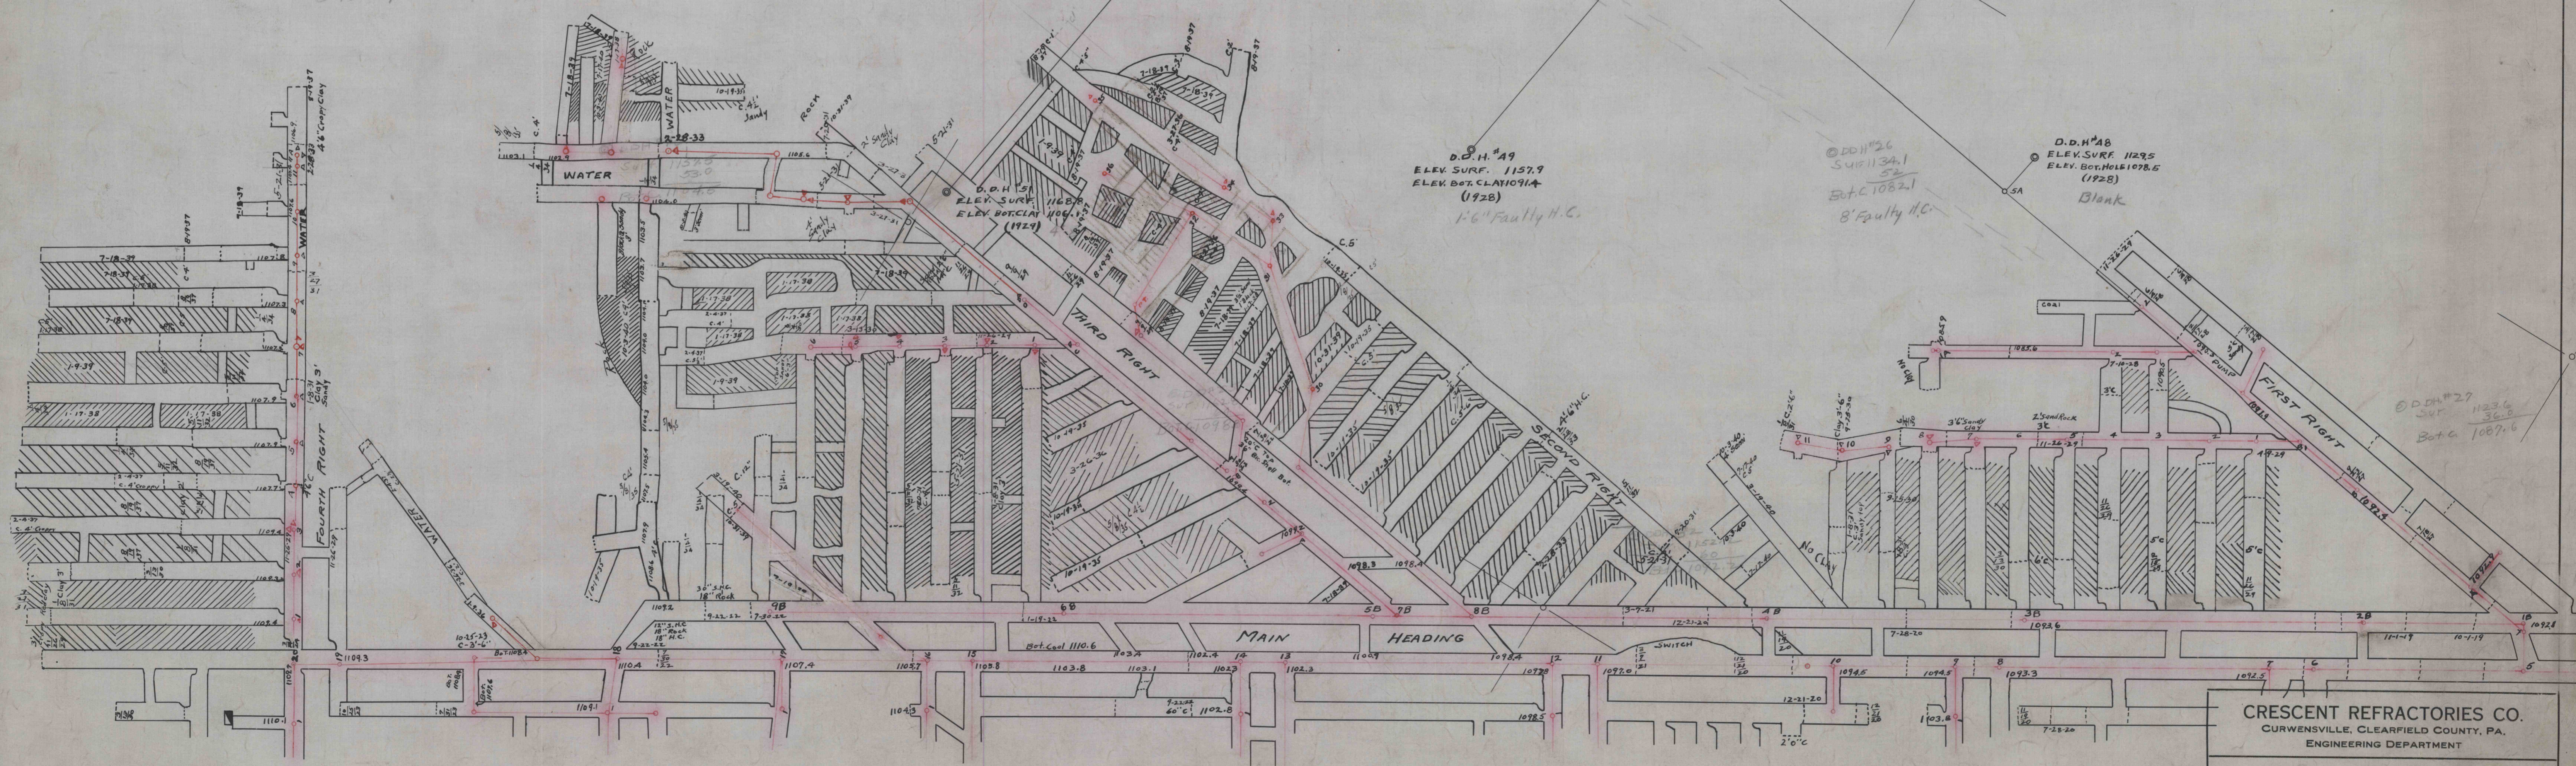

CRESCENT REFRACTORIES CO.
 CURWENSVILLE, CLEARFIELD COUNTY, PA.
 ENGINEERING DEPARTMENT

DRAUCKER MINE MAP
RIGHT OF MAIN HEADING

DRAWN R.T.L. SCALE 1"=50 Ft. 51-2-6
 CHECKED DATE Mar. 2nd 28 1011-N
 REFERENCE ORDER

SHEET No. 5.