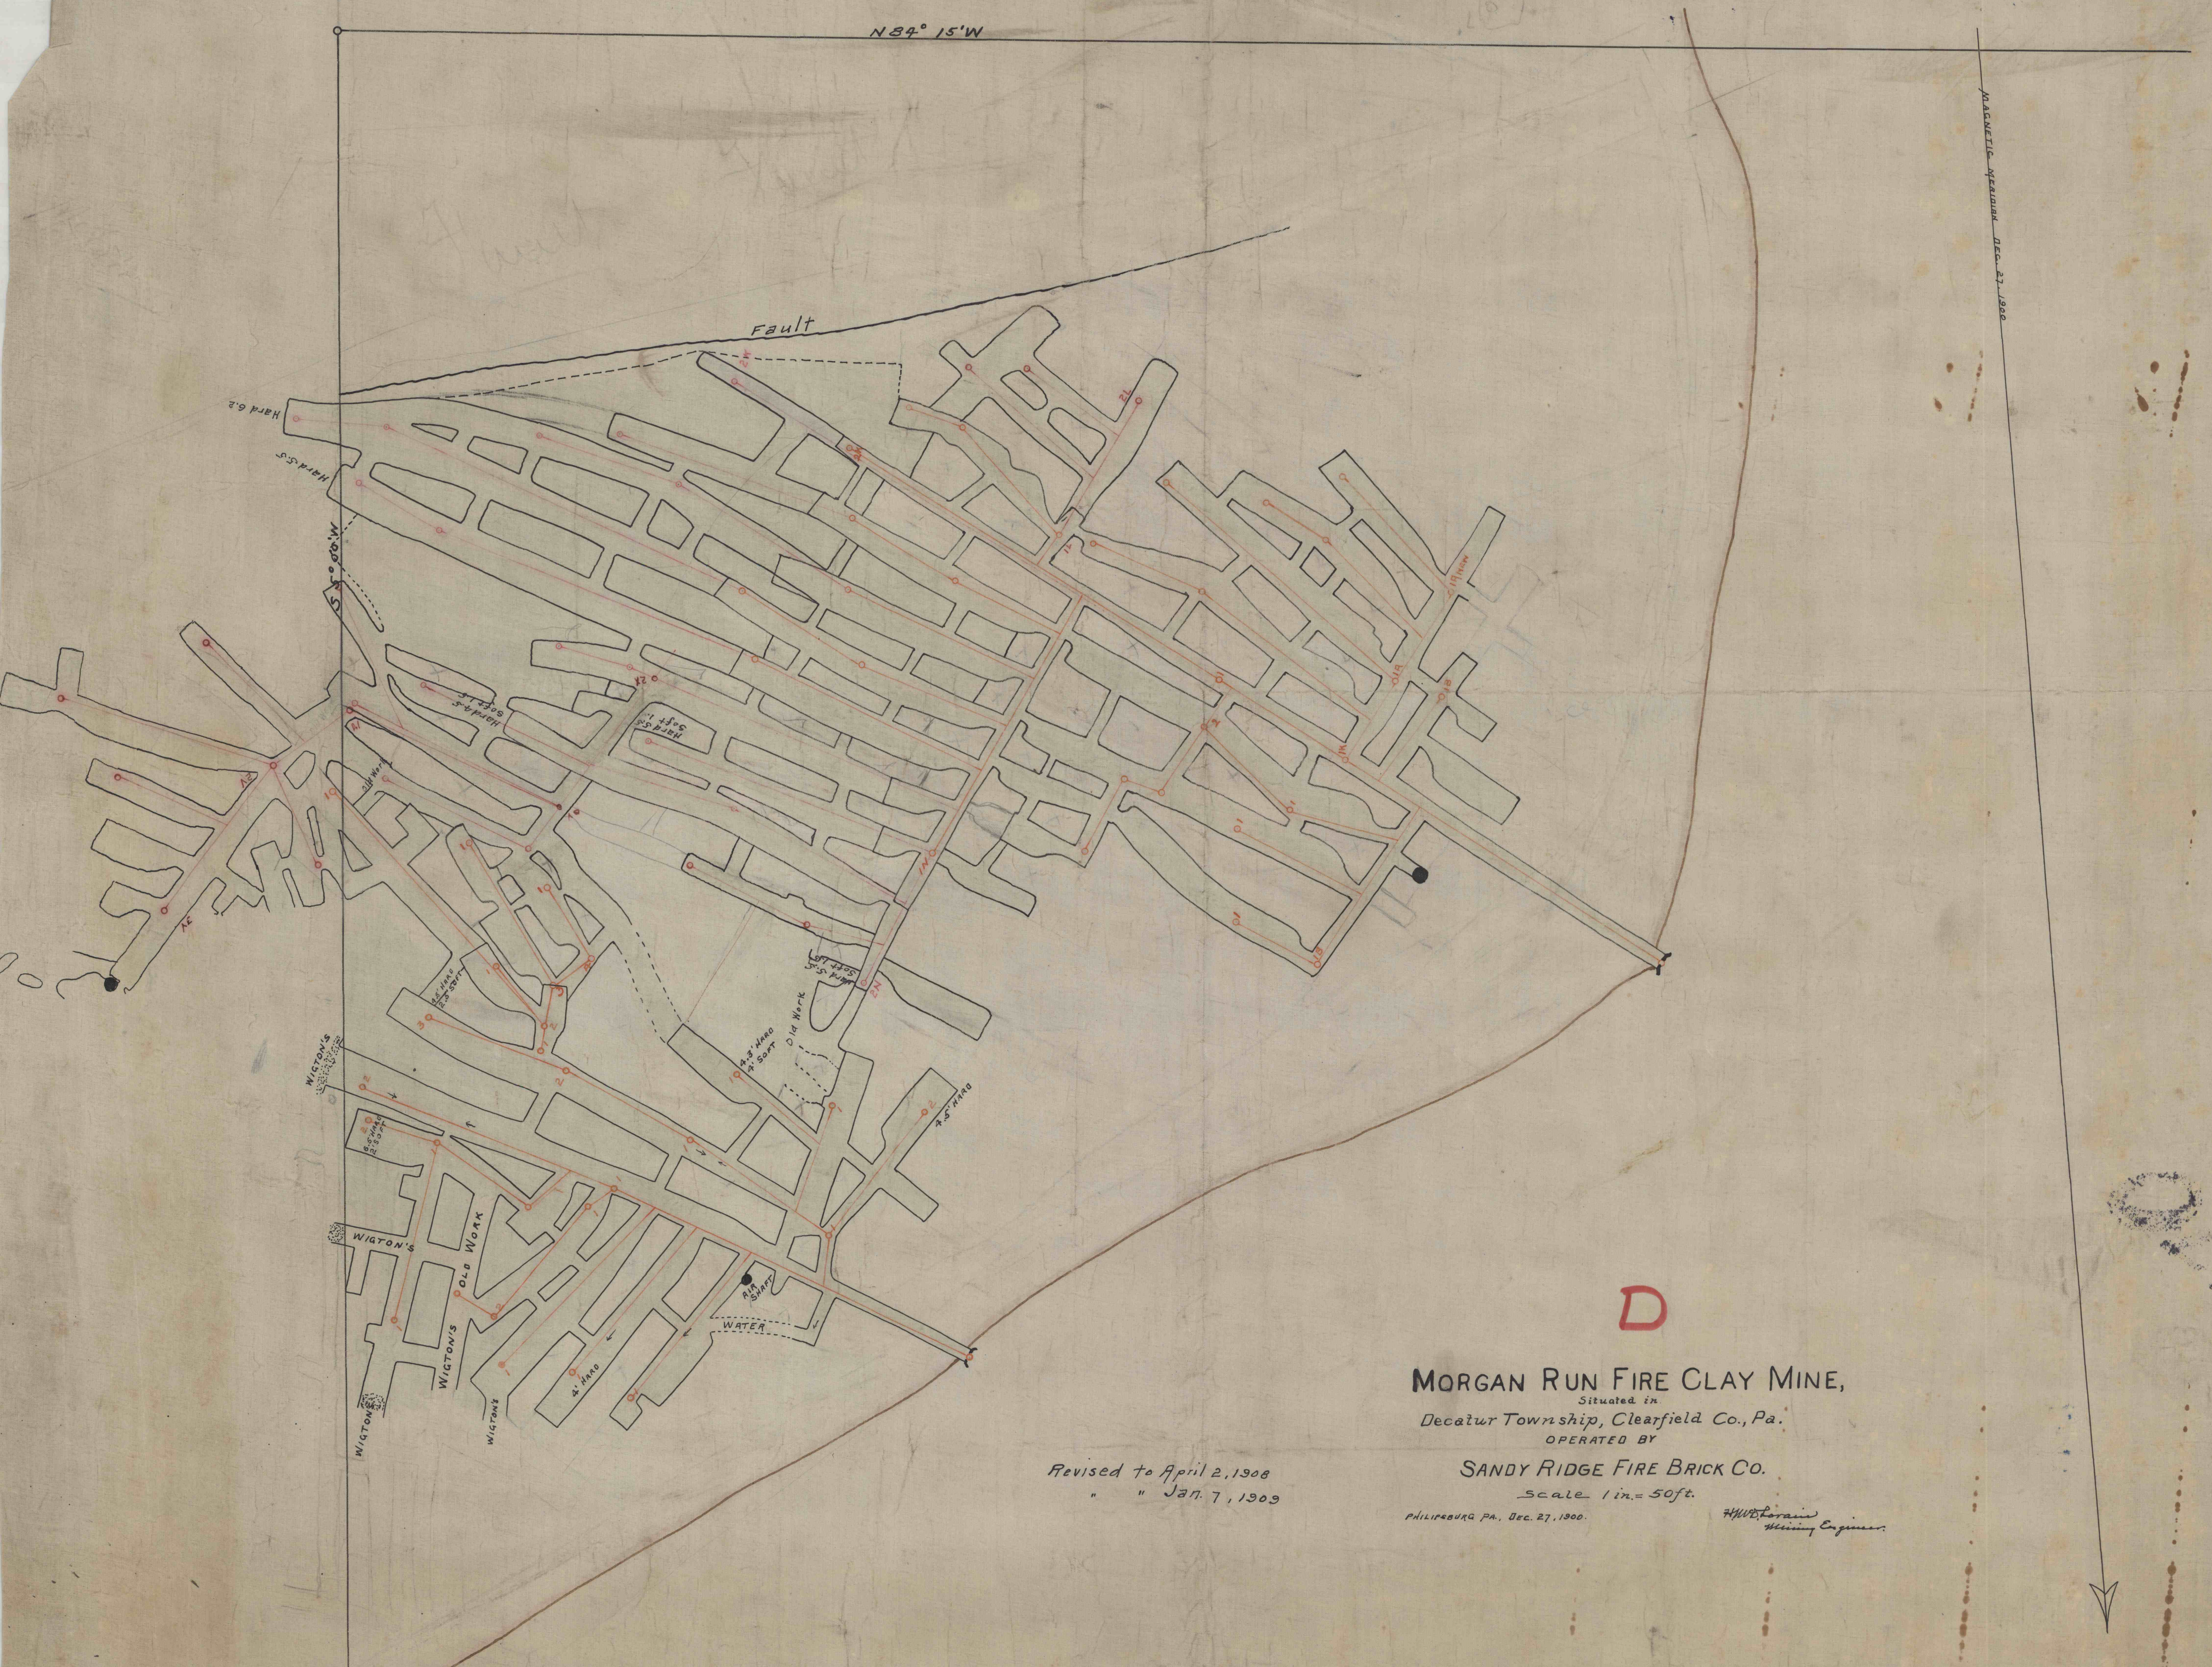

D
MORGAN RUN FIRE CLAY MINE,
Situated in
Decatur Township, Clearfield Co., Pa.
OPERATED BY
SANDY RIDGE FIRE BRICK CO.
Scale 1 in.= 50ft.
PHILIPSBURG PA., DEC. 27, 1900.
H.W.D. Loraine
Mining Engineer.
Revised to April 2, 1908
" " Jan. 7, 1909
N 84° 15' W
MAGNETIC MERIDIAN DEC. 27, 1900
Fault
Hard 6.2
Hard 5.5
Hard 4.5 Soft 1.6
Hard 5.5 Soft 1.
Old Work
4.3' HARD 4' SOFT
4.5' HARD
4.8' HARD 2.5' SOFT
6.5' HARD 2' SOFT
WIGTON'S
WIGTON'S OLD WORK
WIGTON'S
WIGTON'S
WIGTON'S
4' HARD
AIR SHAFT
WATER
5170
H-5
D