



-NORTH AMERICAN REFRACTORIES CO.- (CLAY LEASE)

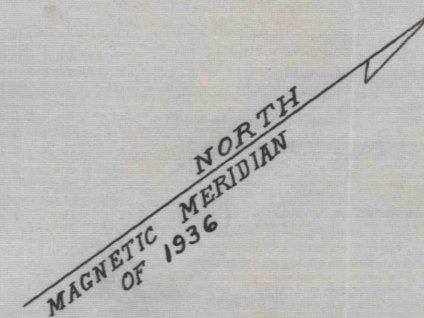

3RD LINE OF 50 ACRE TRACT
AGREEMENT DATED OCT. 31ST 1916

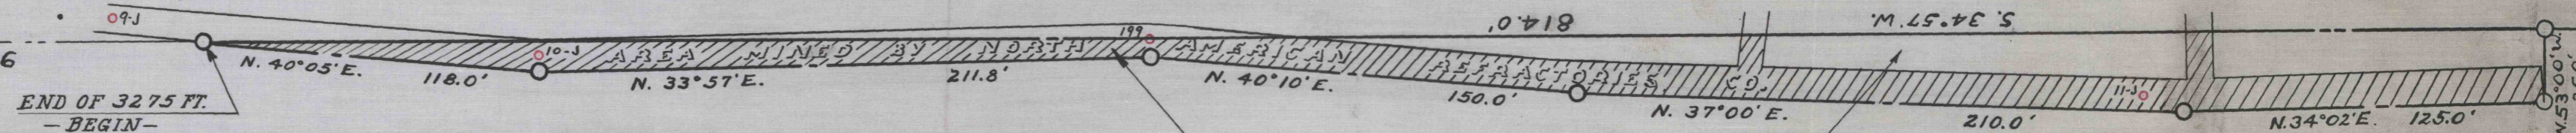

TOTAL AREA 0.285 ACRE

-BIG SAVAGE FIRE BRICK CO.- (CLAY LEASE)

-SCALE - 1" = 50 Ft. -
JAN. 12, 1937.

NOTE -

THIS MAP WAS MADE FROM ACTUAL SURVEYS.
BY F. ERNEST BRACKETT, ENG.
JOHN D. HAINES, JR.