



000

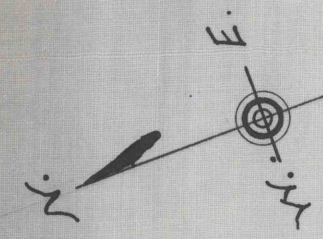

LINE OF FAULT
 LINE OF FAULT

PILLARS DRAWN & CAVED

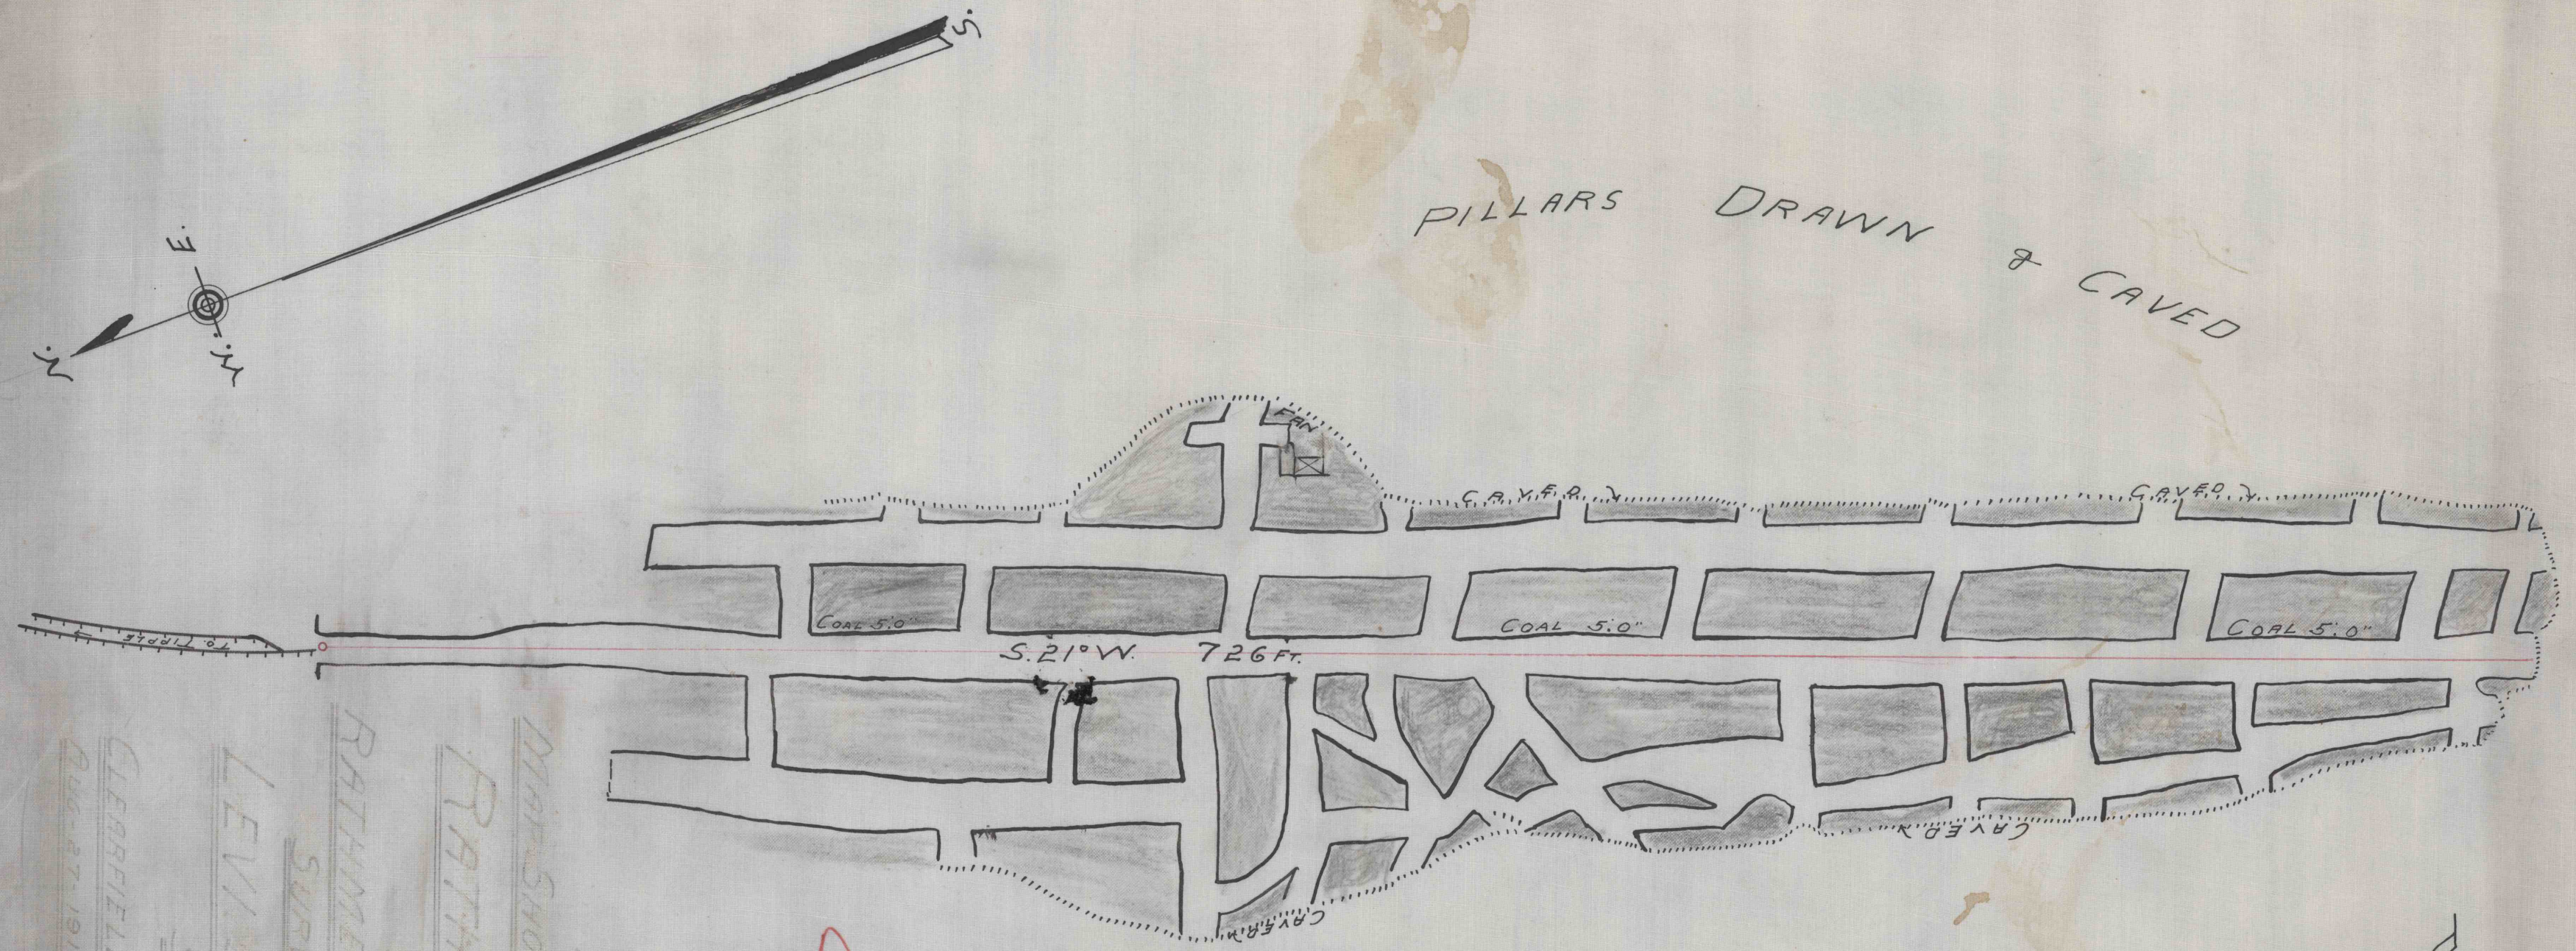

D
 MAP SHOWING SURVEY OF
RATHMEL-J-9-MINE
 NEAR
RATHMEL JEFFERSON CO. PA.
 SURVEYED FOR
LEVI SCHUCKERS ET AL.
 SCALE 1"=50'
 CLEARFIELD PA. OFFICE E.W. HESS
 AUG. 27-1913 ENGINEER

PILLARS
 DRAWN & CAVED

452A

MAP SHOWING SURVEY OF
 RATHMEL-J-9-MINE
 NEAR
 RATHMEL JEFFERSON CO. PA.
 SURVEYED FOR
 LEVI SCHUCKERS ET AL.
 SCALE 1"=50'
 CLEARFIELD PA. OFFICE E.W. HESS
 AUG. 27-1913 ENGINEER

688