


Sold - Not owned by J.C. & C.

APP location
Fire Plug

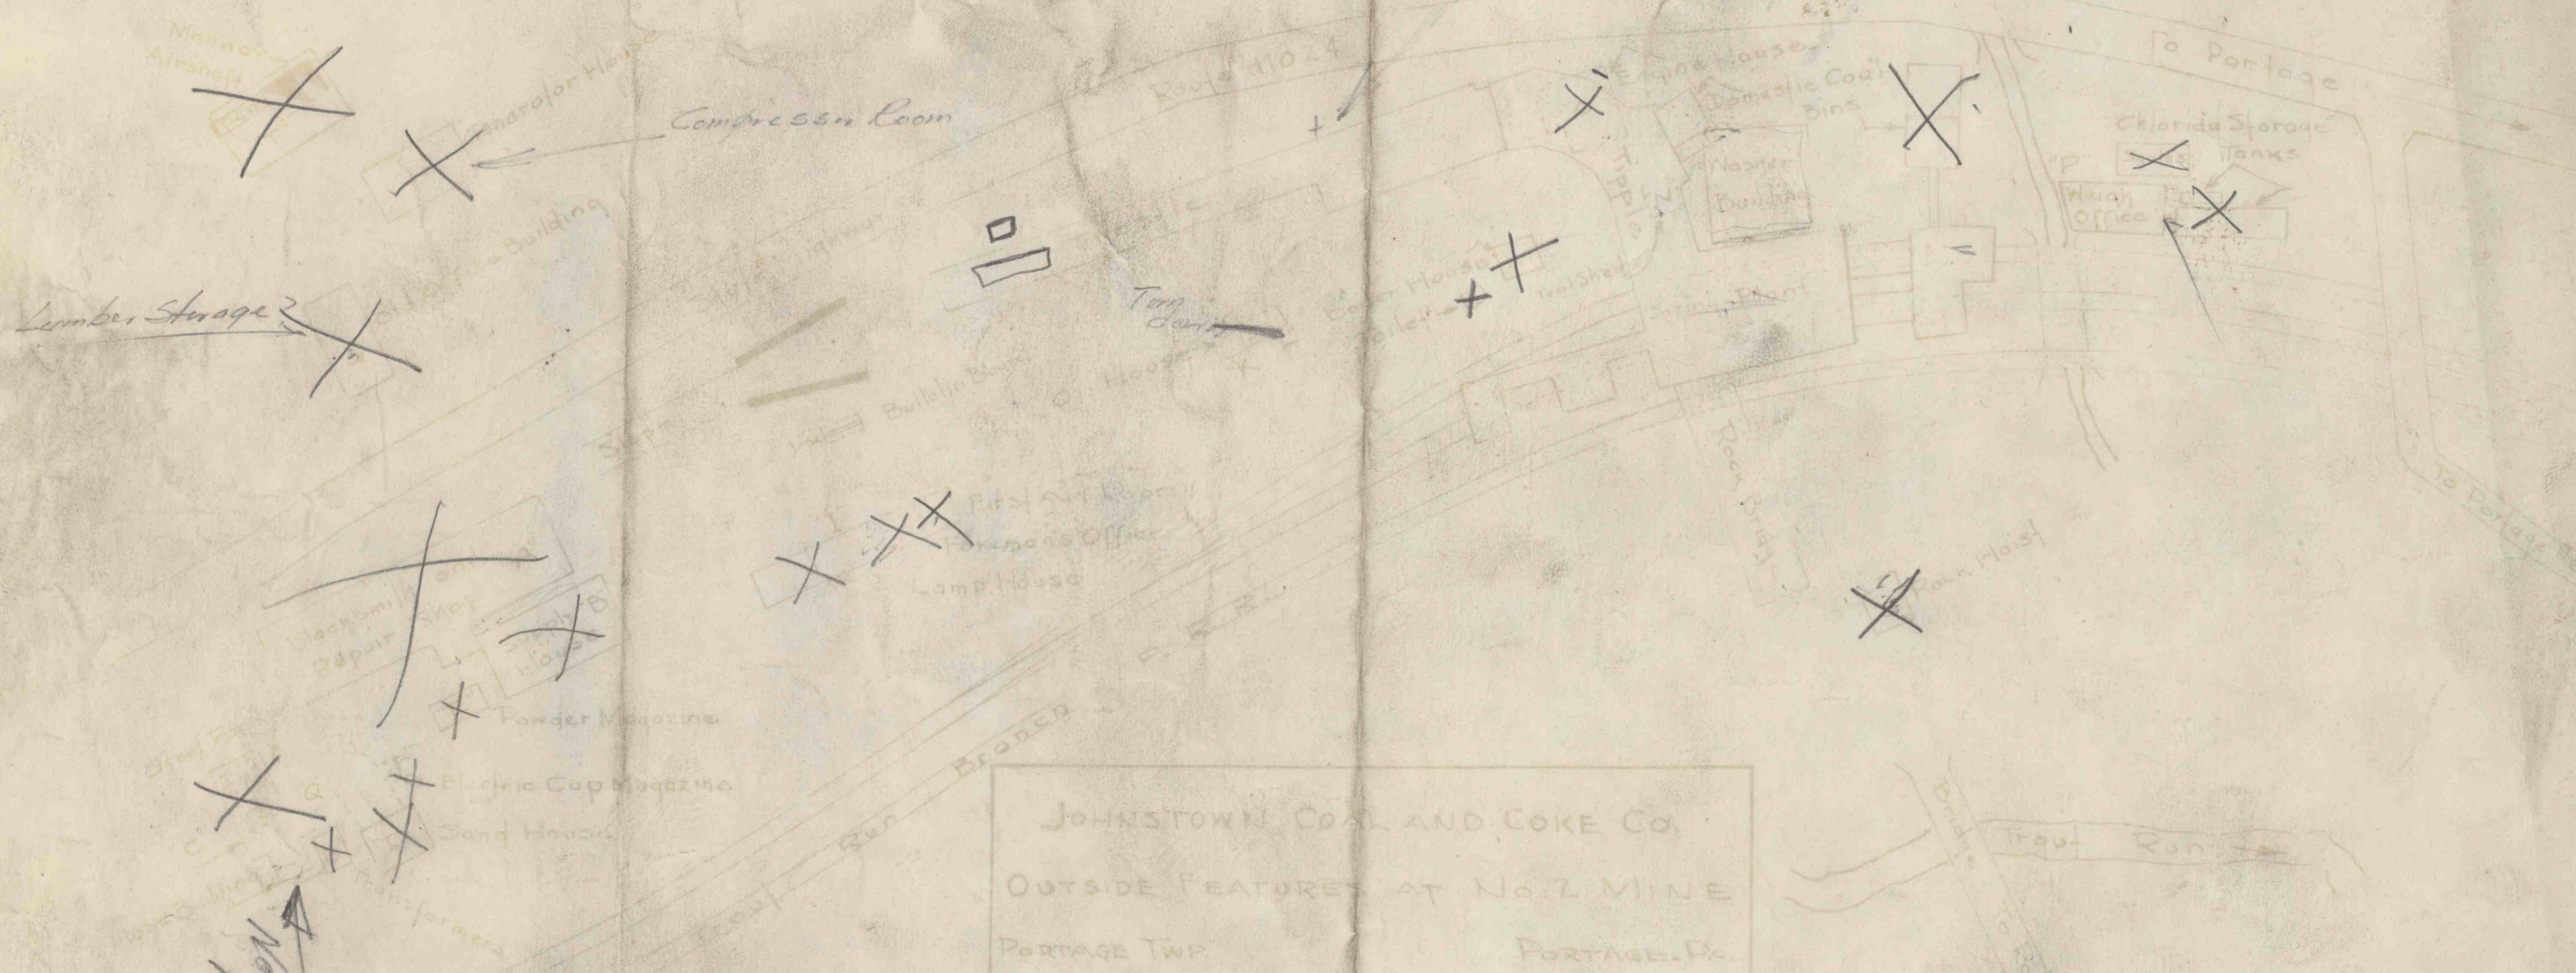

No hose here

Total Employees 260
Daily tonnage 1461 tpd
3 shifts loading and dumping

JOHNSTOWN COAL AND COKE CO.
 OUTSIDE FEATURES AT NO. 2 MINE
 PORTAGE TWP. PORTAGE, Pa.
 SCALE 1" = 50'
 MAY 1946
 Andrew S. Crichton
 Mining Engineer
 Johnstown, Pa.