


275

GENERAL REFRATORIES CO.

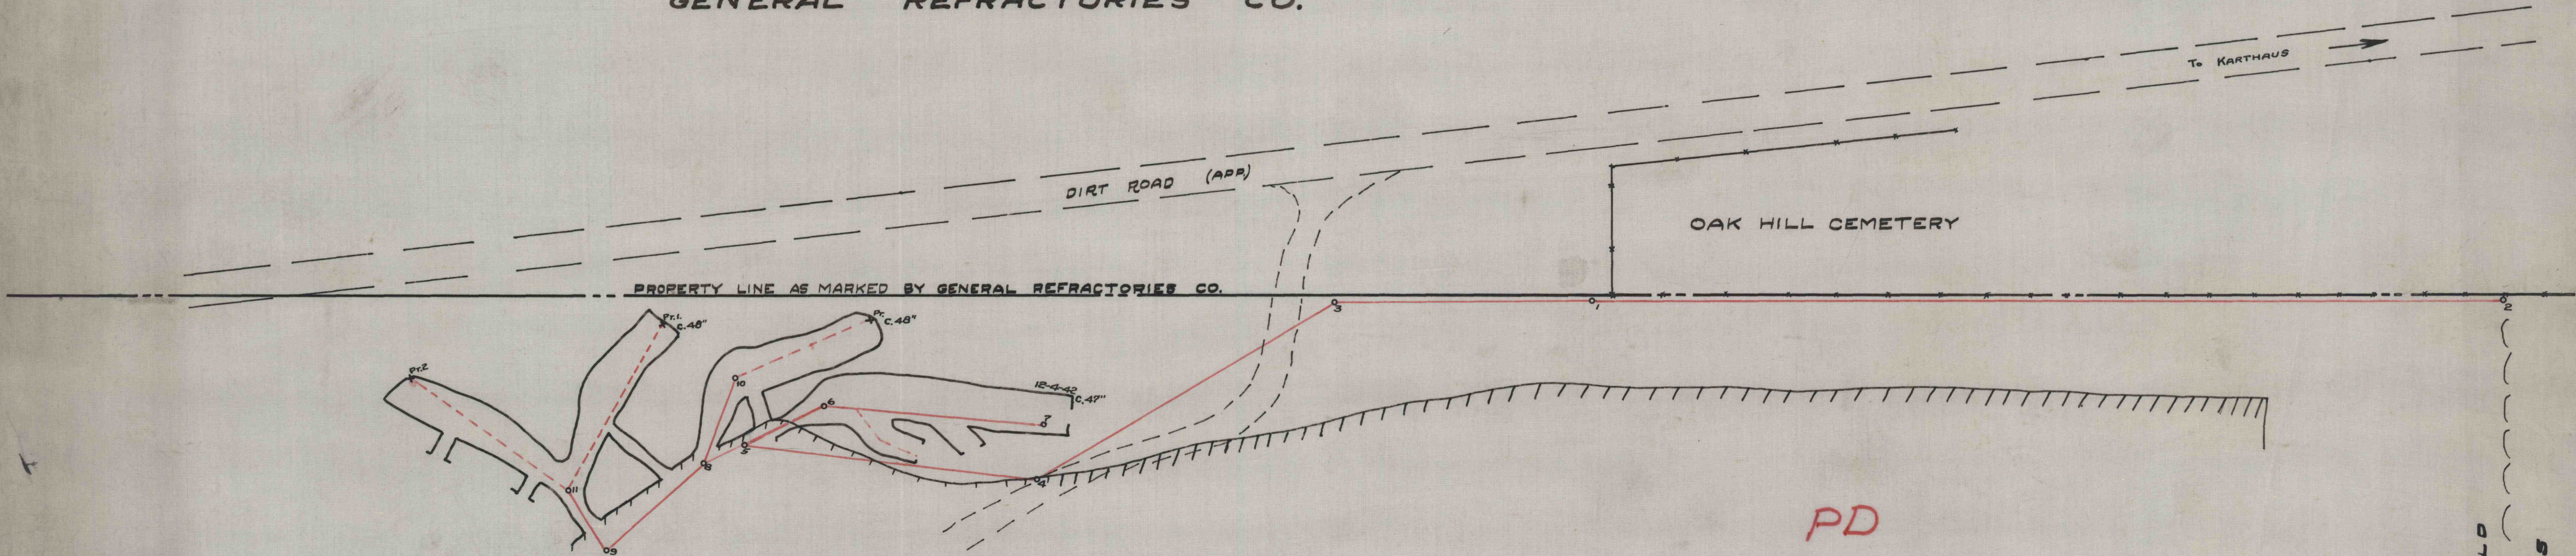


L. M. IMPSON ESTATE

PD

MAP SHOWING THE  
**PRODUCERS ECONOMY COAL CO.'S**  
 STRIPPING AND MINES  
 IN PART ~ NEAR  
**KARTHAUS, CLEARFIELD CO, PENNA.**  
 BY  
 WM. W. YOST, R.S. 5173      DECEMBER 4, 1942  
 SCALE ~ 1" = 50 FT.

382

OLD FIELD WOODS

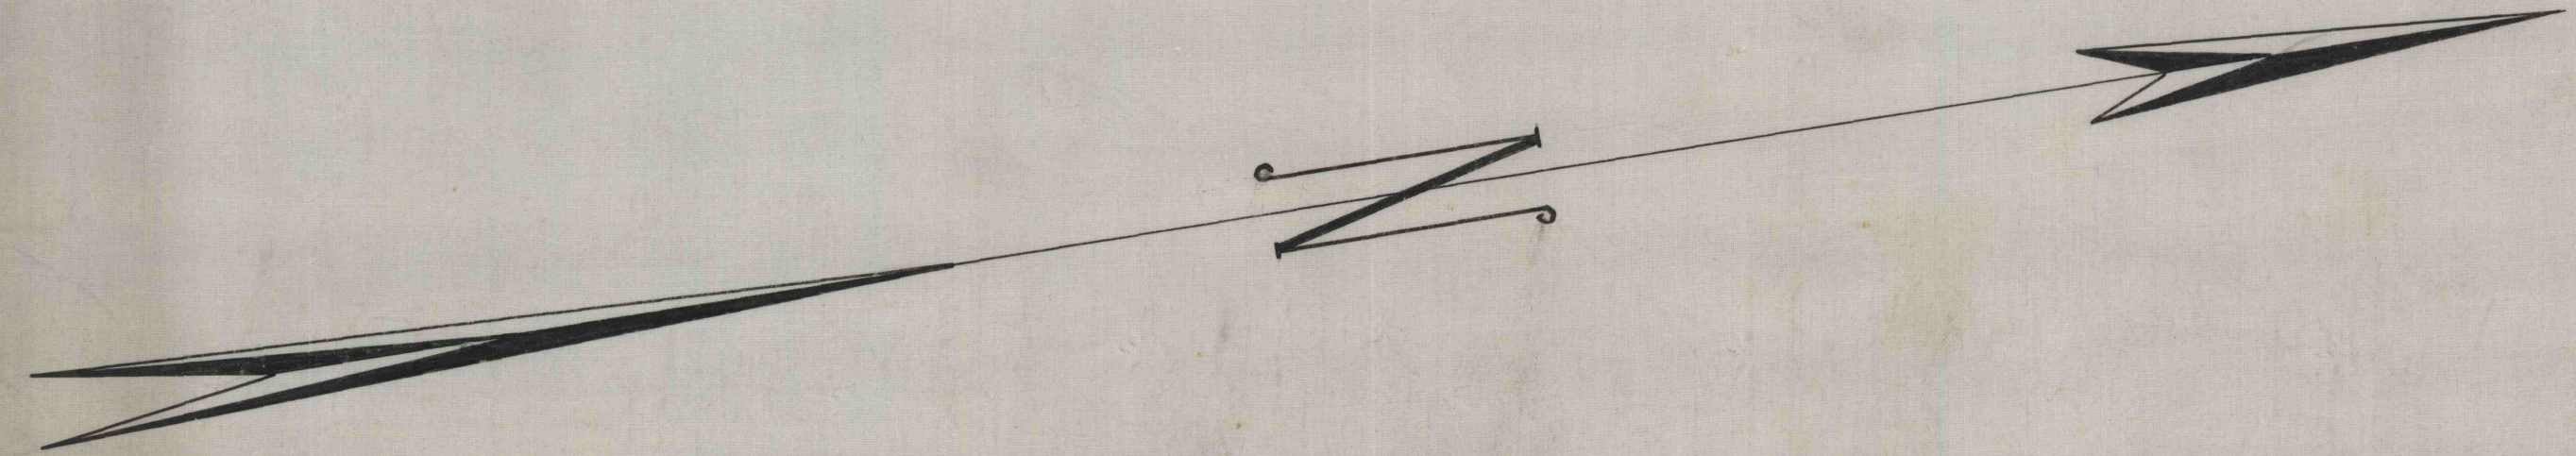

745