


 MAP OF NEW MINE
 FARBER MO
 SCALE 1" = 50'
 DATE 11/19/30

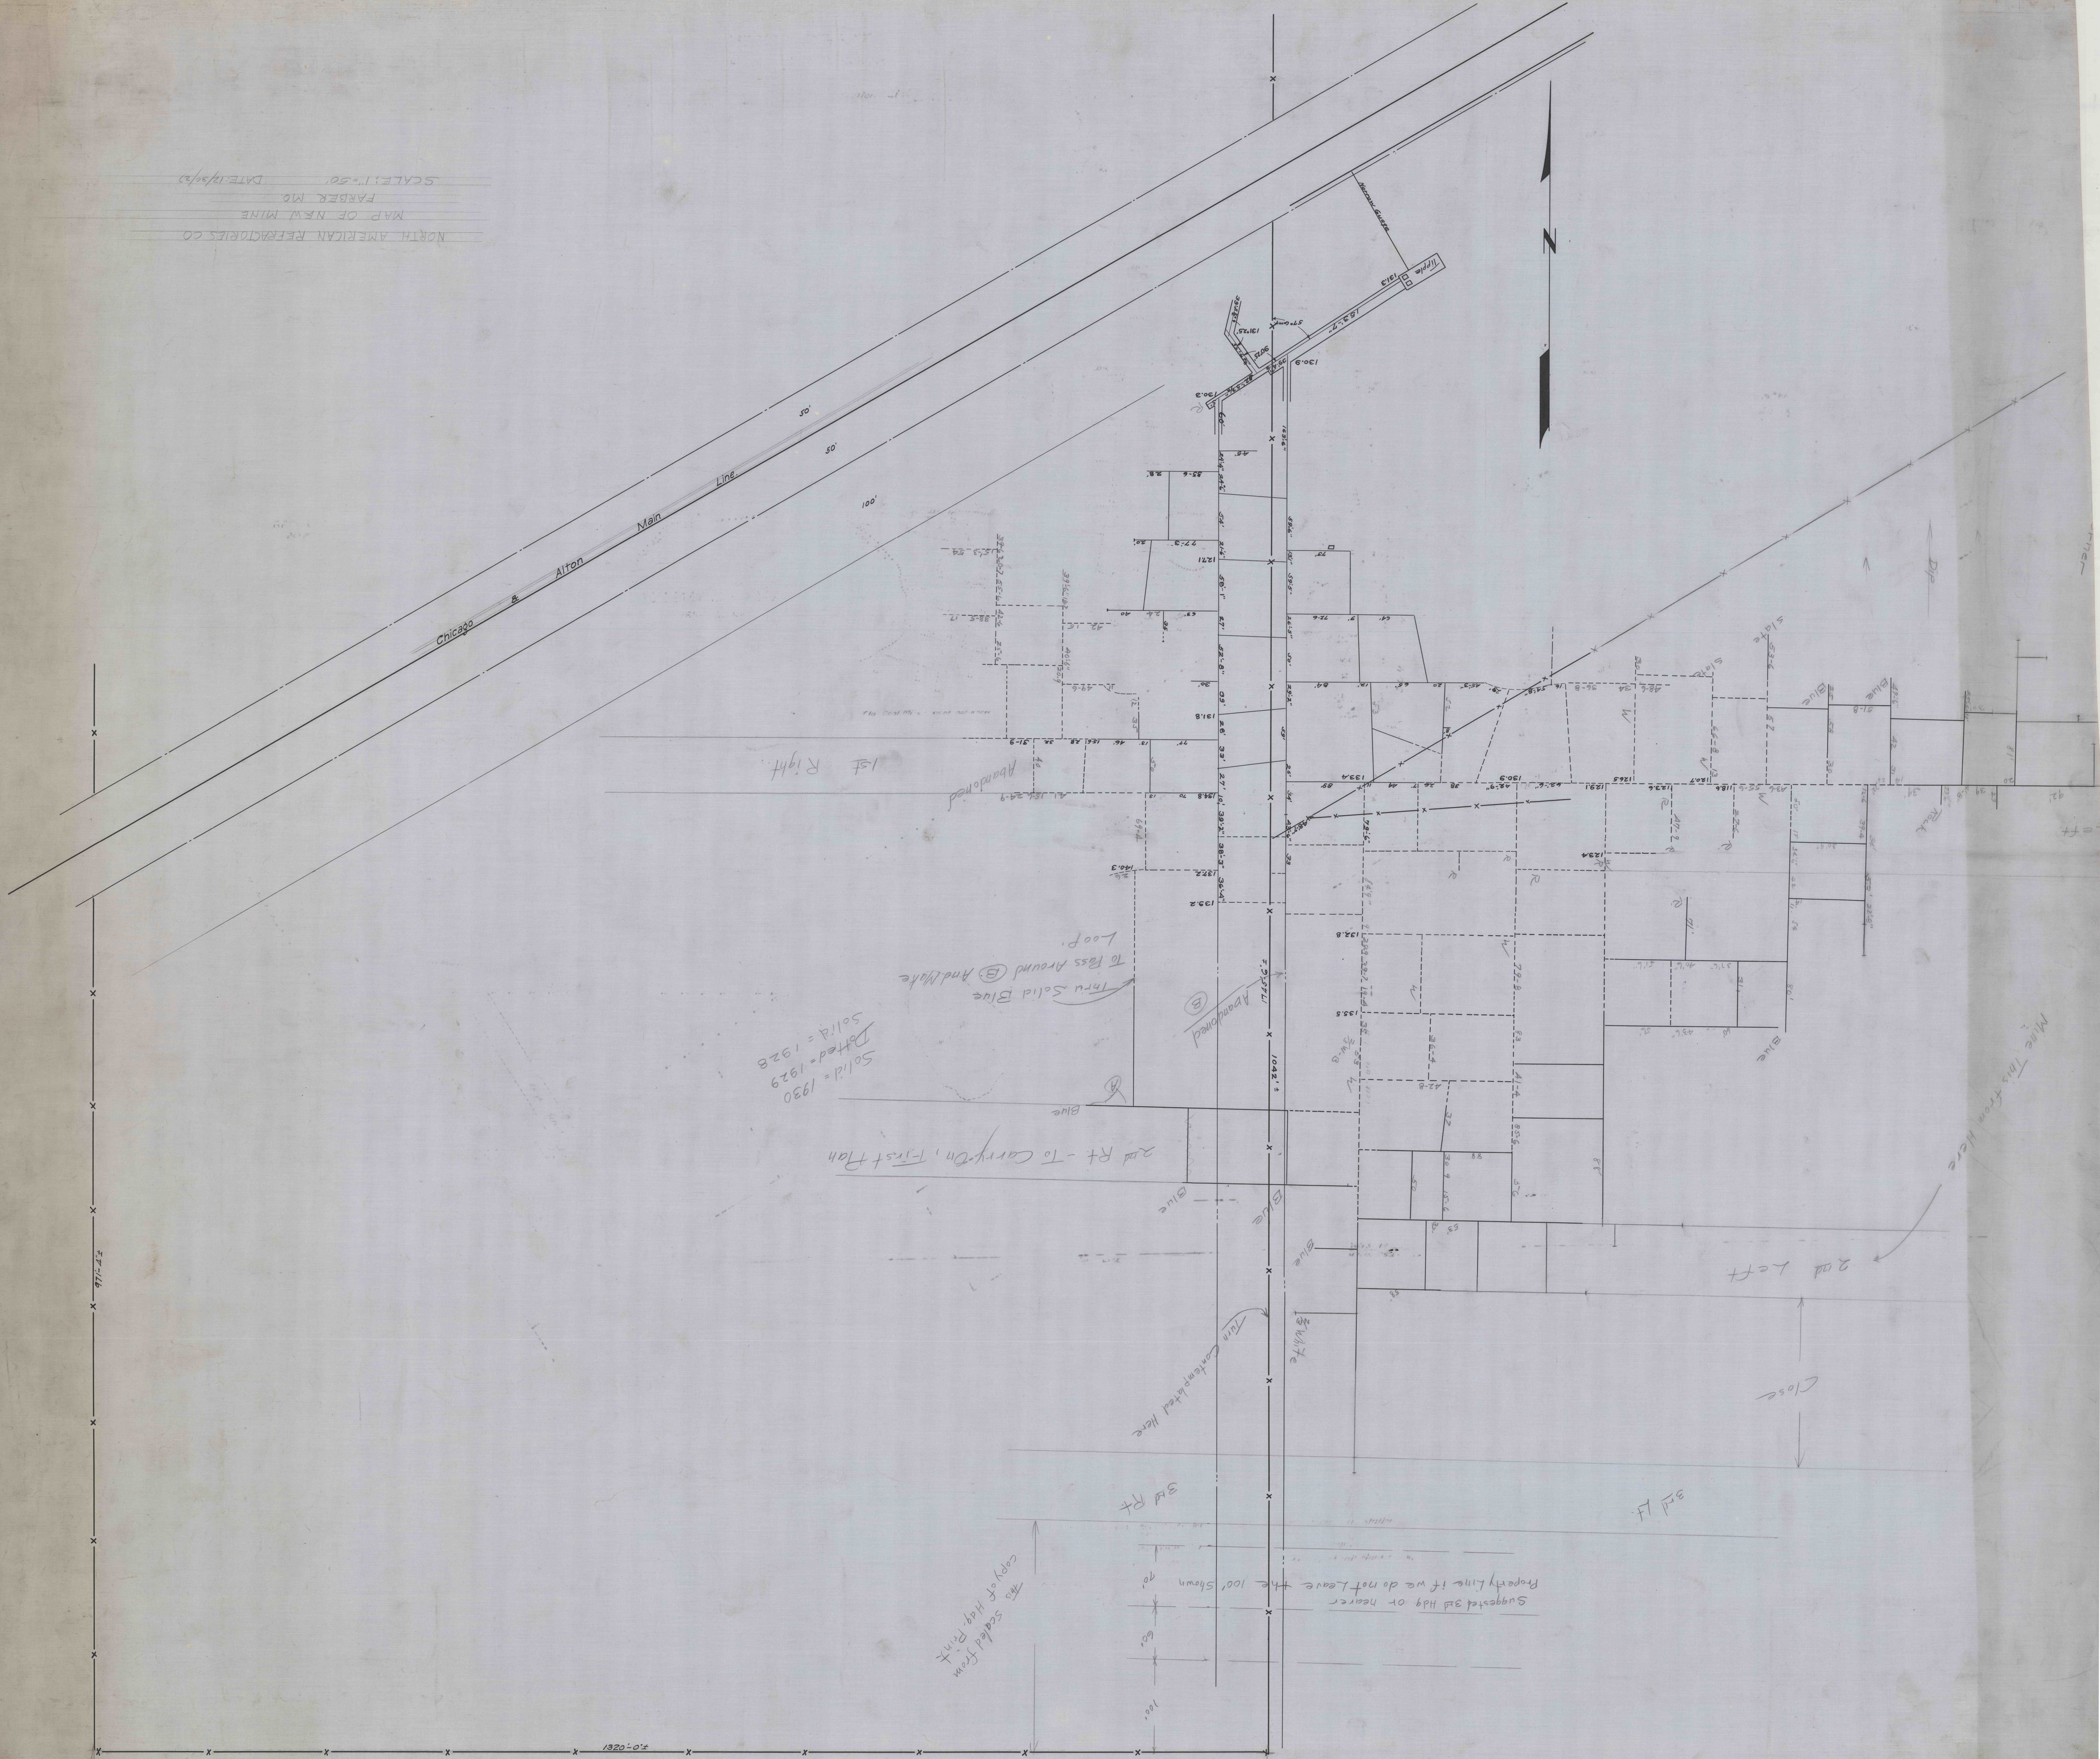

Solid = 1930
 Dotted = 1929
 Solid = 1928

From Solid Blue
 To Pass Around (B) And Make
 Loop.

2nd RT - To Carry On, First Flah

2nd Left

Close

3rd Fl

3rd RT

Suggested 3rd Hdq or nearer
 Property line if we do not leave the 100' shown
 100'
 60'
 90'
 This scaled from
 copy of Map from

Mile this from here

has this map

7-11b

1920-04