
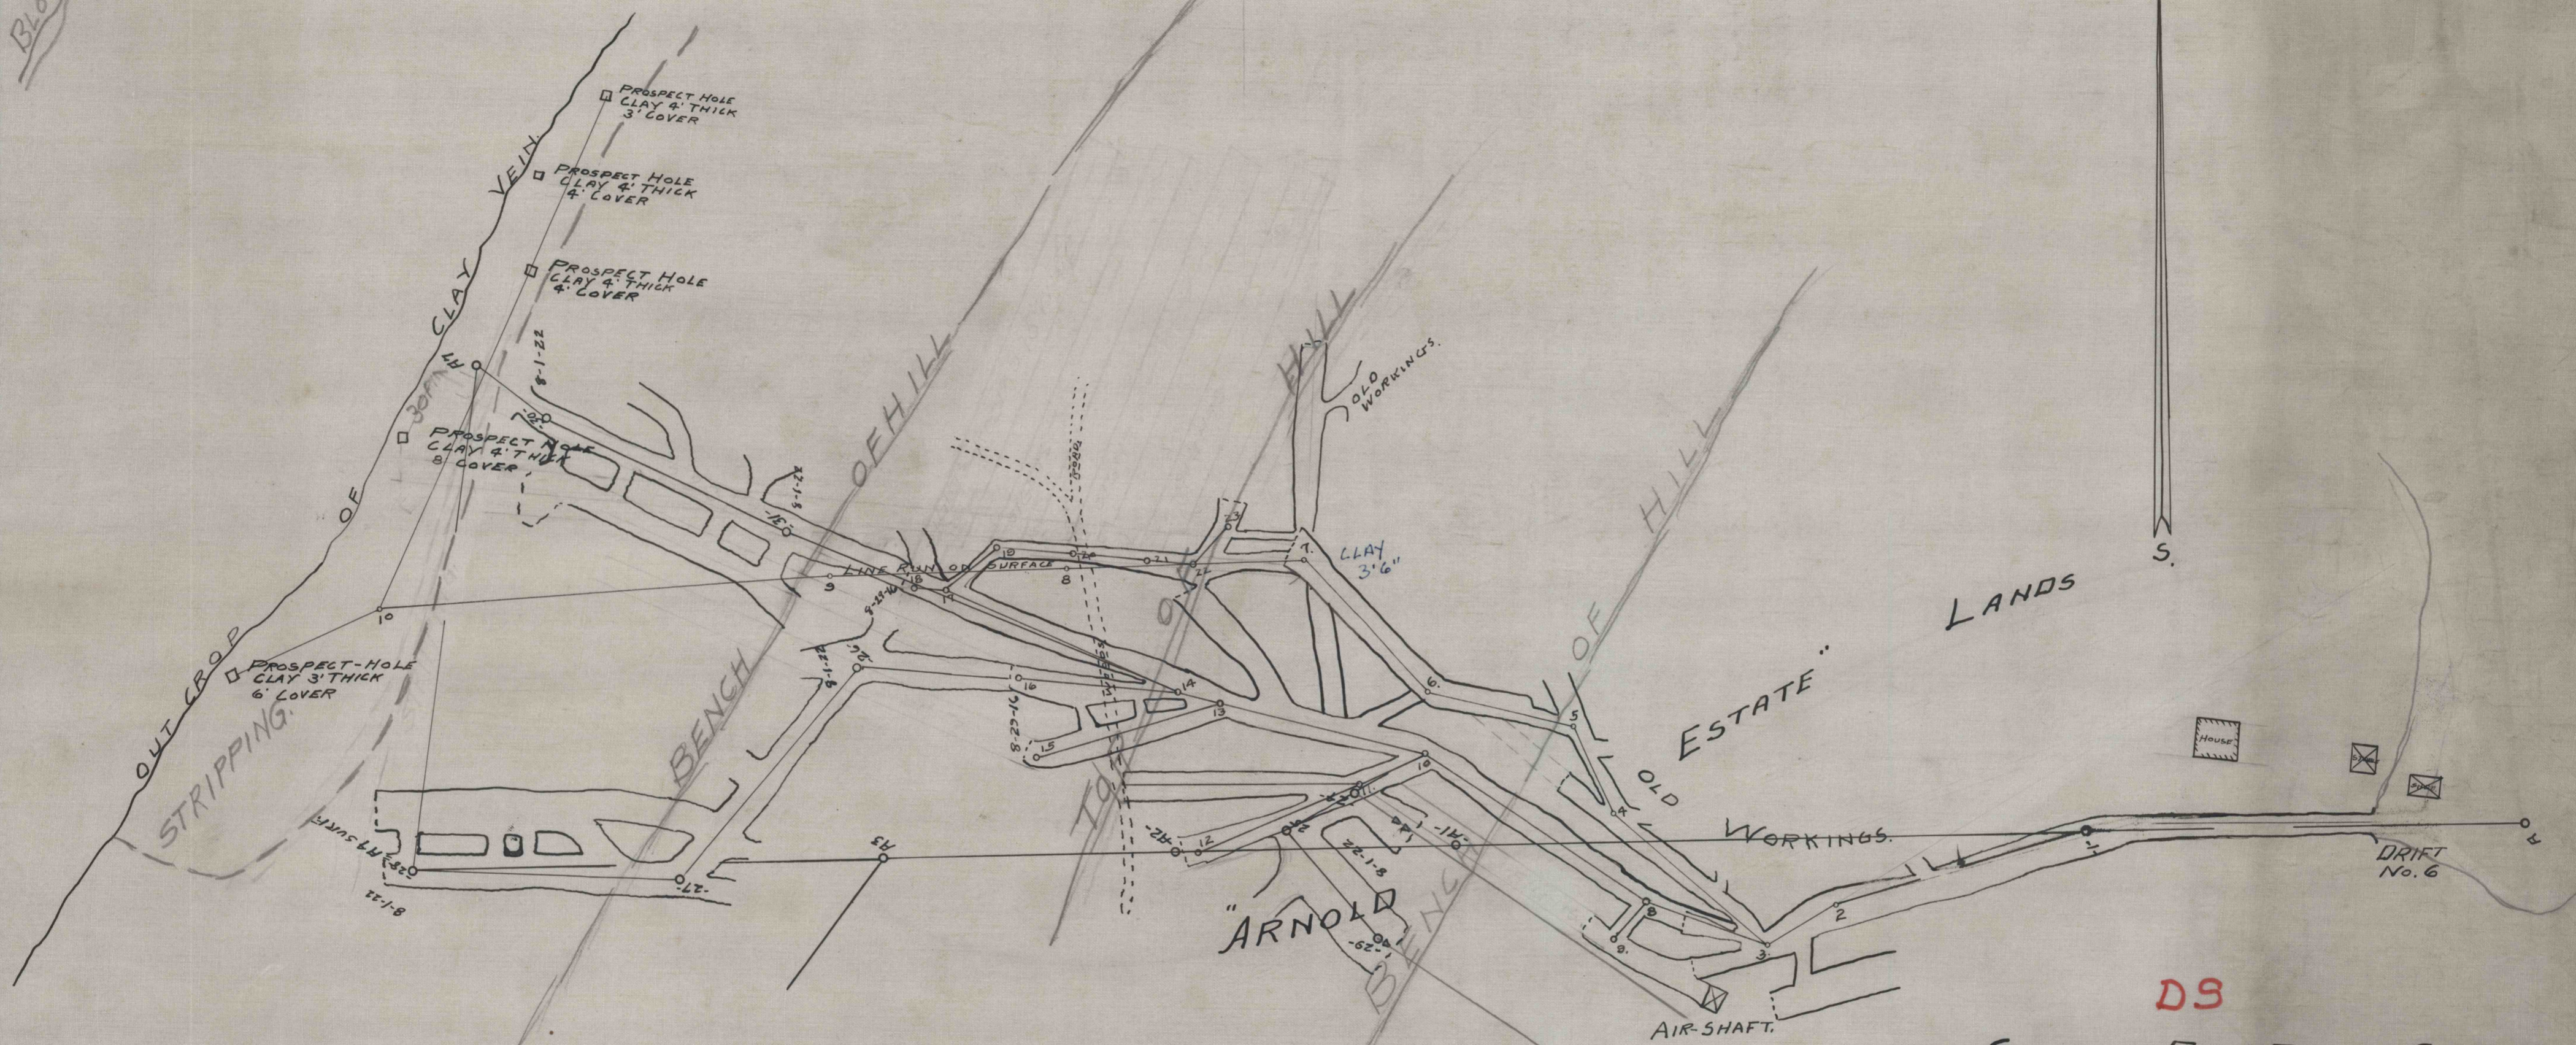


117
977

Blooms Run

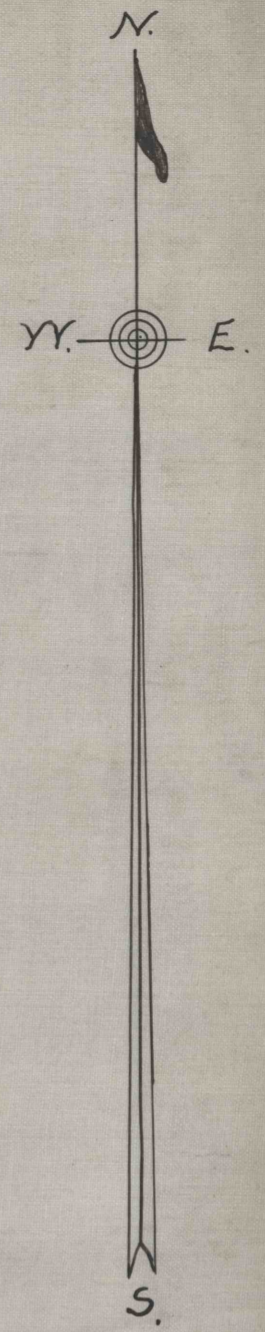

OUT CROP STRIPPING

G.H. THOMAS
FENCE LINE

APPROX. PROP. LINE AS
CLAIMED BY G.H. THOMAS

LANDS

ESTATE

ARNOLD

DS

SHARON FIRE BRICK CO.
MAP OF
FIRE CLAY MINE
IN
BLOOM, TWP, CLEARFIELD CO., PA.
SCALE 1"=50 FT.

CLEARFIELD, PA.
FEB 5-1916
AUG-29-1916
"-1-1922

OFFICE OF E.W. HESS
ENGINEER.

220