



BEAVER RUN COAL CO, ETAL
 C SEAM MINE WORKINGS
 IN
 PORTAGE & SUMMERHILL TWP
 CAMBRIA CO., PENNA.
 SCALE 31' = 5208' .. SEPT. 12, 1962

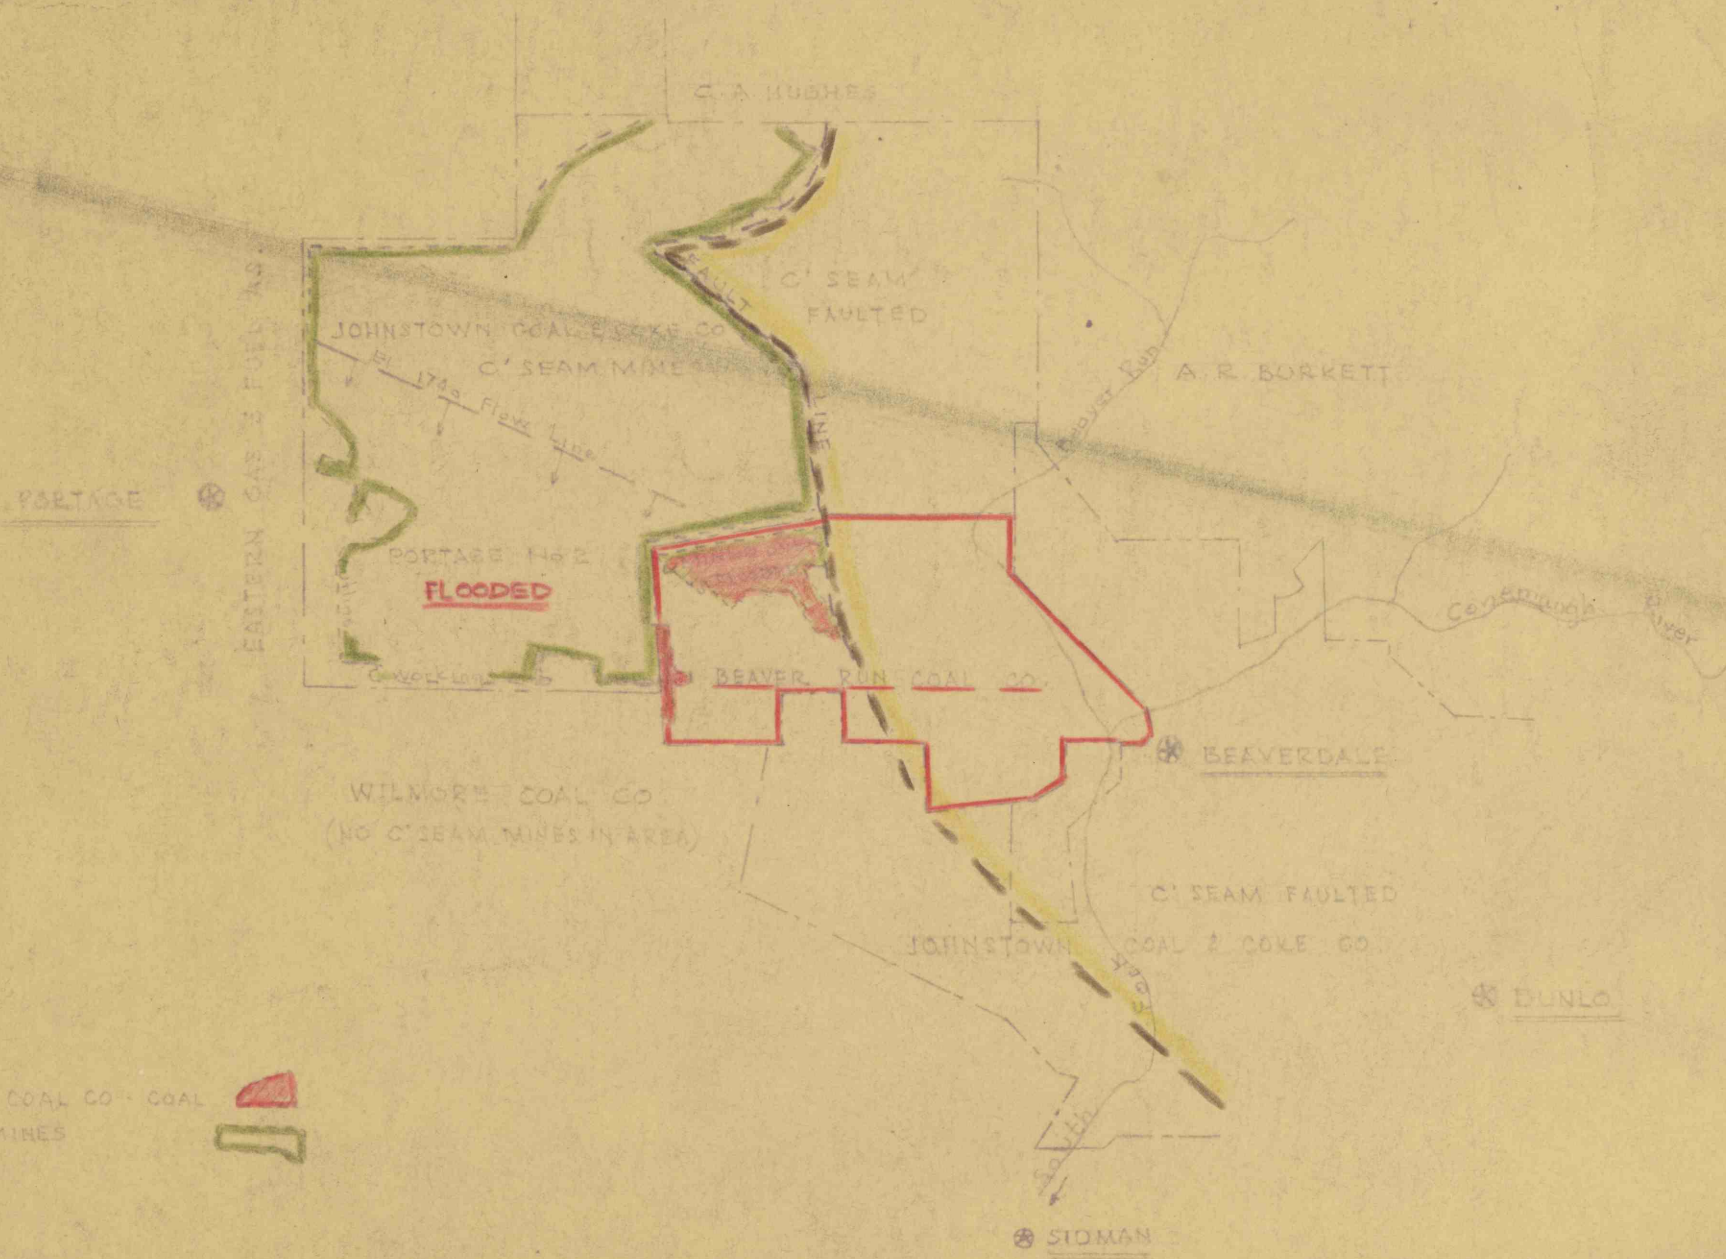

LEGEND:
 BEAVER RUN COAL CO - COAL 
 ADJACENT MINES 