


7005

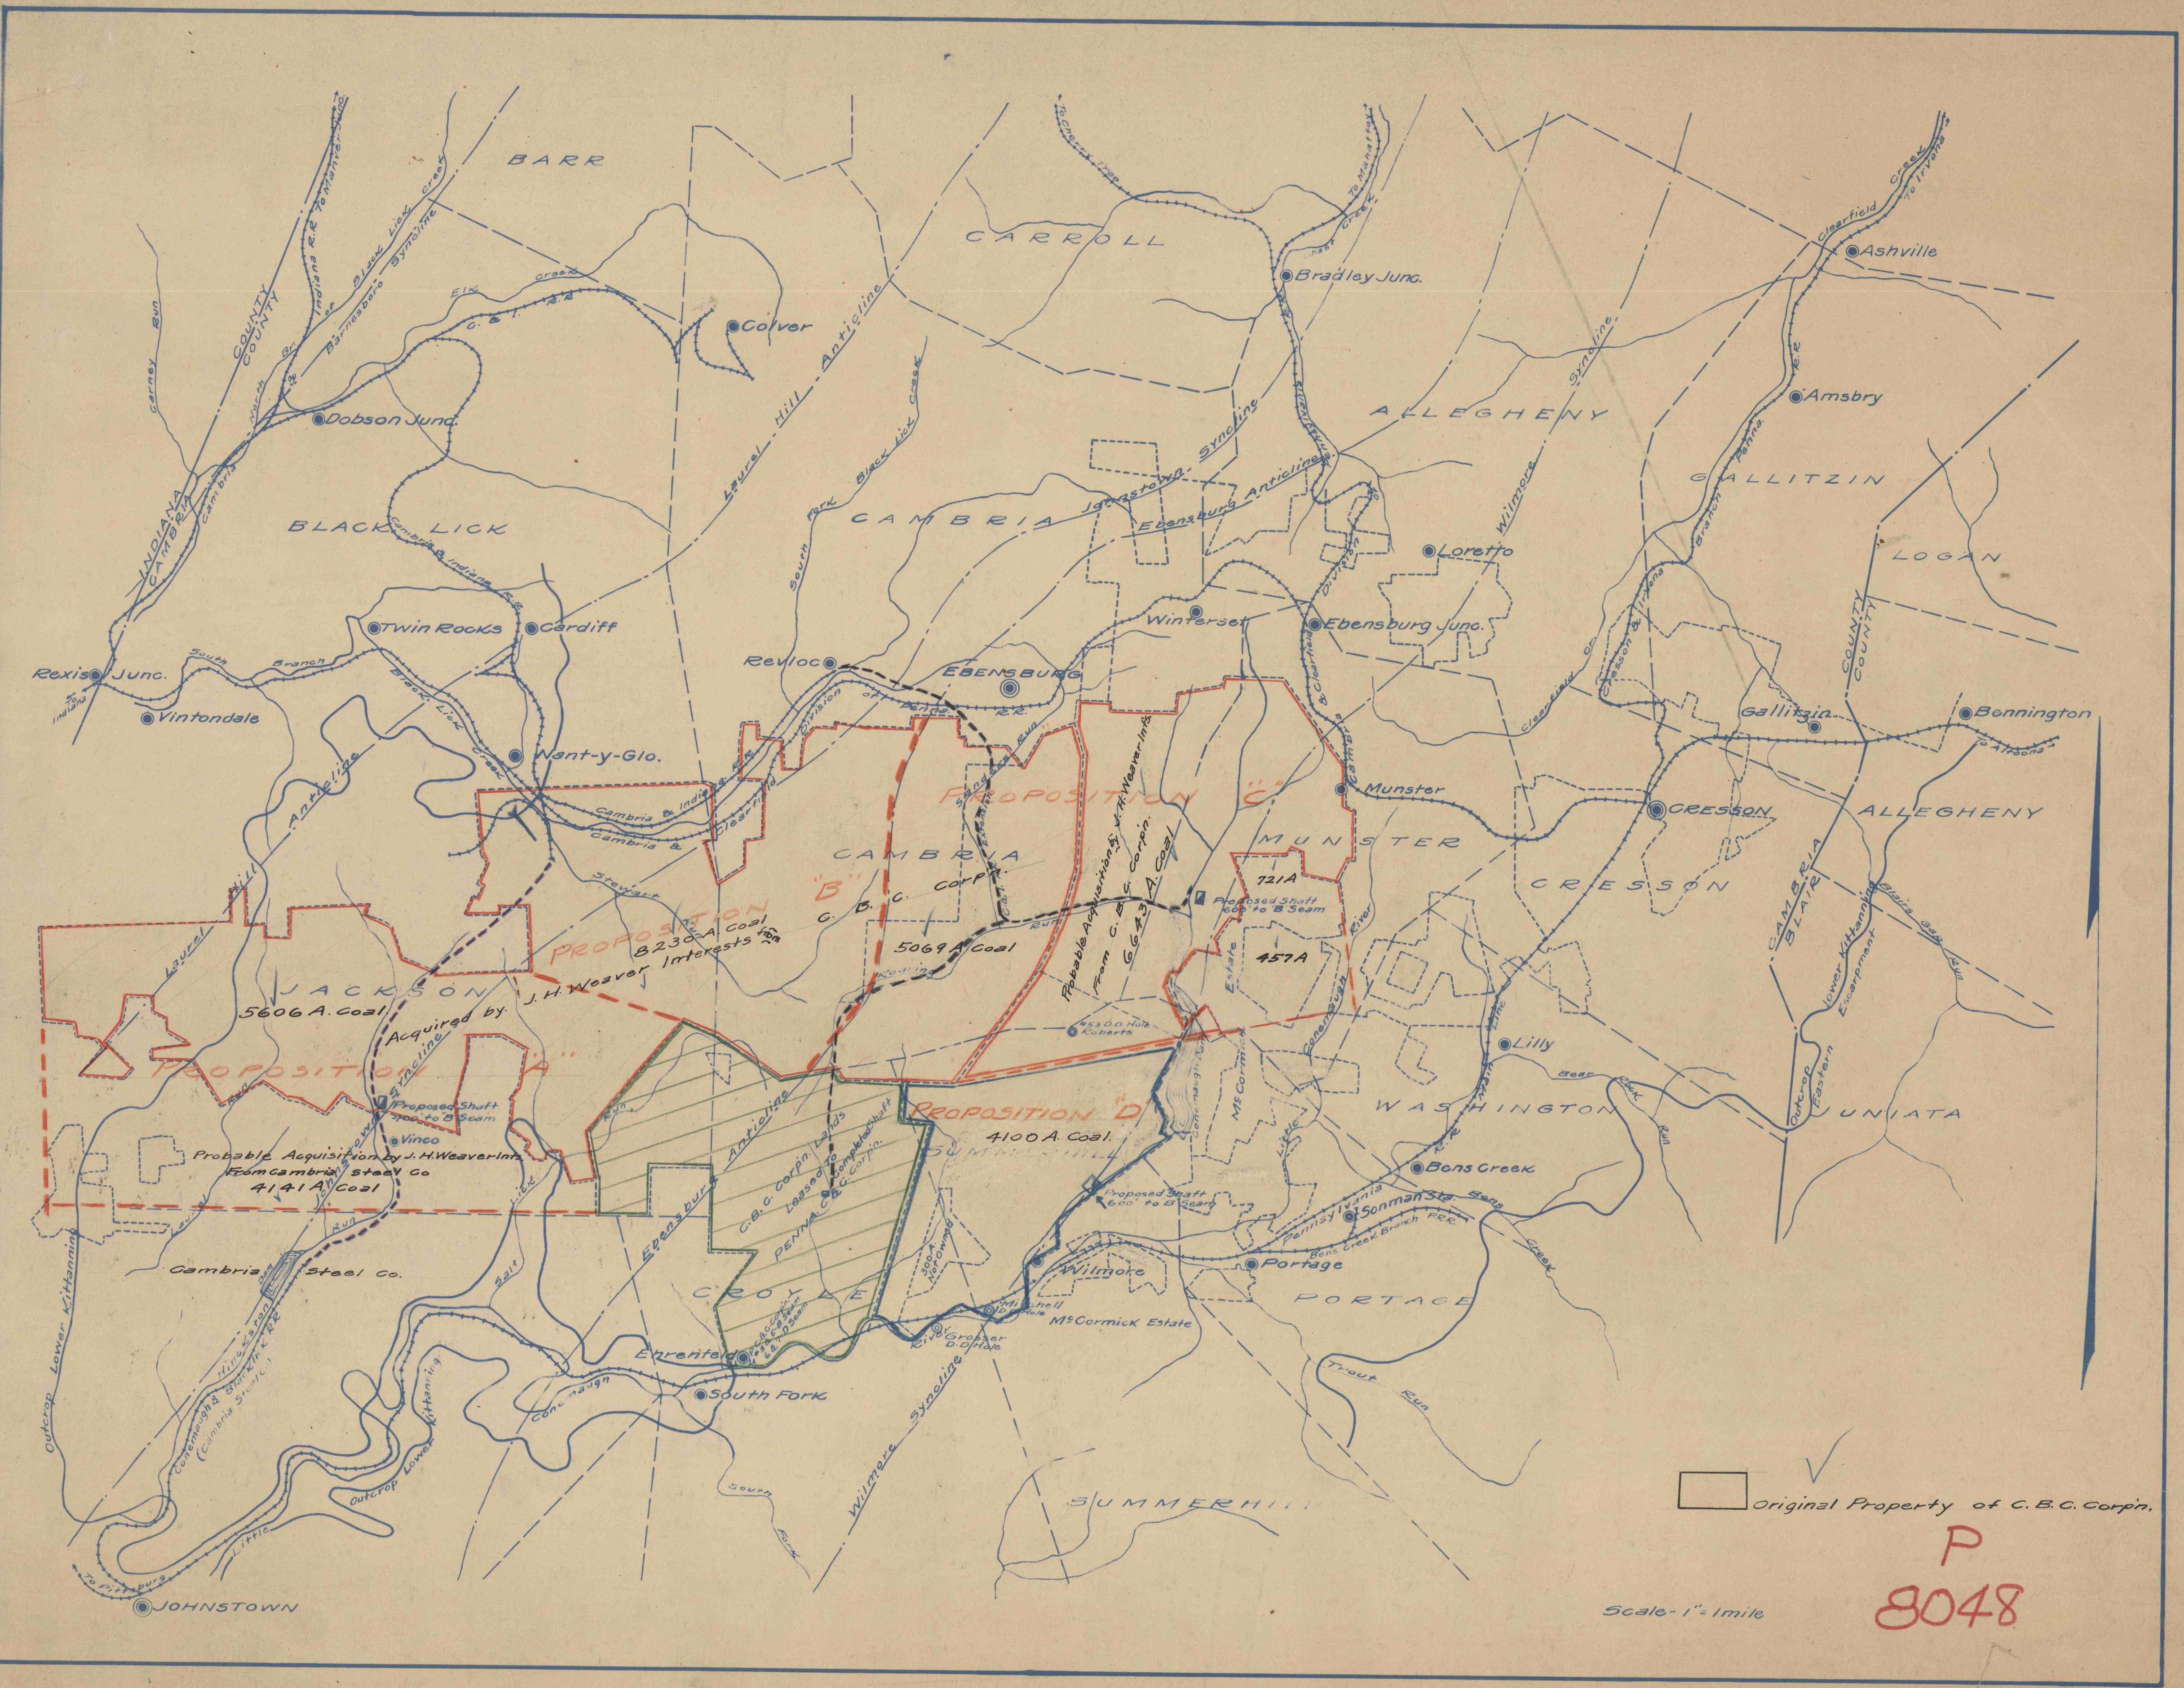

Original Property of C.B.C. Corp.

P
8048

Scale - 1" = 1 mile

True Copy of map made for Mr. Wetten
Jan. 9 1923