

REFERENCE DATA

CRESCENT REFRACTORIES CO.
CURWENSVILLE, CLEARFIELD COUNTY, PA.
ENGINEERING DEPARTMENT


ENV. NO. M2
SHEET NO. 15
50-3-420

SCALE 1" = 600 Ft.

GILBERT WISE TRACT.

DATE Feb 27-19

DIFFERENCE IN ELEVATION ABOUT 250 FT.

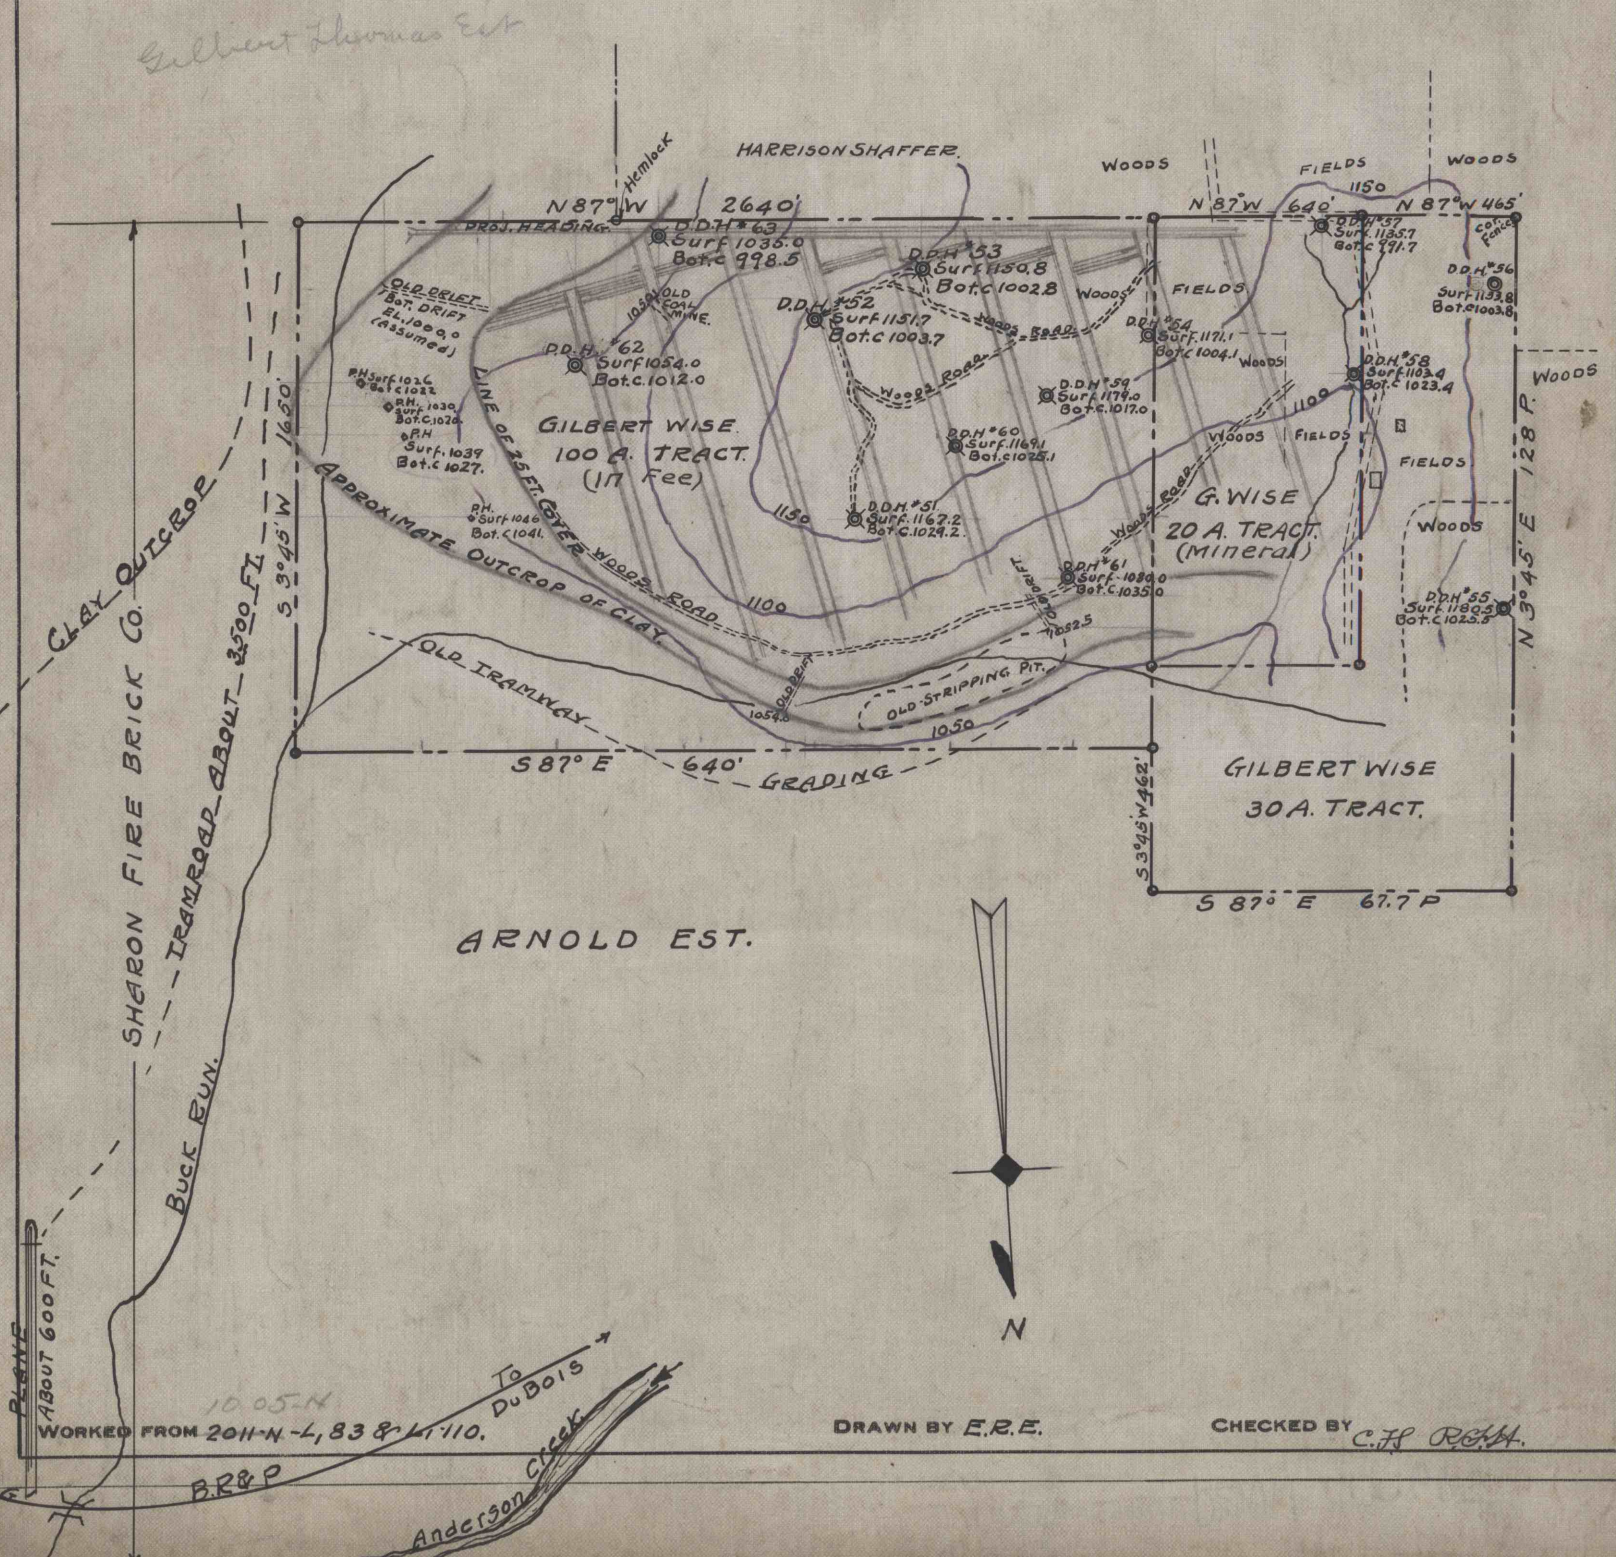

DRAWN BY E.E.E.

CHECKED BY C.F. RICH.

WORKED FROM 2011-N-4, 83 & 110.

B&P