


Scale: 1"=600 Ft.

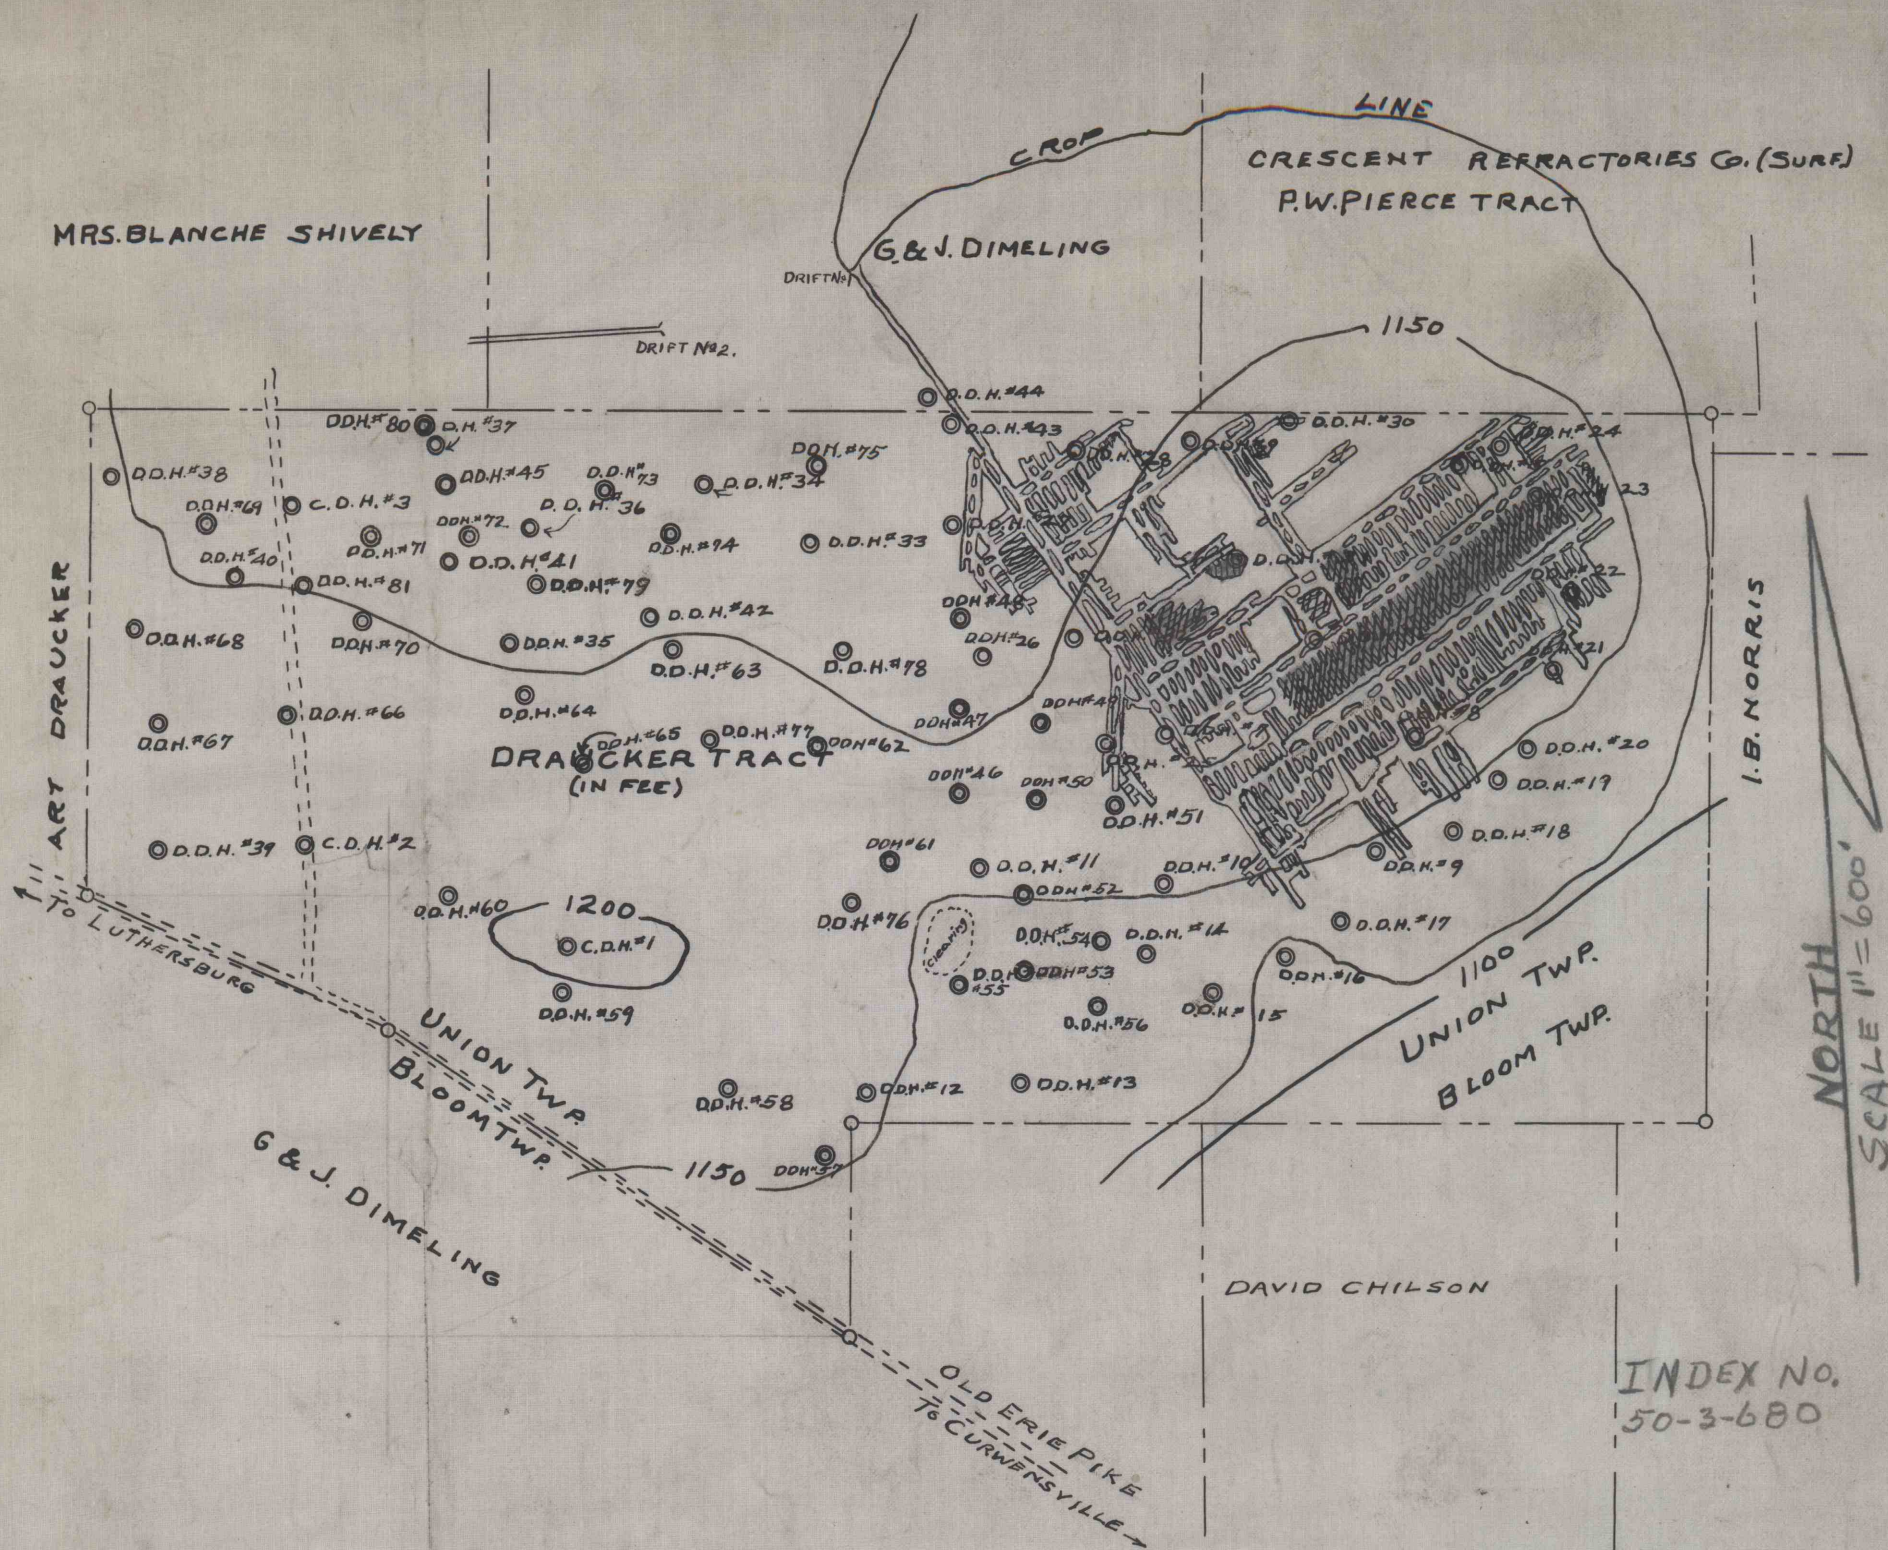

INDEX No.
50-3-680

C.D.H.#1 S-1213.6 BC-1064.6	C.D.H.#2 S-1105.2 BC-1103.2	C.D.H.#3 S-1134.4 BC-1061.4	D.D.H.#5 S-1194.2 BC-1116.7	D.D.H.#6 S-1206.7 BC-1112.4	D.D.H.#7 S-1178.5 BC-1101.5	D.D.H.#8 S-1173.5 BC-1113.0	D.D.H.#9 S-1146.8 BC-1115.8	D.D.H.#10 S-1157.5 BC-1104.5	D.D.H.#11 S-1152.1 BC-1091.1
D.D.H.#12 S-1161.2 BC-1094.2	D.D.H.#13 S-1129.8 BC-1096.8	D.D.H.#14 S-1136.5 BC-1105.2	D.D.H.#15 S-1123.8 BC-1113.8	D.D.H.#16 S-1127.3	D.D.H.#17 S-1140.8 BC-1119.8	D.D.H.#18 S-1140.6 BC-1117.6	D.D.H.#19 S-1143.8 BC-1122.8	D.D.H.#20 S-1157.7 BC-1123.7	D.D.H.#21 S-1166.0 BC-1126.0
D.D.H.#22 S-1168.6 BC-1121.6	D.D.H.#23 S-1175.40 BC-1120.4	D.D.H.#24 S-1162.8 BC-1098.8	D.D.H.#25 S-1134.1 BC-1082.1	D.D.H.#26 S-1123.6 BC-1089.6	D.D.H.#27 S-1134.4 BC-1097.4	D.D.H.#28 S-1151.0 BC-1102.0	D.D.H.#29 S-1167.4 BC-1110.4	D.D.H.#30 S-1175.1 BC-1108.0	D.D.H.#31 S-1152.2 BC-1072.2
D.D.H.#32 S-1115.2 BC-1081.2	D.D.H.#33 S-1110.7 BC-1073.7	D.D.H.#34 S-1142.2 BC-1066.2	D.D.H.#35 S-1122.5 BC-1070.5	D.D.H.#36 S-1123.0	D.D.H.#37 S-1152.8 BC-1042.8	D.D.H.#38 S-1175.4 BC-1062.4	D.D.H.#39 S-1145.2 BC-1063.2	D.D.H.#40 S-1128.5 BC-1066.5	D.D.H.#41 S-1144.3 BC-1071.3
D.D.H.#42 S-1112.0 BC-1084.0	D.D.H.#43 S-1107.8 BC-1088.8	D.D.H.#44 S-1124.0 BC-1062.5	D.D.H.#45 S-1157.8 BC-1087.3	D.D.H.#46 S-1139.4 BC-1085.4	D.D.H.#47 S-1129.5 BH-1078.5	D.D.H.#48 S-1157.9 BC-1091.4	D.D.H.#49 S-1165.1 BC-1093.6	D.D.H.#50 S-1168.8 BC-1106.1	D.D.H.#51 S-1150.4 BC-1093.9
D.D.H.#52 S-1136.4 BC-1095.4	D.D.H.#53 S-1139.8 BC-1073.8	D.D.H.#54 S-1149.3 BC-1093.8	D.D.H.#55 S-1125.6 BH-1104.6	D.D.H.#56 S-1148.8 BC-1084.8	D.D.H.#57 S-1172.8 BC-1073.8	D.D.H.#58 S-1193.9 BH-1075.9	D.D.H.#59 S-1190.2 BH-1069.2	D.D.H.#60 S-1169.0 BC-1084.5	D.D.H.#61 S-1165.2 BC-1081.2
D.D.H.#62 S-1153.2 BC-1078.7	D.D.H.#63 S-1151.0 BH-1070.0	D.D.H.#64 S-1175.7 BH-1073.7	D.D.H.#65 S-1155.5 BC-1063.0	D.D.H.#66 S-1155.5 BC-1066.5	D.D.H.#67 S-1146.6 BC-1059.3	D.D.H.#68 S-1142.1 BC-1058.1	D.D.H.#69 S-1139.9 BC-1063.4	D.D.H.#70 S-1129.9 BC-1064.7	D.D.H.#71 S-1126.5 BC-1070.5
D.D.H.#72 S-1113.2 BH-1062.2	D.D.H.#73 S-1118.9 BH-1072.9	D.D.H.#74 S-1102.6 BC-1063.6	D.D.H.#75 S-1194.8 BC-1092.3	D.D.H.#76 S-1183.5 BC-1074.8	D.D.H.#77 S-1130.9 BC-1080.4	D.D.H.#78 S-1132.0 BC-1071.5	D.D.H.#79 S-1132.4 BC-1058.7	D.D.H.#80 S-1136.2 BC-1057.7	D.D.H.#81

50-3-680

Put North Point on