


0 4' COAL  
40 FT ABOVE JONKINS RUN

10301

1036

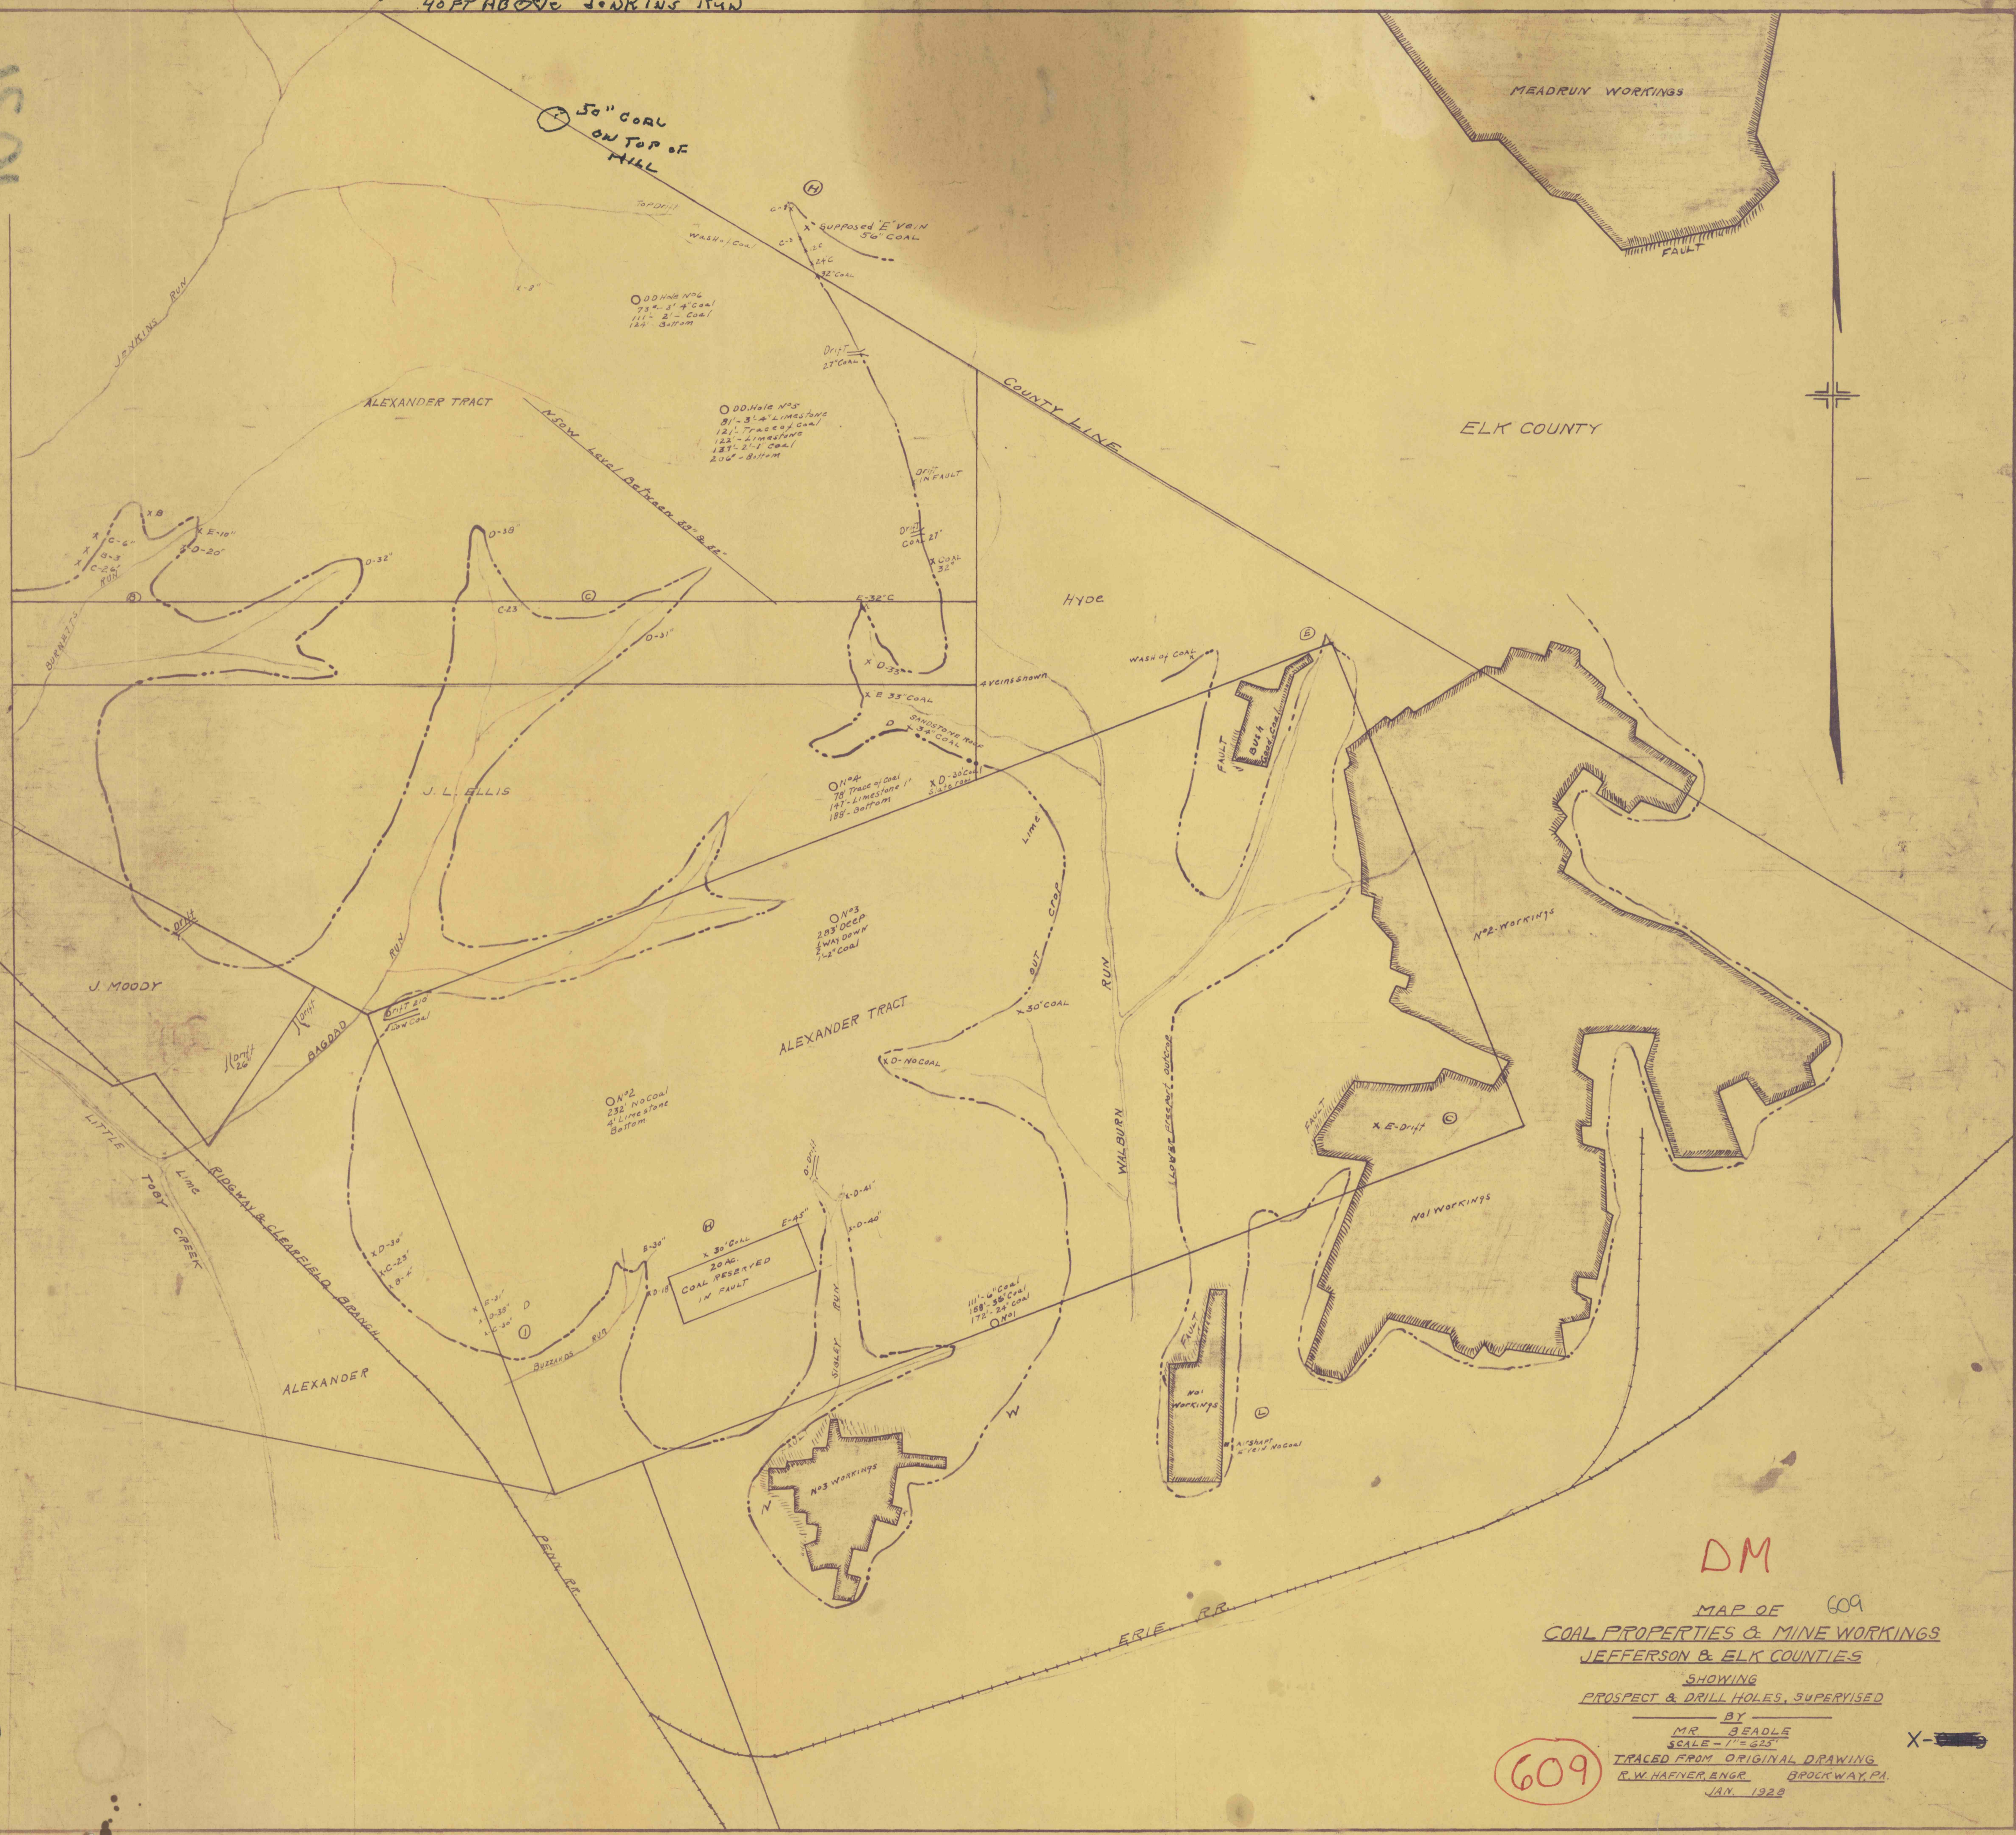

DM

MAP OF 609  
 COAL PROPERTIES & MINE WORKINGS  
 JEFFERSON & ELK COUNTIES  
 SHOWING  
 PROSPECT & DRILL HOLES, SUPERVISED  
 BY  
 MR. BEADLE  
 SCALE - 1" = 325'  
 TRACED FROM ORIGINAL DRAWING  
 R. W. HAFFNER, ENGR. BROCKWAY, PA.  
 JAN. 1928

609

