


AGENCIES
 T. W. ...
 ...
COALING STATIONS
 ...
COKE OVENS
 ...
COALERS
 ...
ENGINEHOUSES
 ...
PASSENGER STATIONS
 ...
WAREHOUSES
 ...
TELEGRAPH OFFICES
 ...
WATER STATIONS
 ...

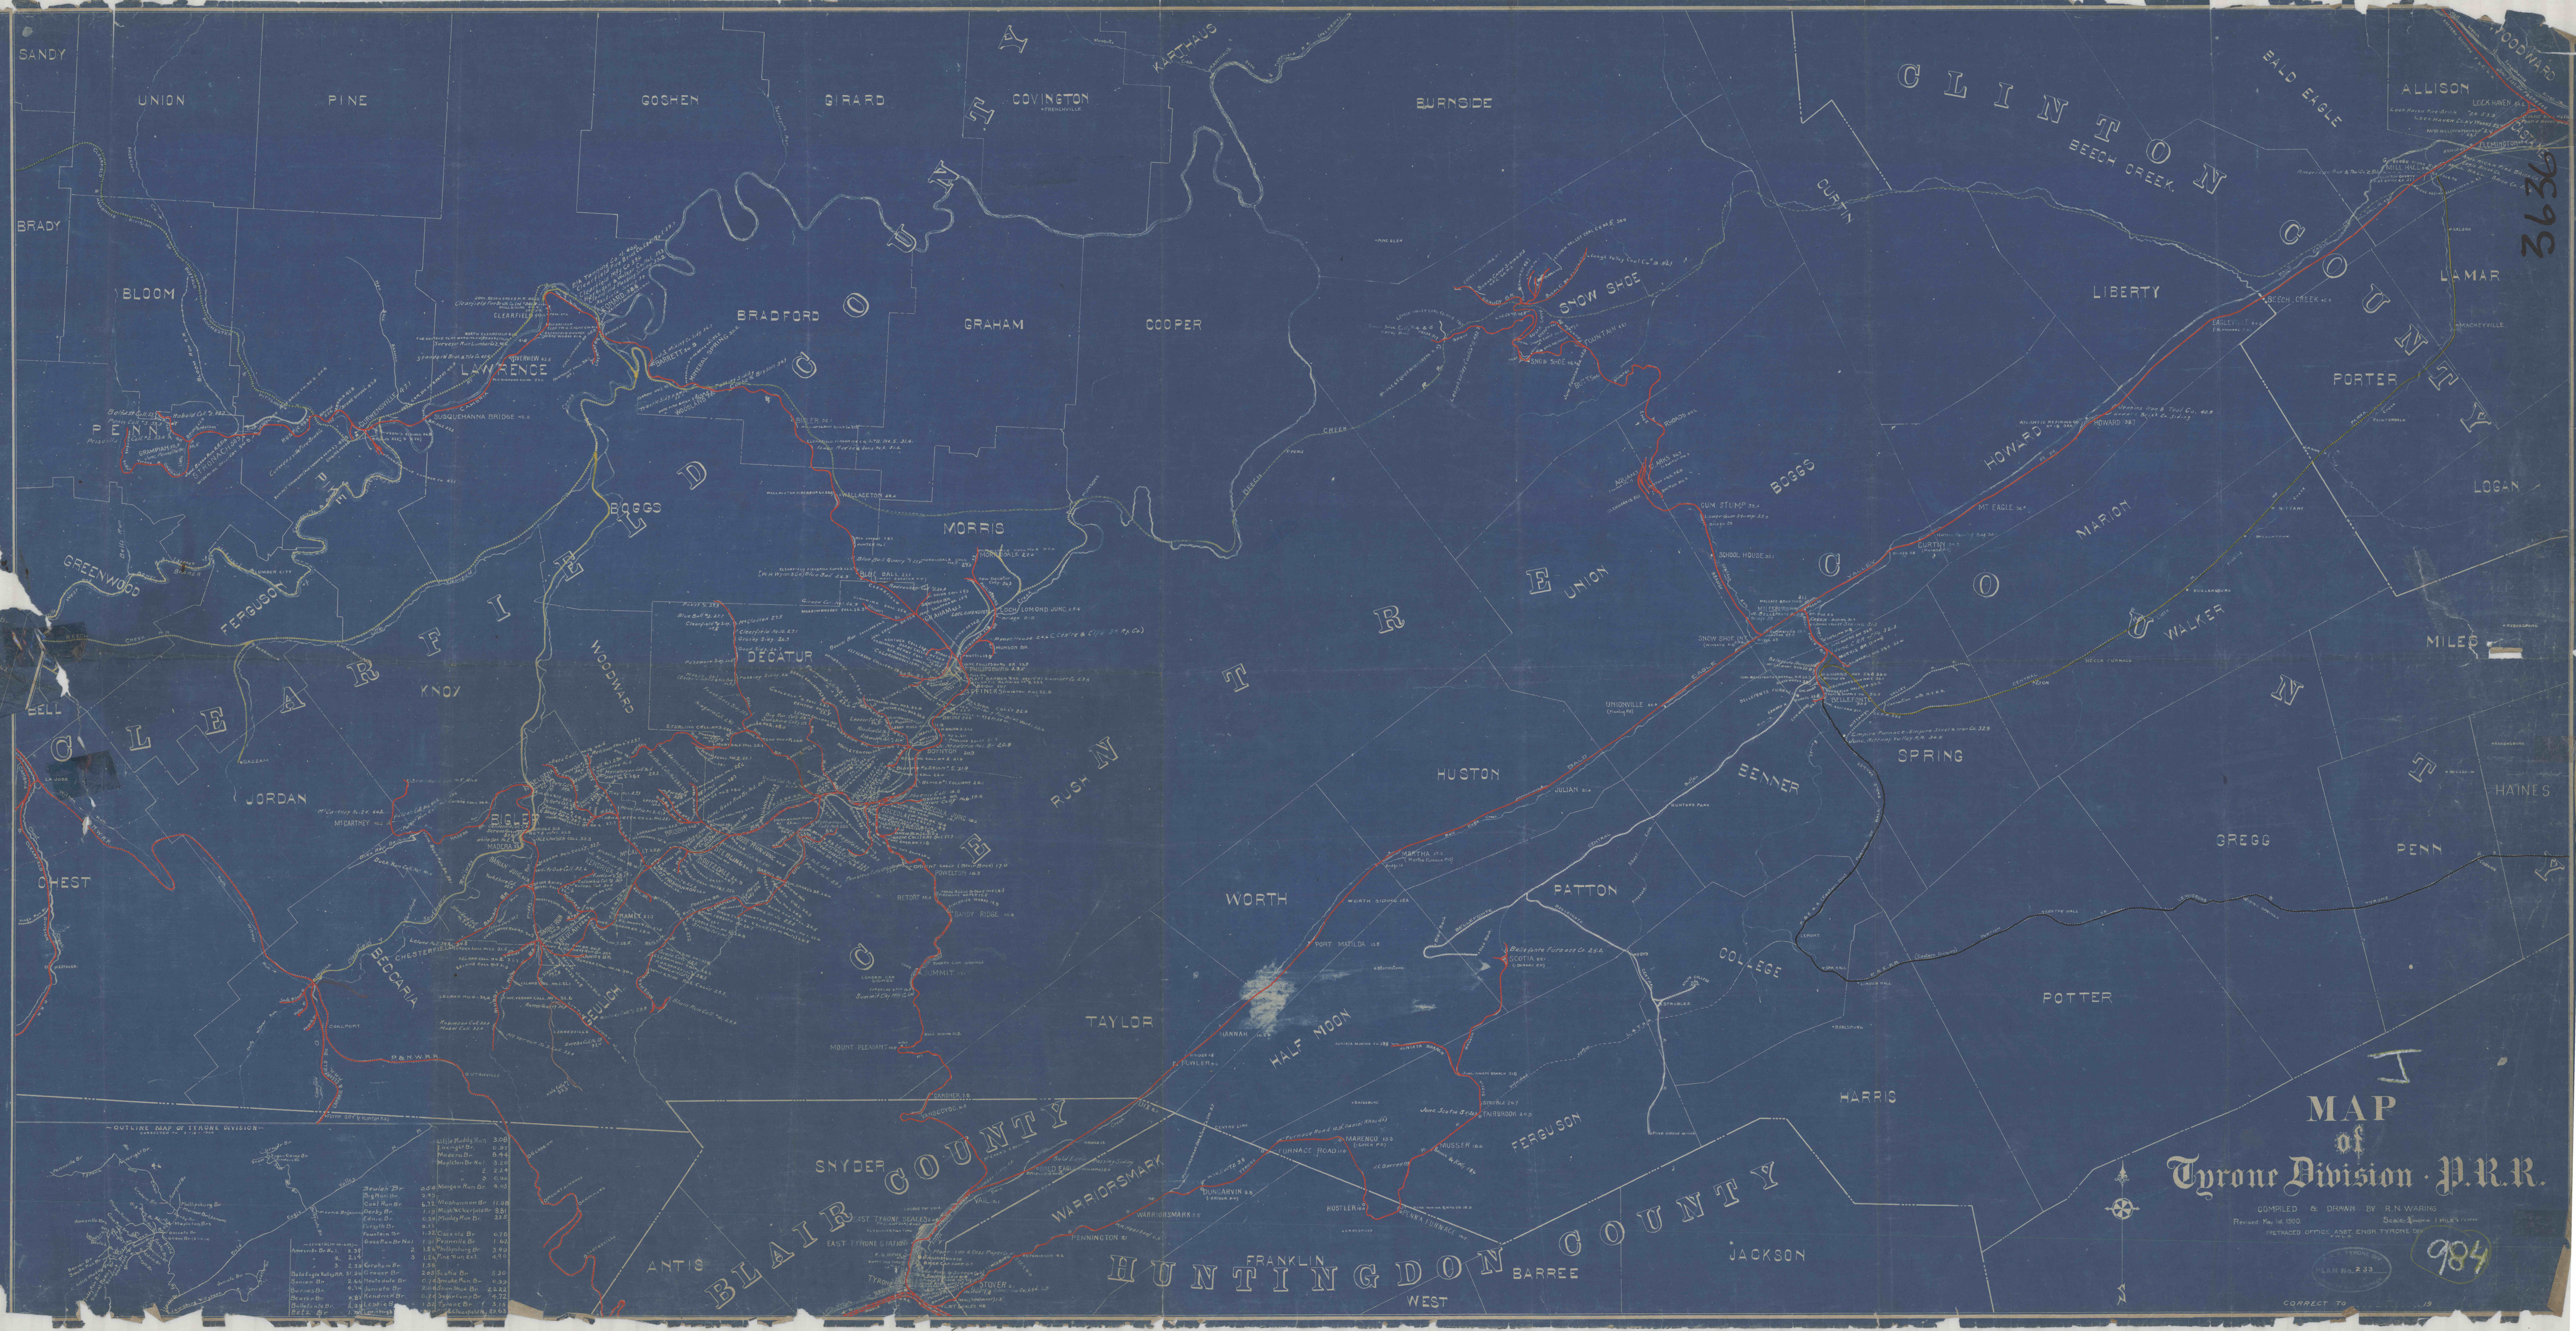



MAP of Tyrone Division P.R.R.
 COMPILED & DRAWN BY R.N. WARING
 Revised May 14, 1900.
 CORRECT TO 1900

