

REFERENCE DATA

CRESCENT REFRACTORIES CO.

CURWENSVILLE, CLEARFIELD COUNTY, PA.
ENGINEERING DEPARTMENT

JOHN M. CHASE ESTATE
FIRE CLAY LANDS AT FAUNCE


ENV. No. *M2*

SHEET No. *69*

55-2-14

DATE *3-11-19*

SCALE *1" = 800'-0"*

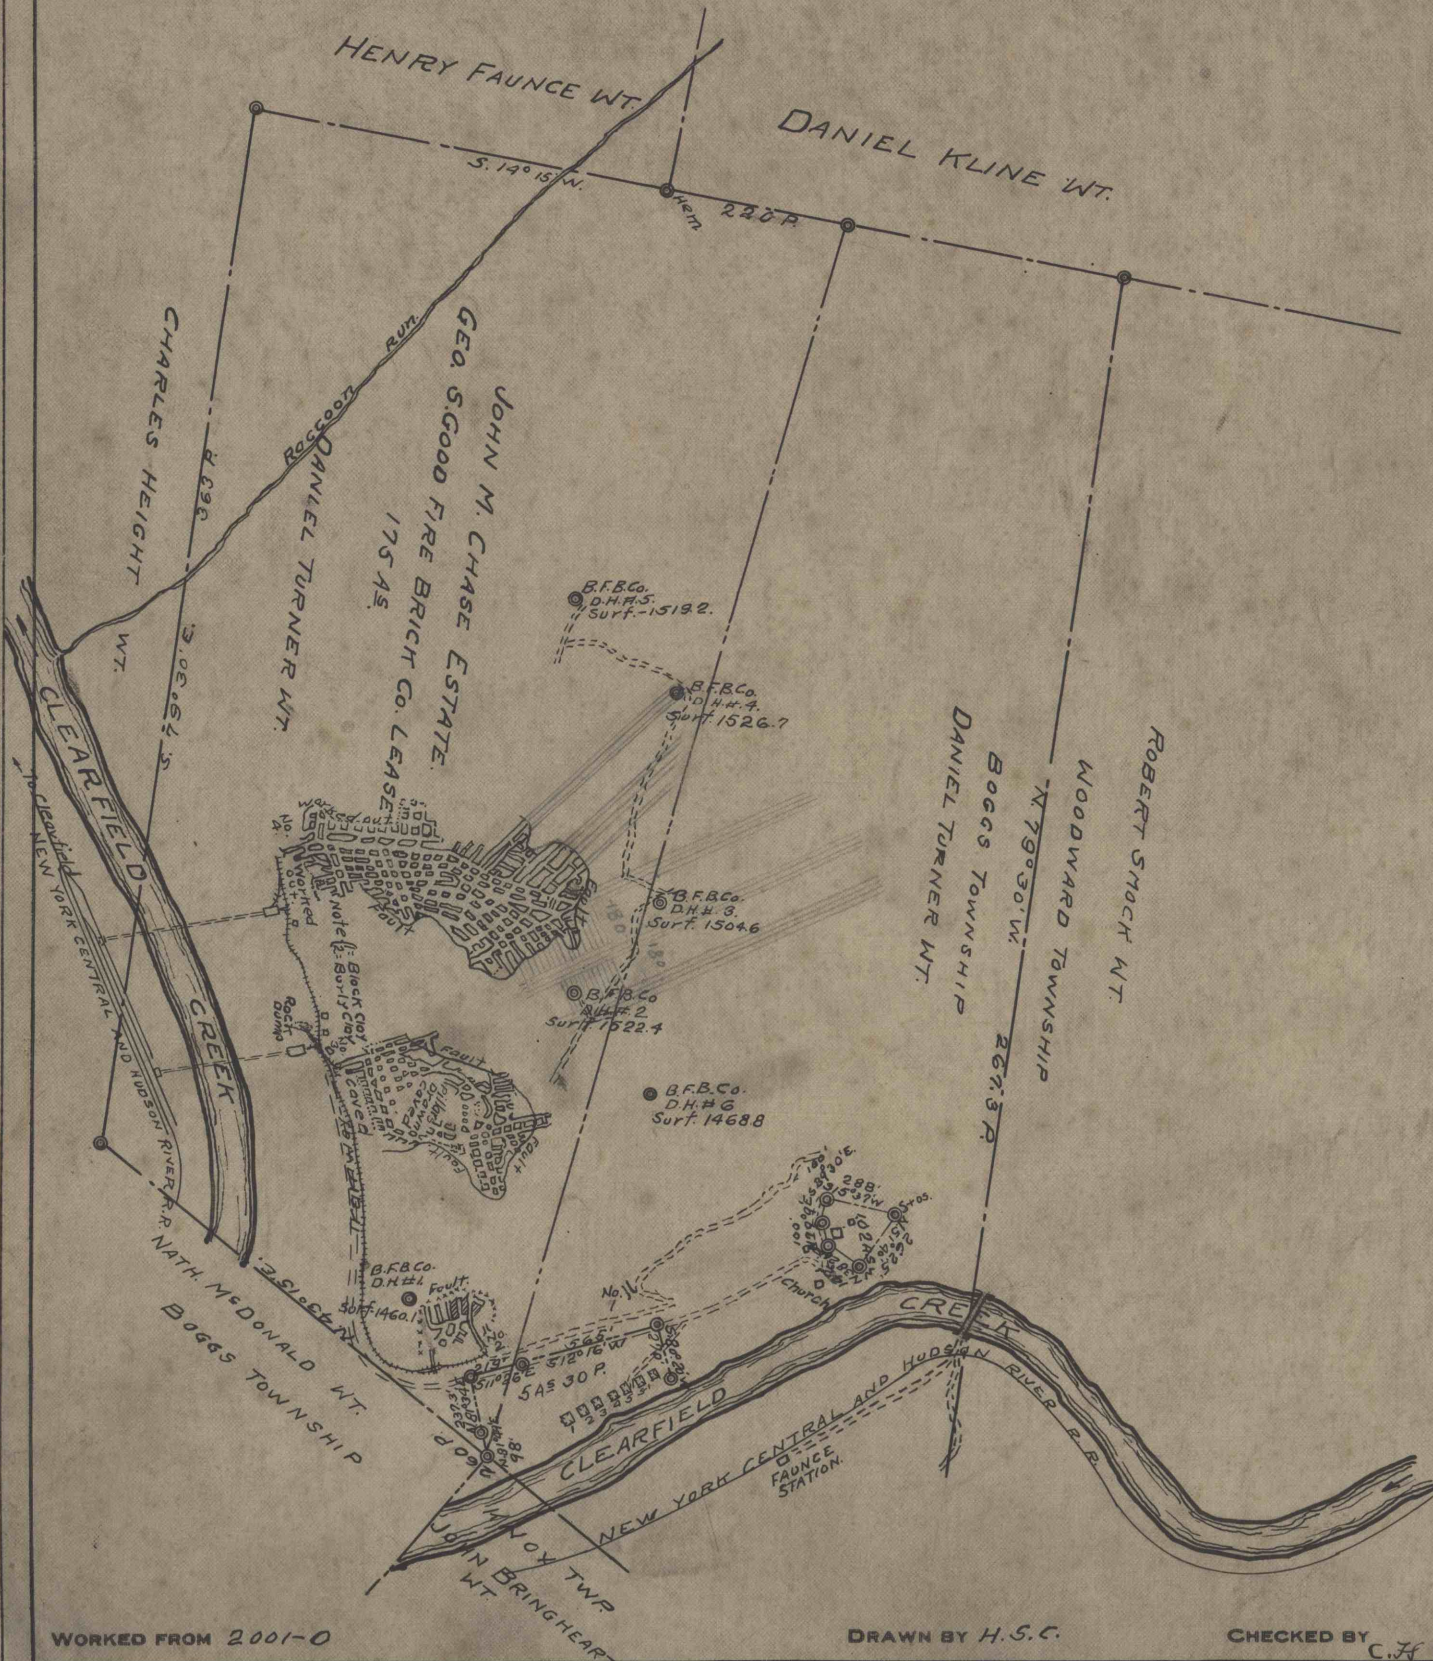

WORKED FROM 2001-0

DRAWN BY H.S.C.

CHECKED BY *C.F. [Signature]*