

R. B. WIGTON & SONS.
SHOFF.

B. ALEXANDER

See "B."

SHOFF.

ALL MOSHANNON OR "D" COAL MINED FROM THIS TRACT
EXCEPT 1/4 ACRE, SHOWN IN DETAIL "B"

MOSHANNON OR "D" VEIN OF COAL HAS BEEN MINED FROM
WITH THE EXCEPTION OF 1/2 ACRE, SHOWN IN DETAIL "A"

BERWIND, WHITE
& CO.

R. B. WIGTON & SONS

Geo. Baker, Tract.


FISHER BRO,
& CO.

TOWNSHIP ROAD

PD

Detail "A" Uncolored portion from land line out to
Coal marked Croppy, actual condition of
VULCAN No 1, showing coal yet remaining
equal to 1/2 Acre.

Scale 1" = 100'

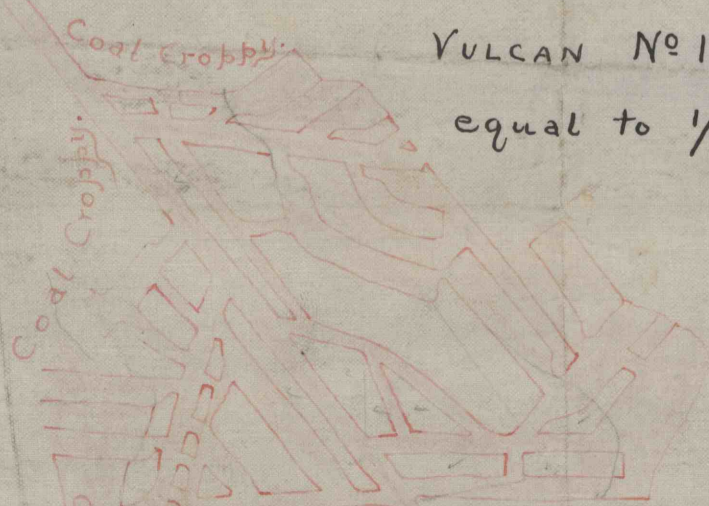

LAND LINE

Line between R. B. W & Sons, &
S. Hegarty.

C. S. L.

TAIL
SONS
DS
NSHIP
CO.
COAL
, 1894.
S.