


1123

P
703

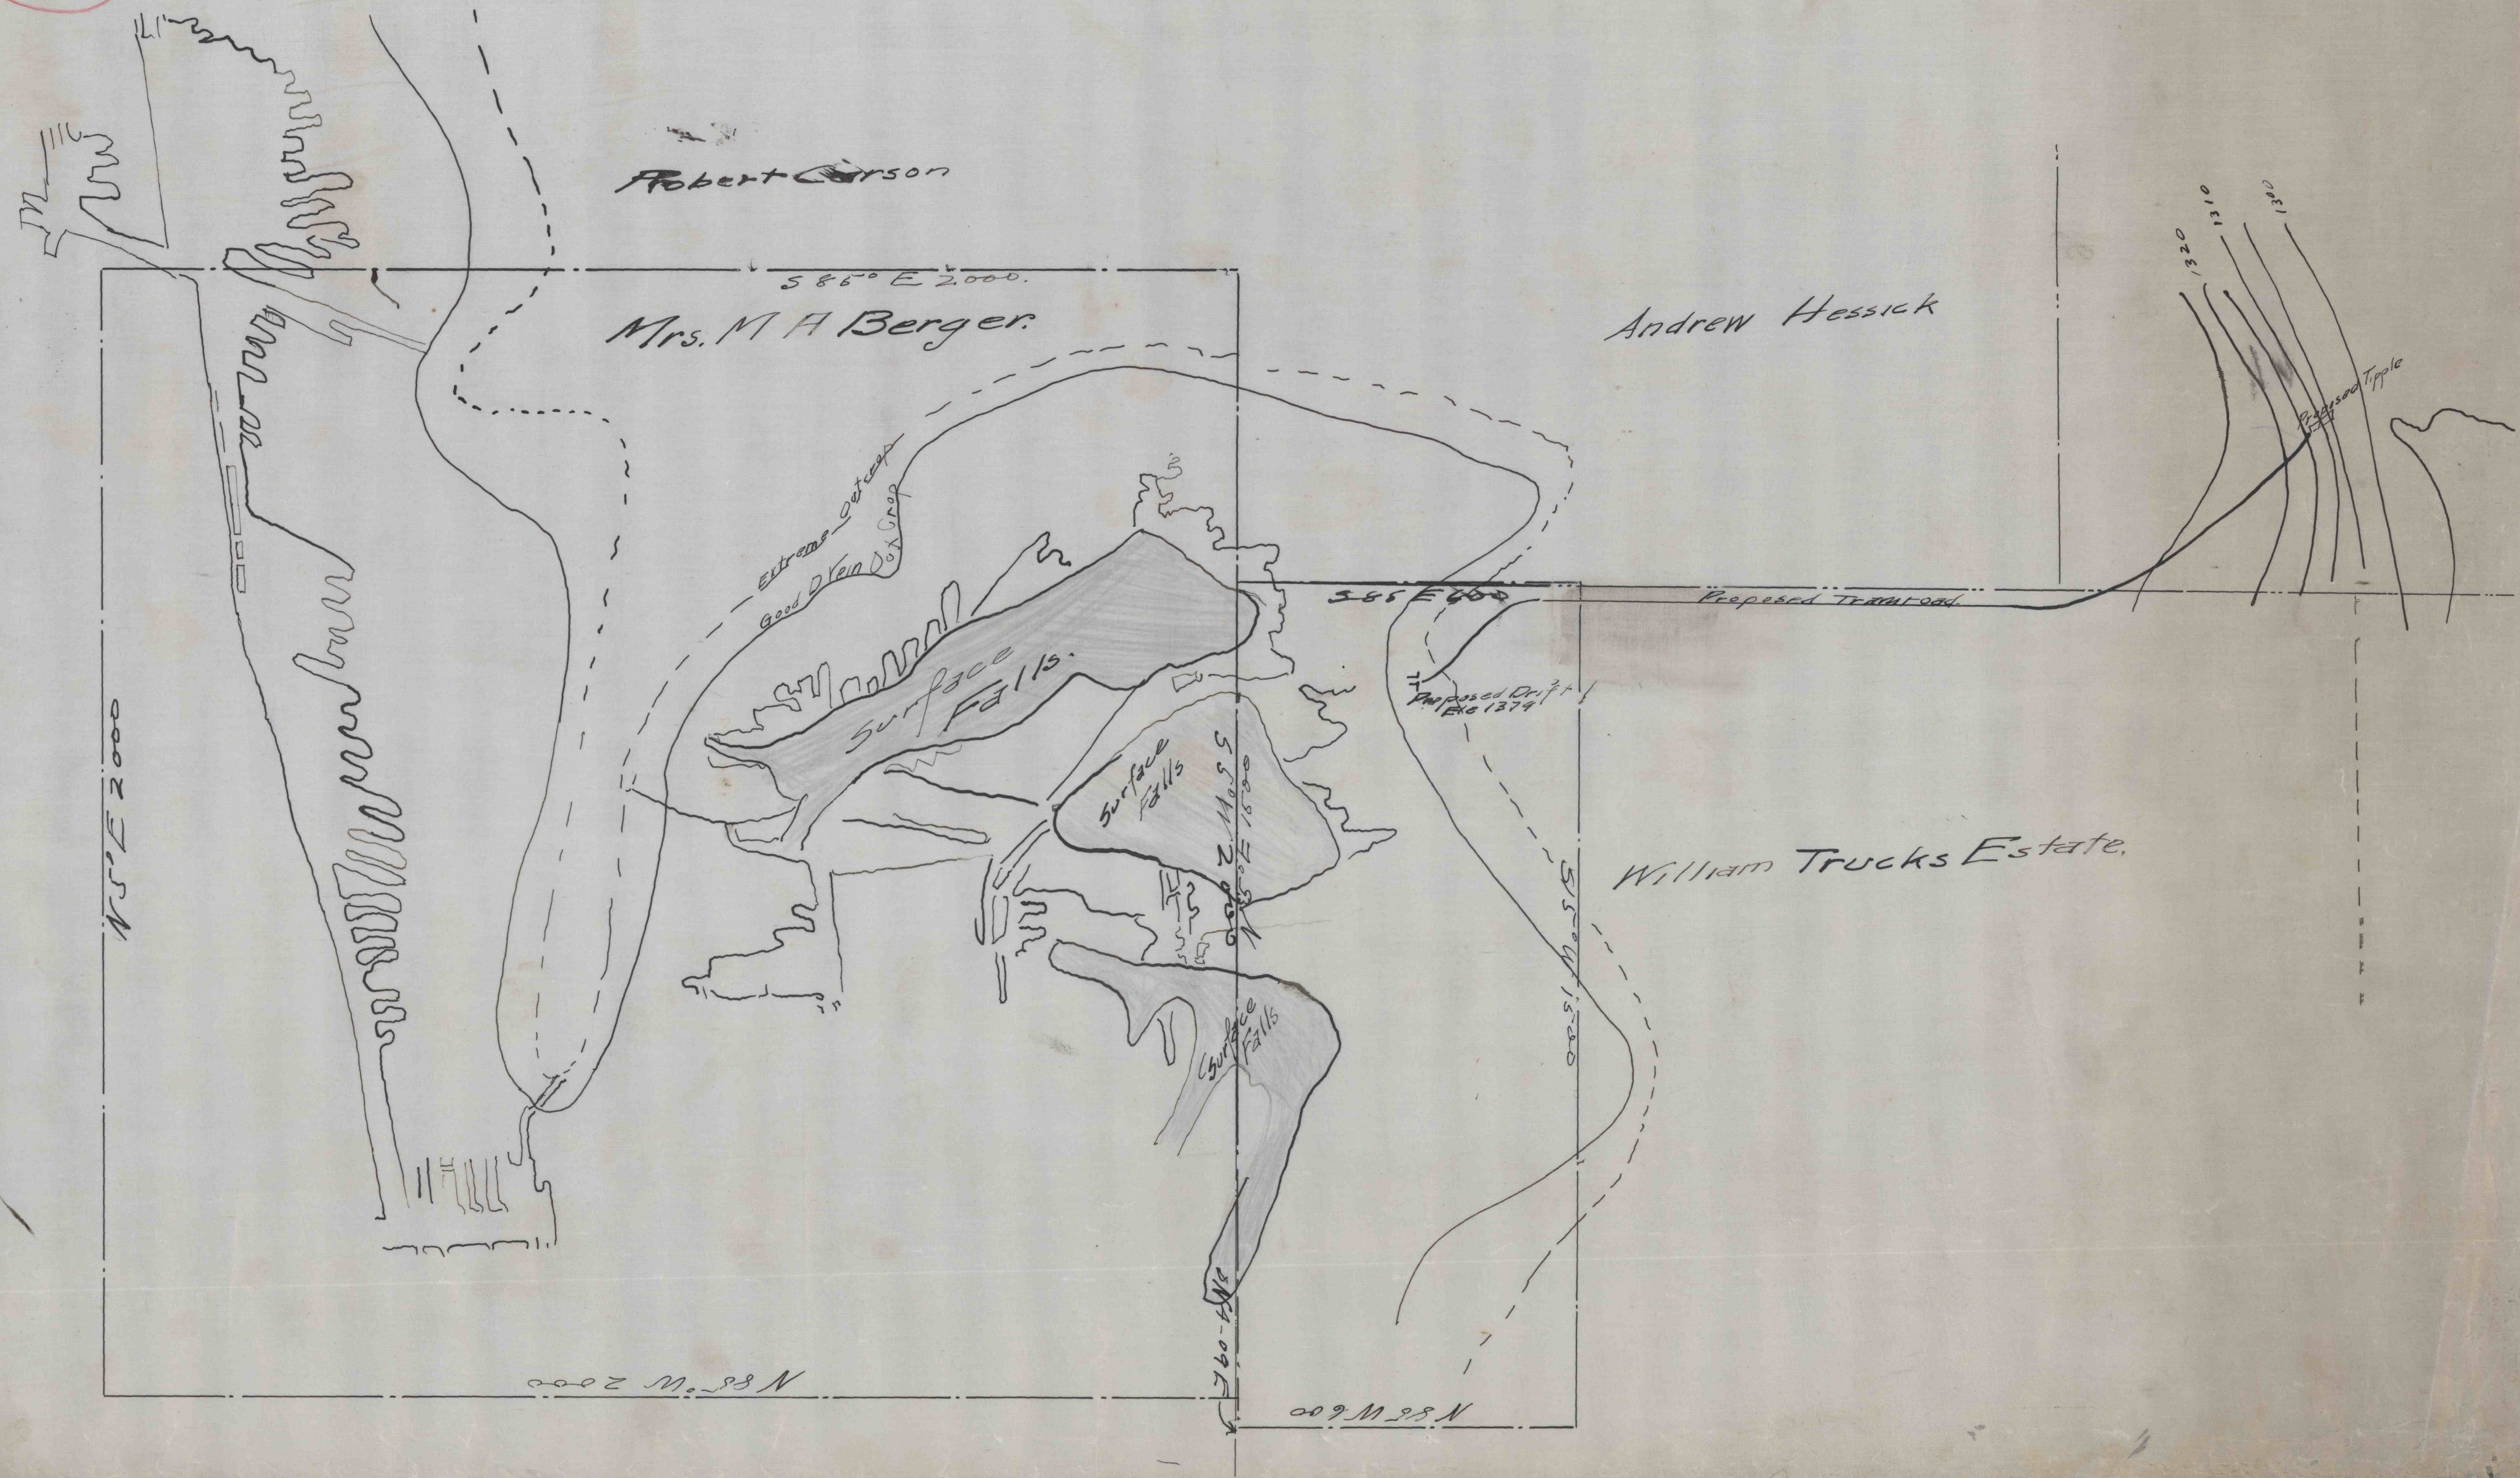

1153