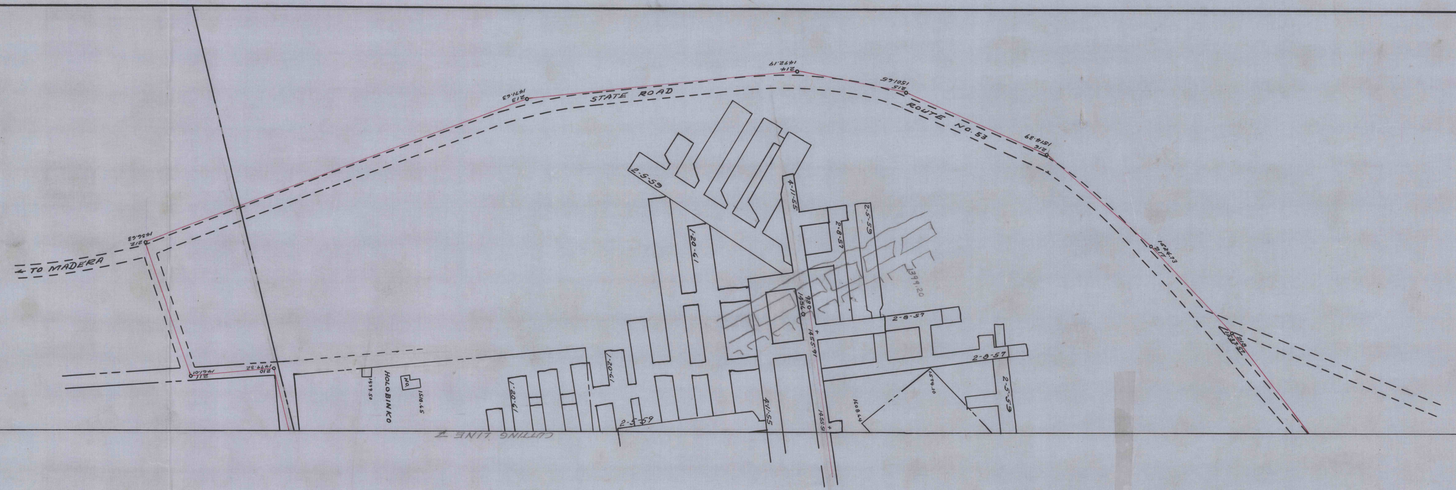

8291

Mid Penn No. 5
B Seam

1958

C.D. 297

D

8291