


196B

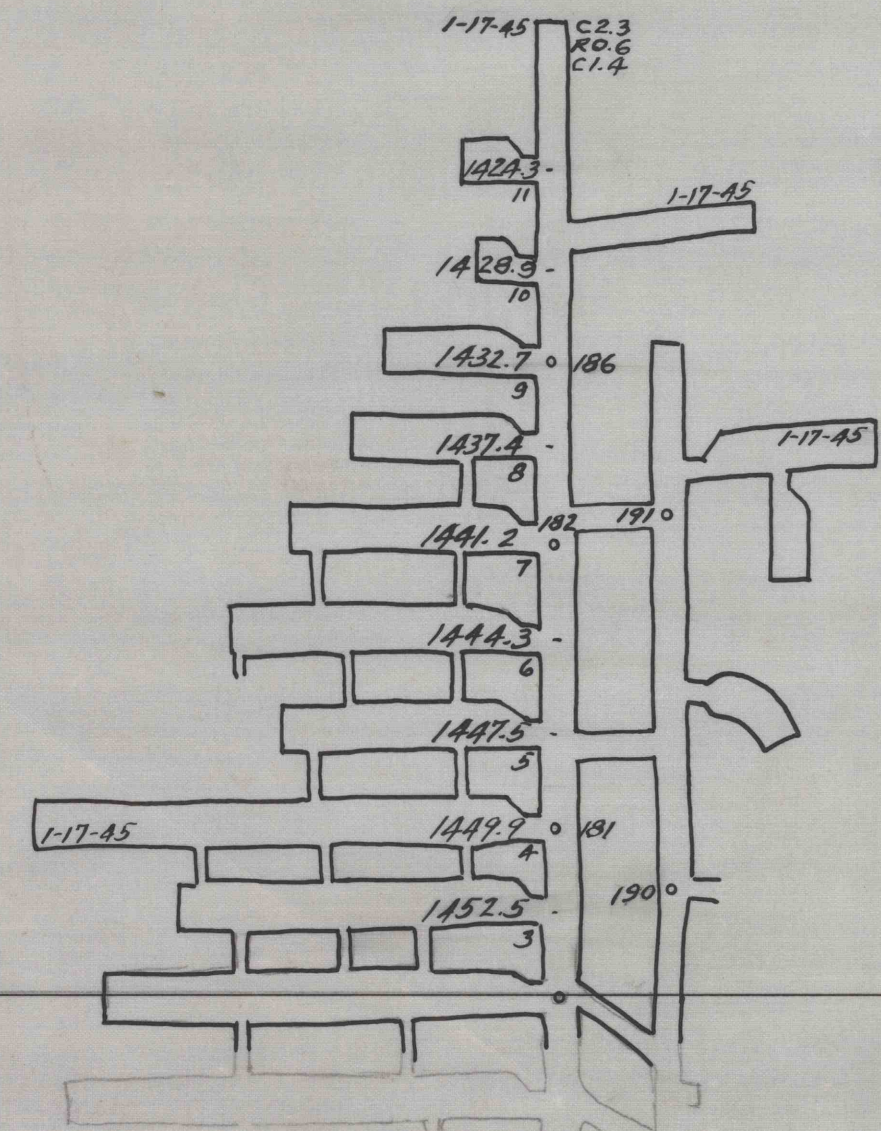

D
C.D. 355

196B