


2861

JOSEPH HENRY

LIONAS MONS ESTATE

2861

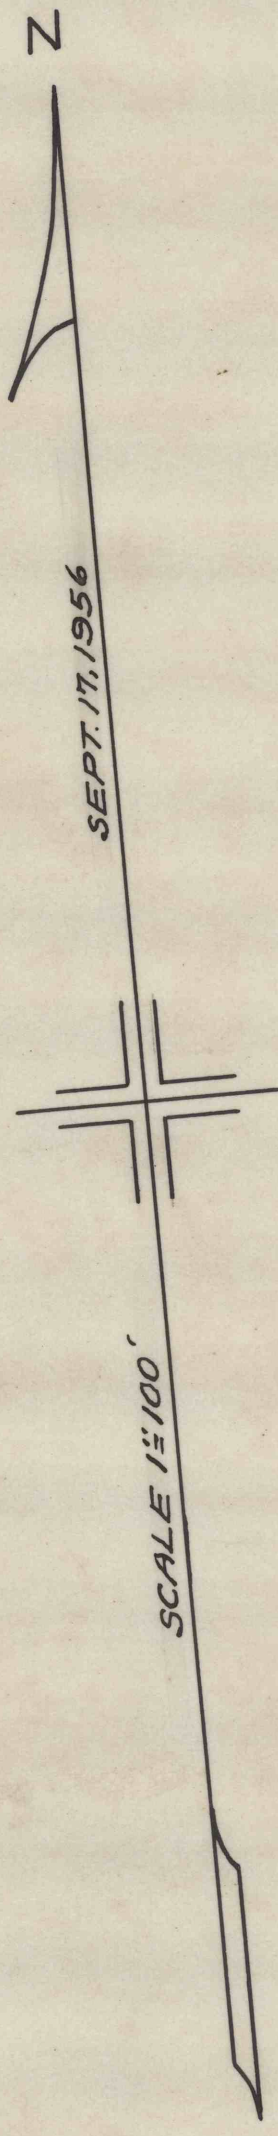

H. RECORDS

TO KYLERTOWN

TOWNSHIP ROAD

T. H. FORCEY EST. K. & L. COAL CO.

PILLARS OUT

PILLARS OUT

PILLARS OUT

STRIPPING

STRIPPING

PILLARS OUT

B-6

B-5

B-4

B-3

ALEX S SHIELDS

D
C.D. 354

FLAT RUN