


FILES

93° 23
586° 37'E

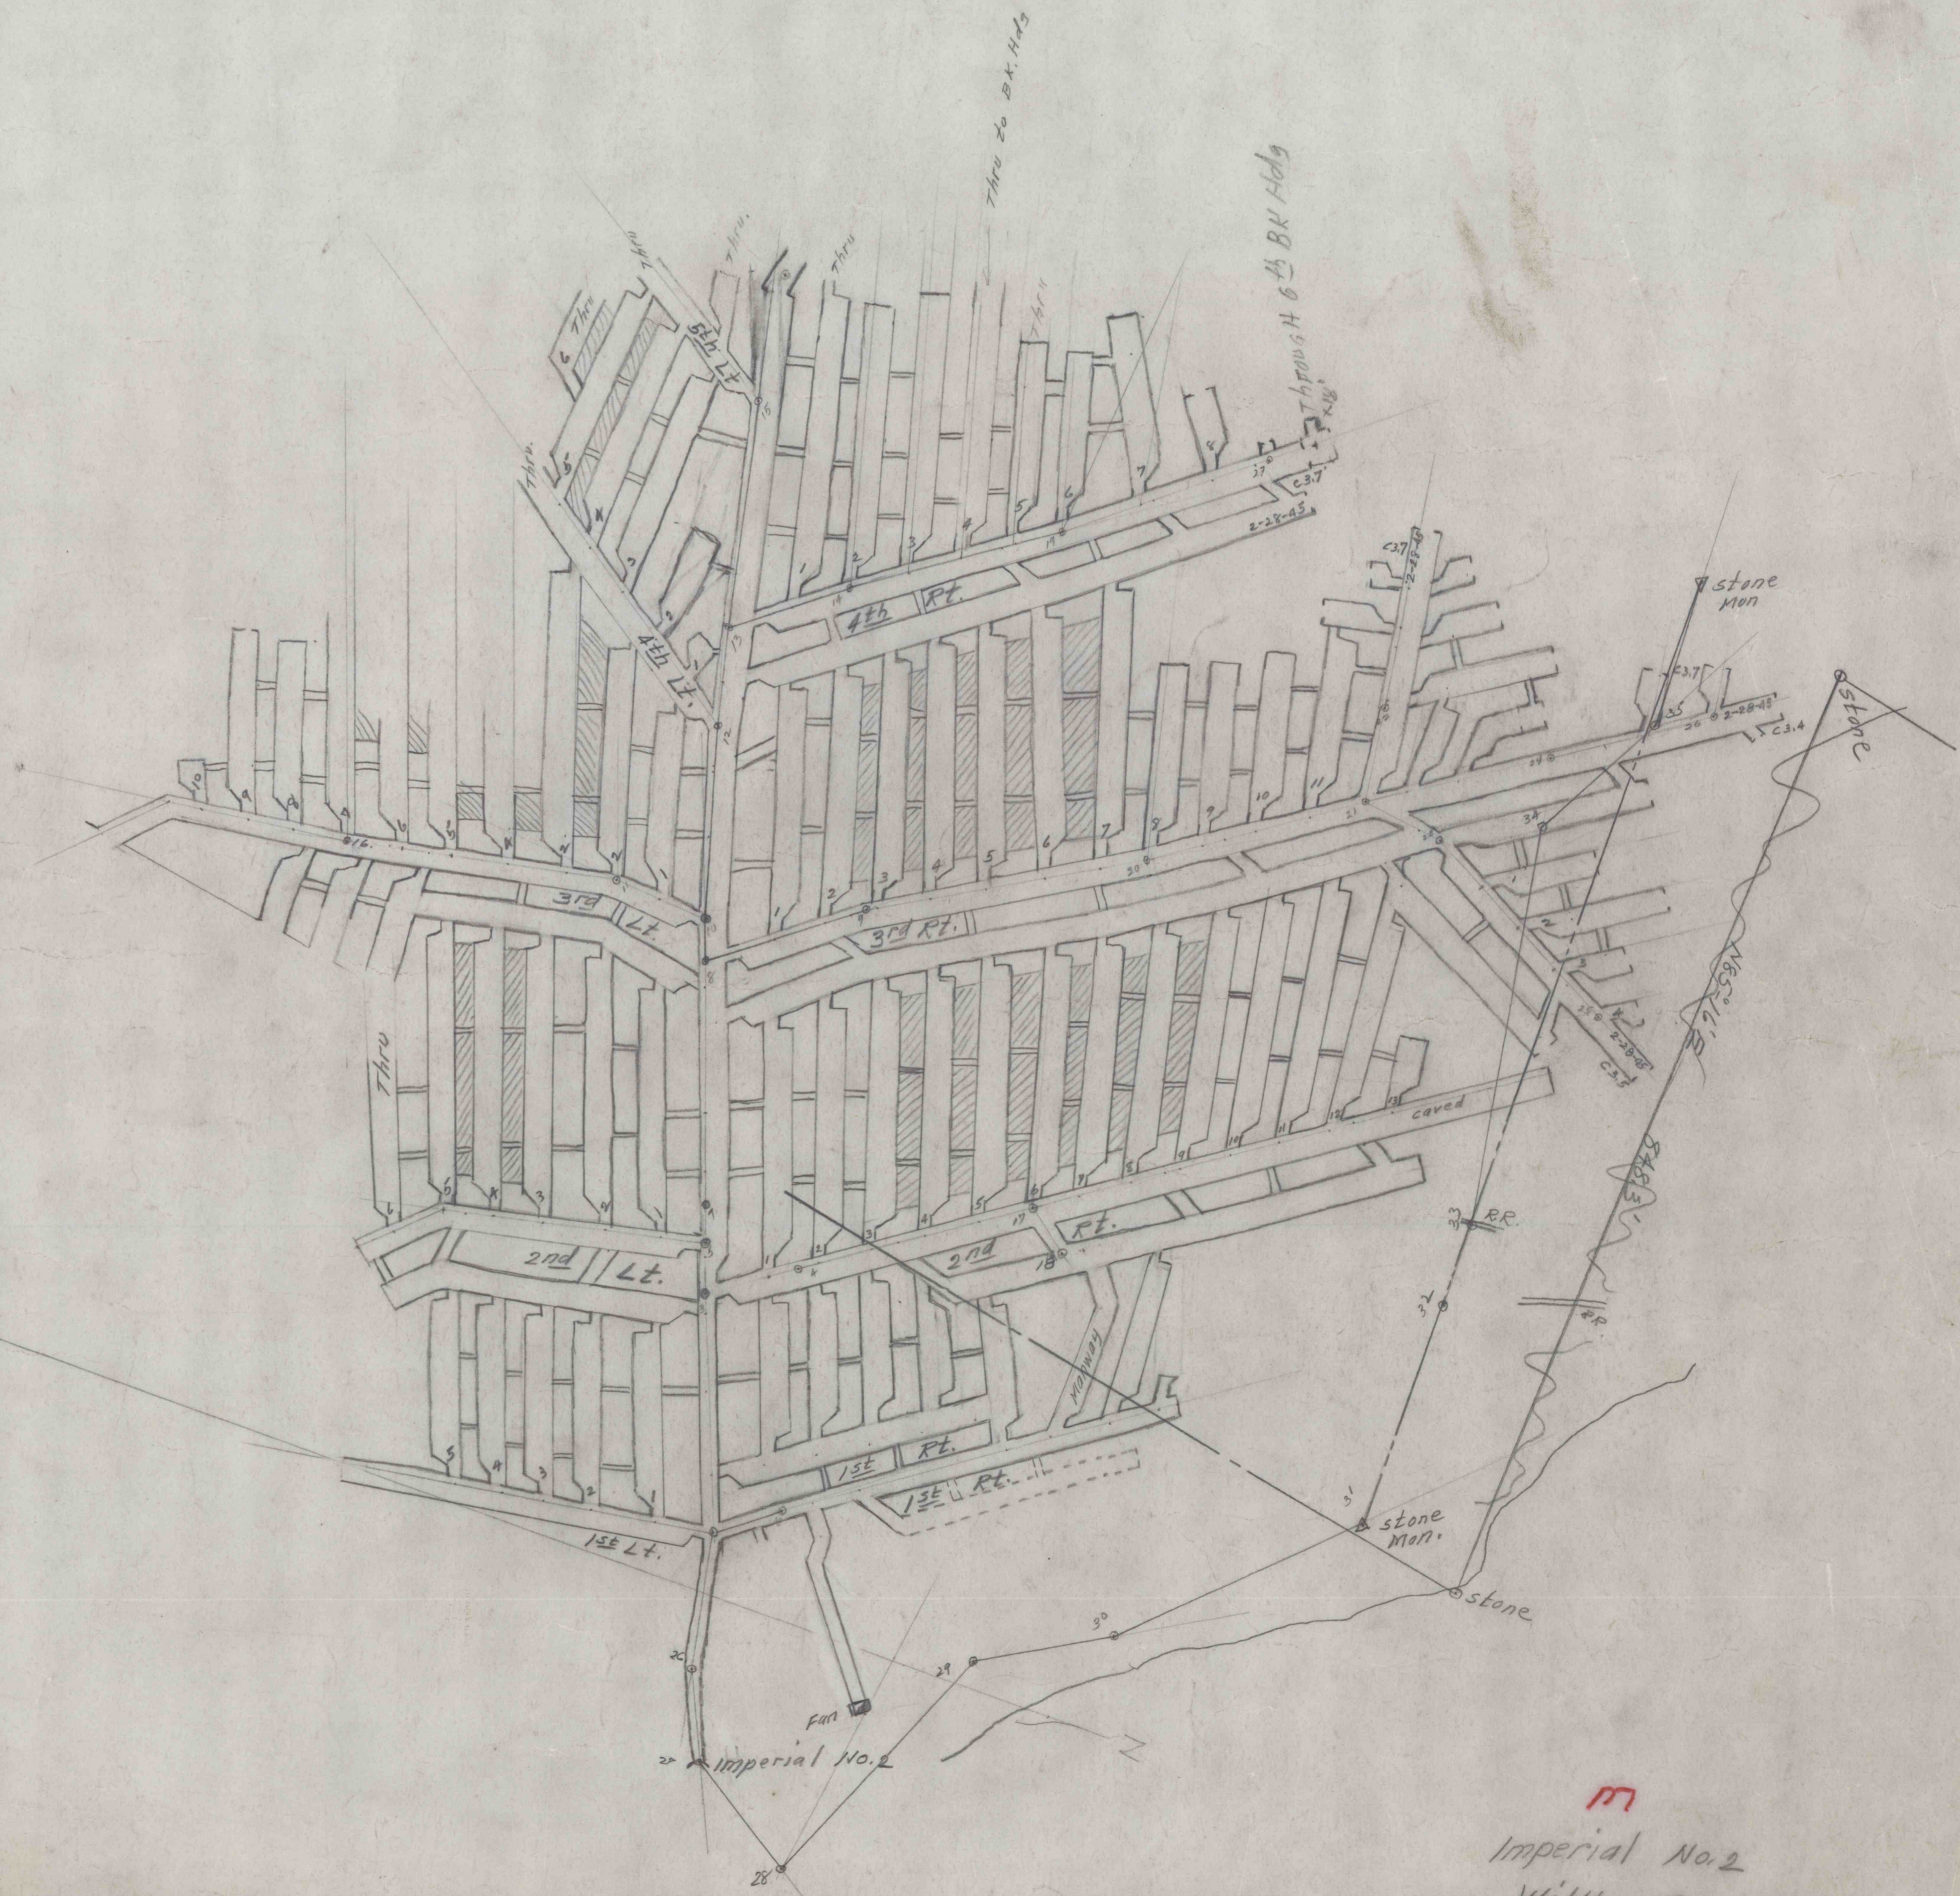

2314

m
 Imperial No. 2
 Wilks Coal Co.
 C.D. 224