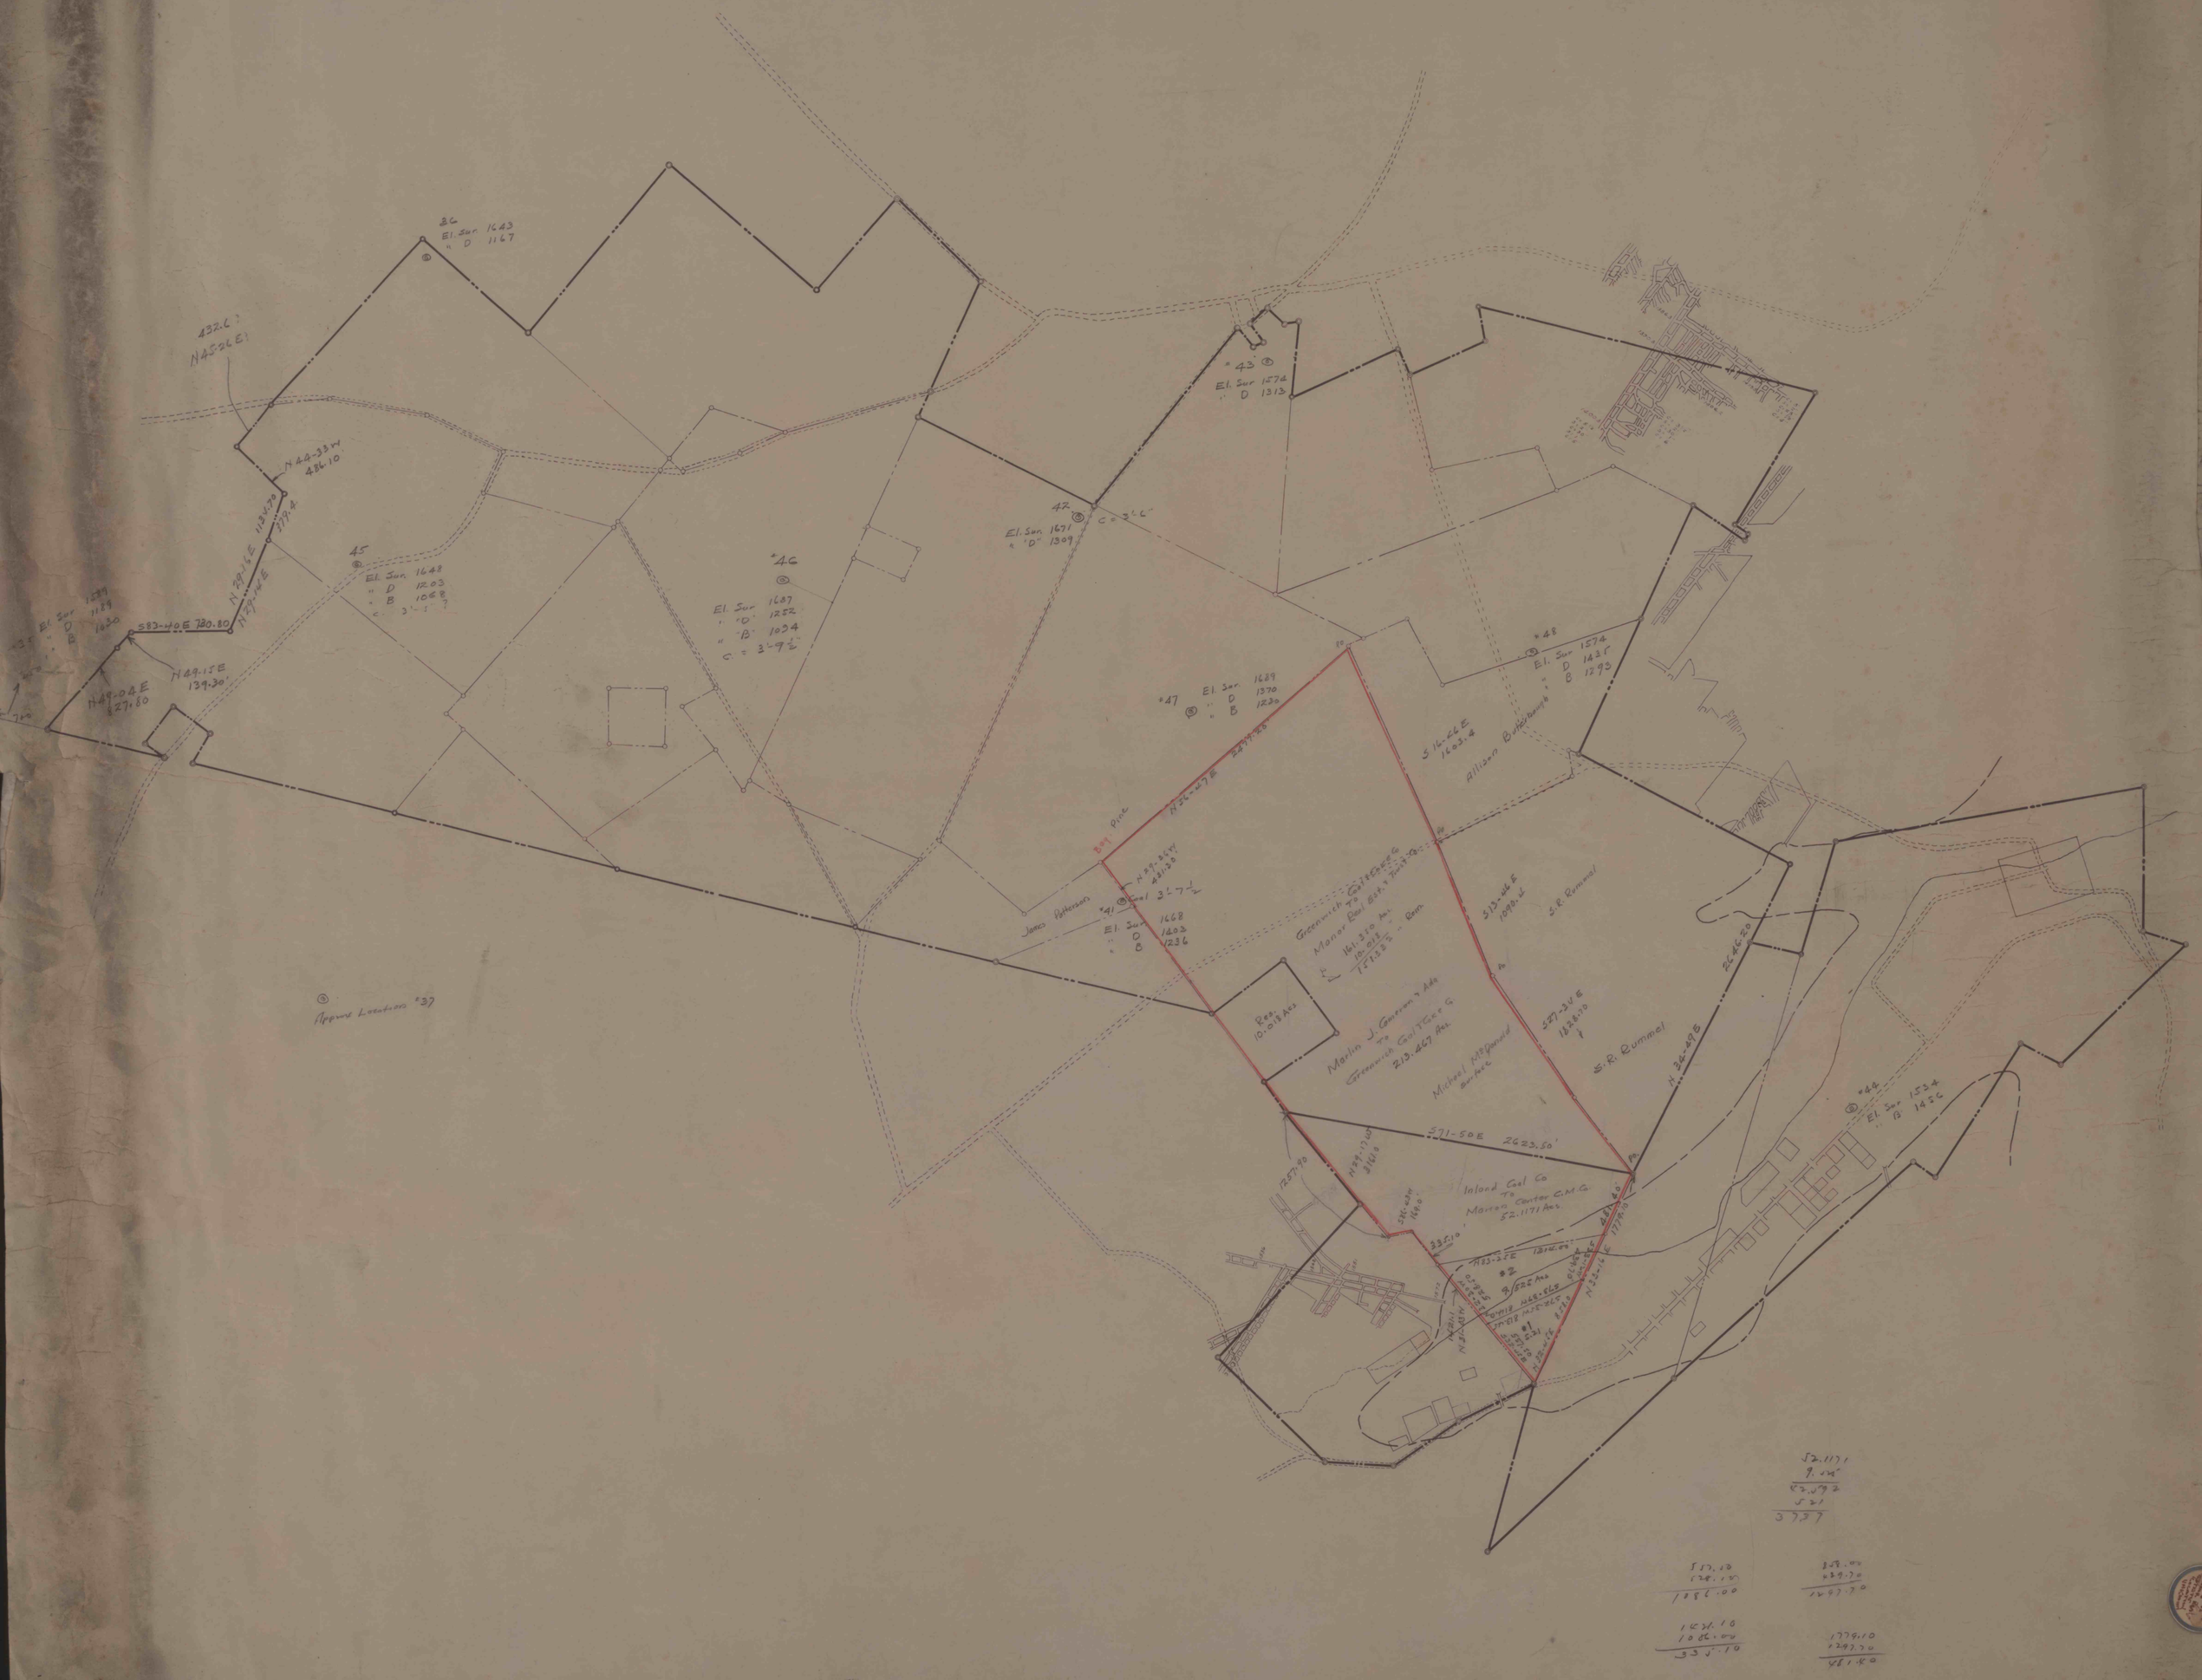

36
El. Sur. 1643
" D 1167
432.6'
N45-26E
N44-33W
486.10'
45
El. Sur. 1648
" D 1203
" B 1068
N29-16E 1134.70
N29-14E 379.4
S83-40E 780.80
N49-15E
139.30'
N49-04E
827.80
*46
El. Sur. 1687
" "D" 1252
" "B" 1034
C = 3'-9½"
42
El. Sur. 1671
" "D" 1309
C = 3'-6"
*43
El. Sur. 1574
" D 1313
*47
El. Sur. 1689
" D 1370
" B 1230
*48
El. Sur. 1574
" D 1435
" B 1293
S16-26E
1603.4
Allison Butterbaugh
N56-47E 2479.20
Bay Pine
N29-36W
481.30
Coal 3'-7½
*41
El. Sur. 1668
" D 1403
" B 1236
James Patterson
Greenwich Coal & Coke Co
To
Manor Real Est. & Trust Co
161.350 Acs.
10.018
151.332 " Rem.
S13-46E
1090.4
S.R. Rummel
Res.
10.018 Acs
Marlin J. Cameron & Ada
To
Greenwich Coal & Coke Co
213.467 Acs.
Michael McDonald
surface
S27-34E
1828.70
S.R. Rummel
N34-49E
2646.20
*44
El. Sur. 1534
" B 1456
S71-50E 2623.50'
N29-17W
3161.0
1257.90
Inland Coal Co
To
Marion Center C.M.Co.
52.1171 Acs.
335.10'
N83-25E 1214.00
*2
9.525 Acs
*1
N33-16E 1779.10
481.40'
Approx Location #37
52.1171
9.525
42.592
521
3737
557.50
528.10
1086.00
858.00
439.70
1297.70
1431.10
1086.00
335.10
1779.10
1297.70
481.40