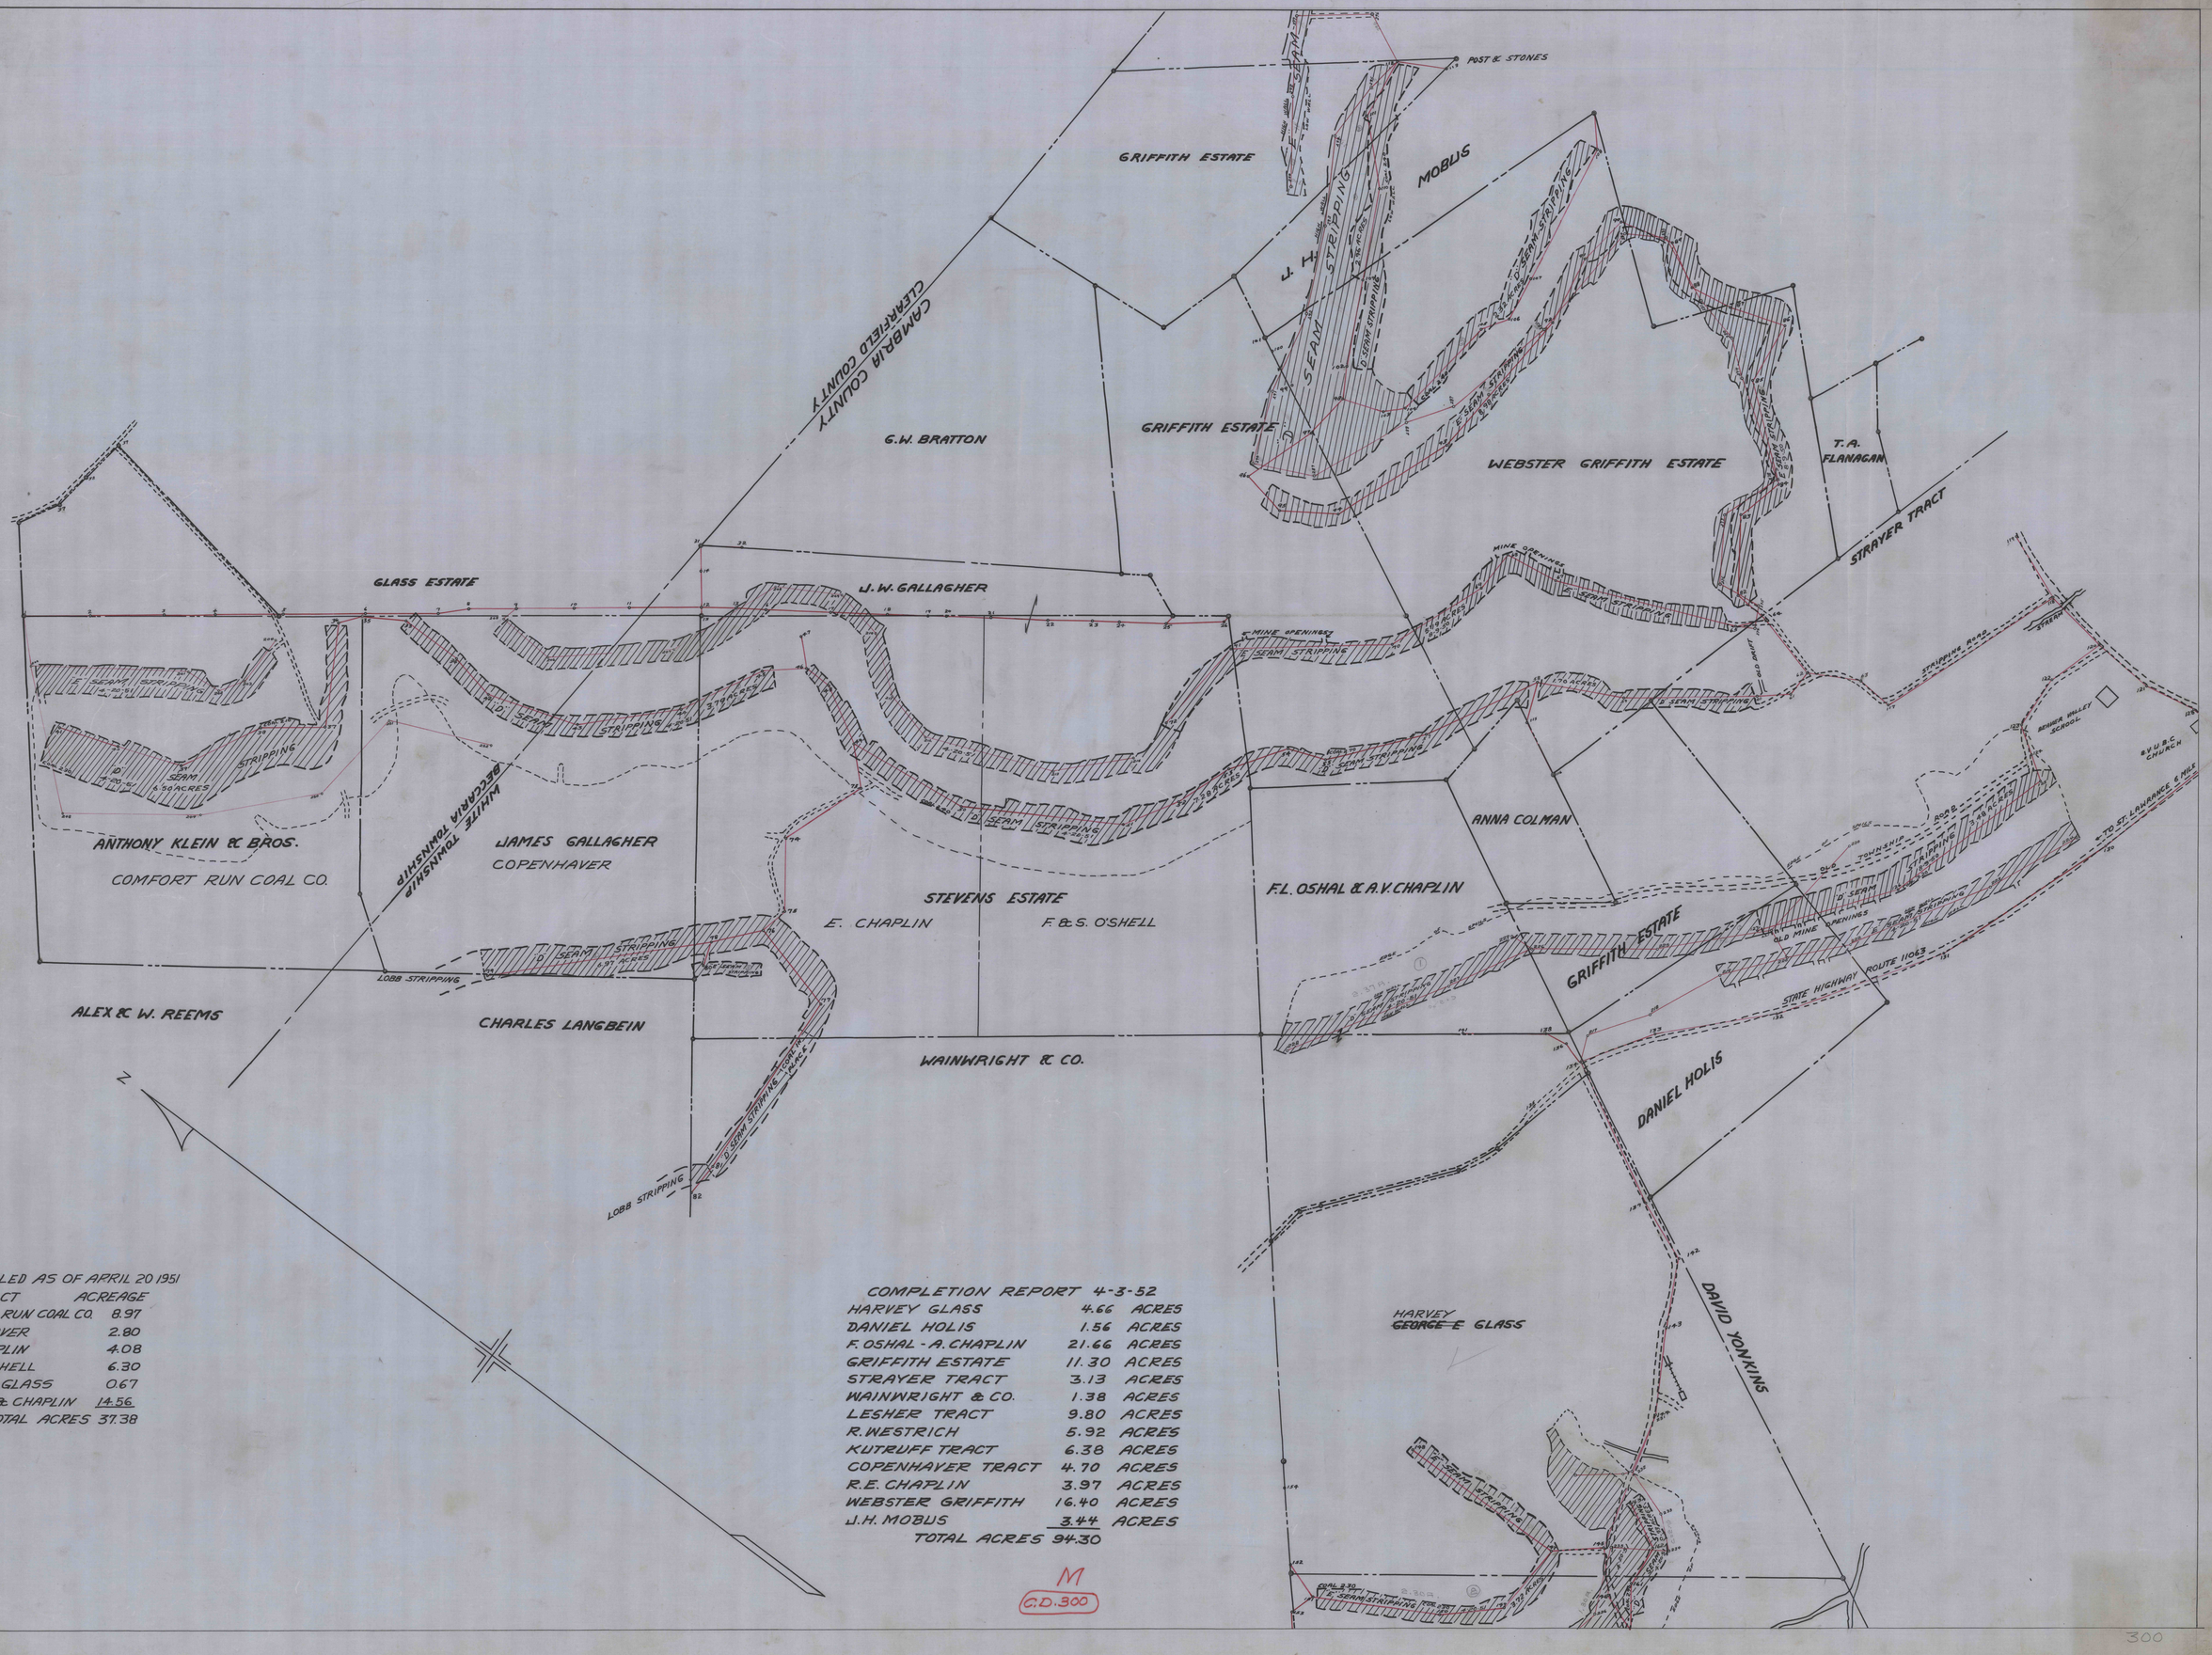

BACKFILLED AS OF APRIL 20 1951

TRACT	ACREAGE
COMFORT RUN COAL CO.	8.97
COPENHAVER	2.80
R.E. CHAPLIN	4.08
F. & S. O'SHELL	6.30
HARVEY GLASS	0.67
O'SHELL & CHAPLIN	14.56
TOTAL ACRES	37.38

COMPLETION REPORT 4-3-52

HARVEY GLASS	4.66	ACRES
DANIEL HOLIS	1.56	ACRES
F. OSHAL - A. CHAPLIN	21.66	ACRES
GRIFFITH ESTATE	11.30	ACRES
STRAYER TRACT	3.13	ACRES
WAINWRIGHT & CO.	1.38	ACRES
LESHER TRACT	9.80	ACRES
R. WESTRICH	5.92	ACRES
KUTRUFF TRACT	6.38	ACRES
COPENHAVER TRACT	4.70	ACRES
R.E. CHAPLIN	3.97	ACRES
WEBSTER GRIFFITH	16.40	ACRES
J.H. MOBUS	3.44	ACRES
TOTAL ACRES	94.30	

M

C.D.300

2420

300