


5175/2.2

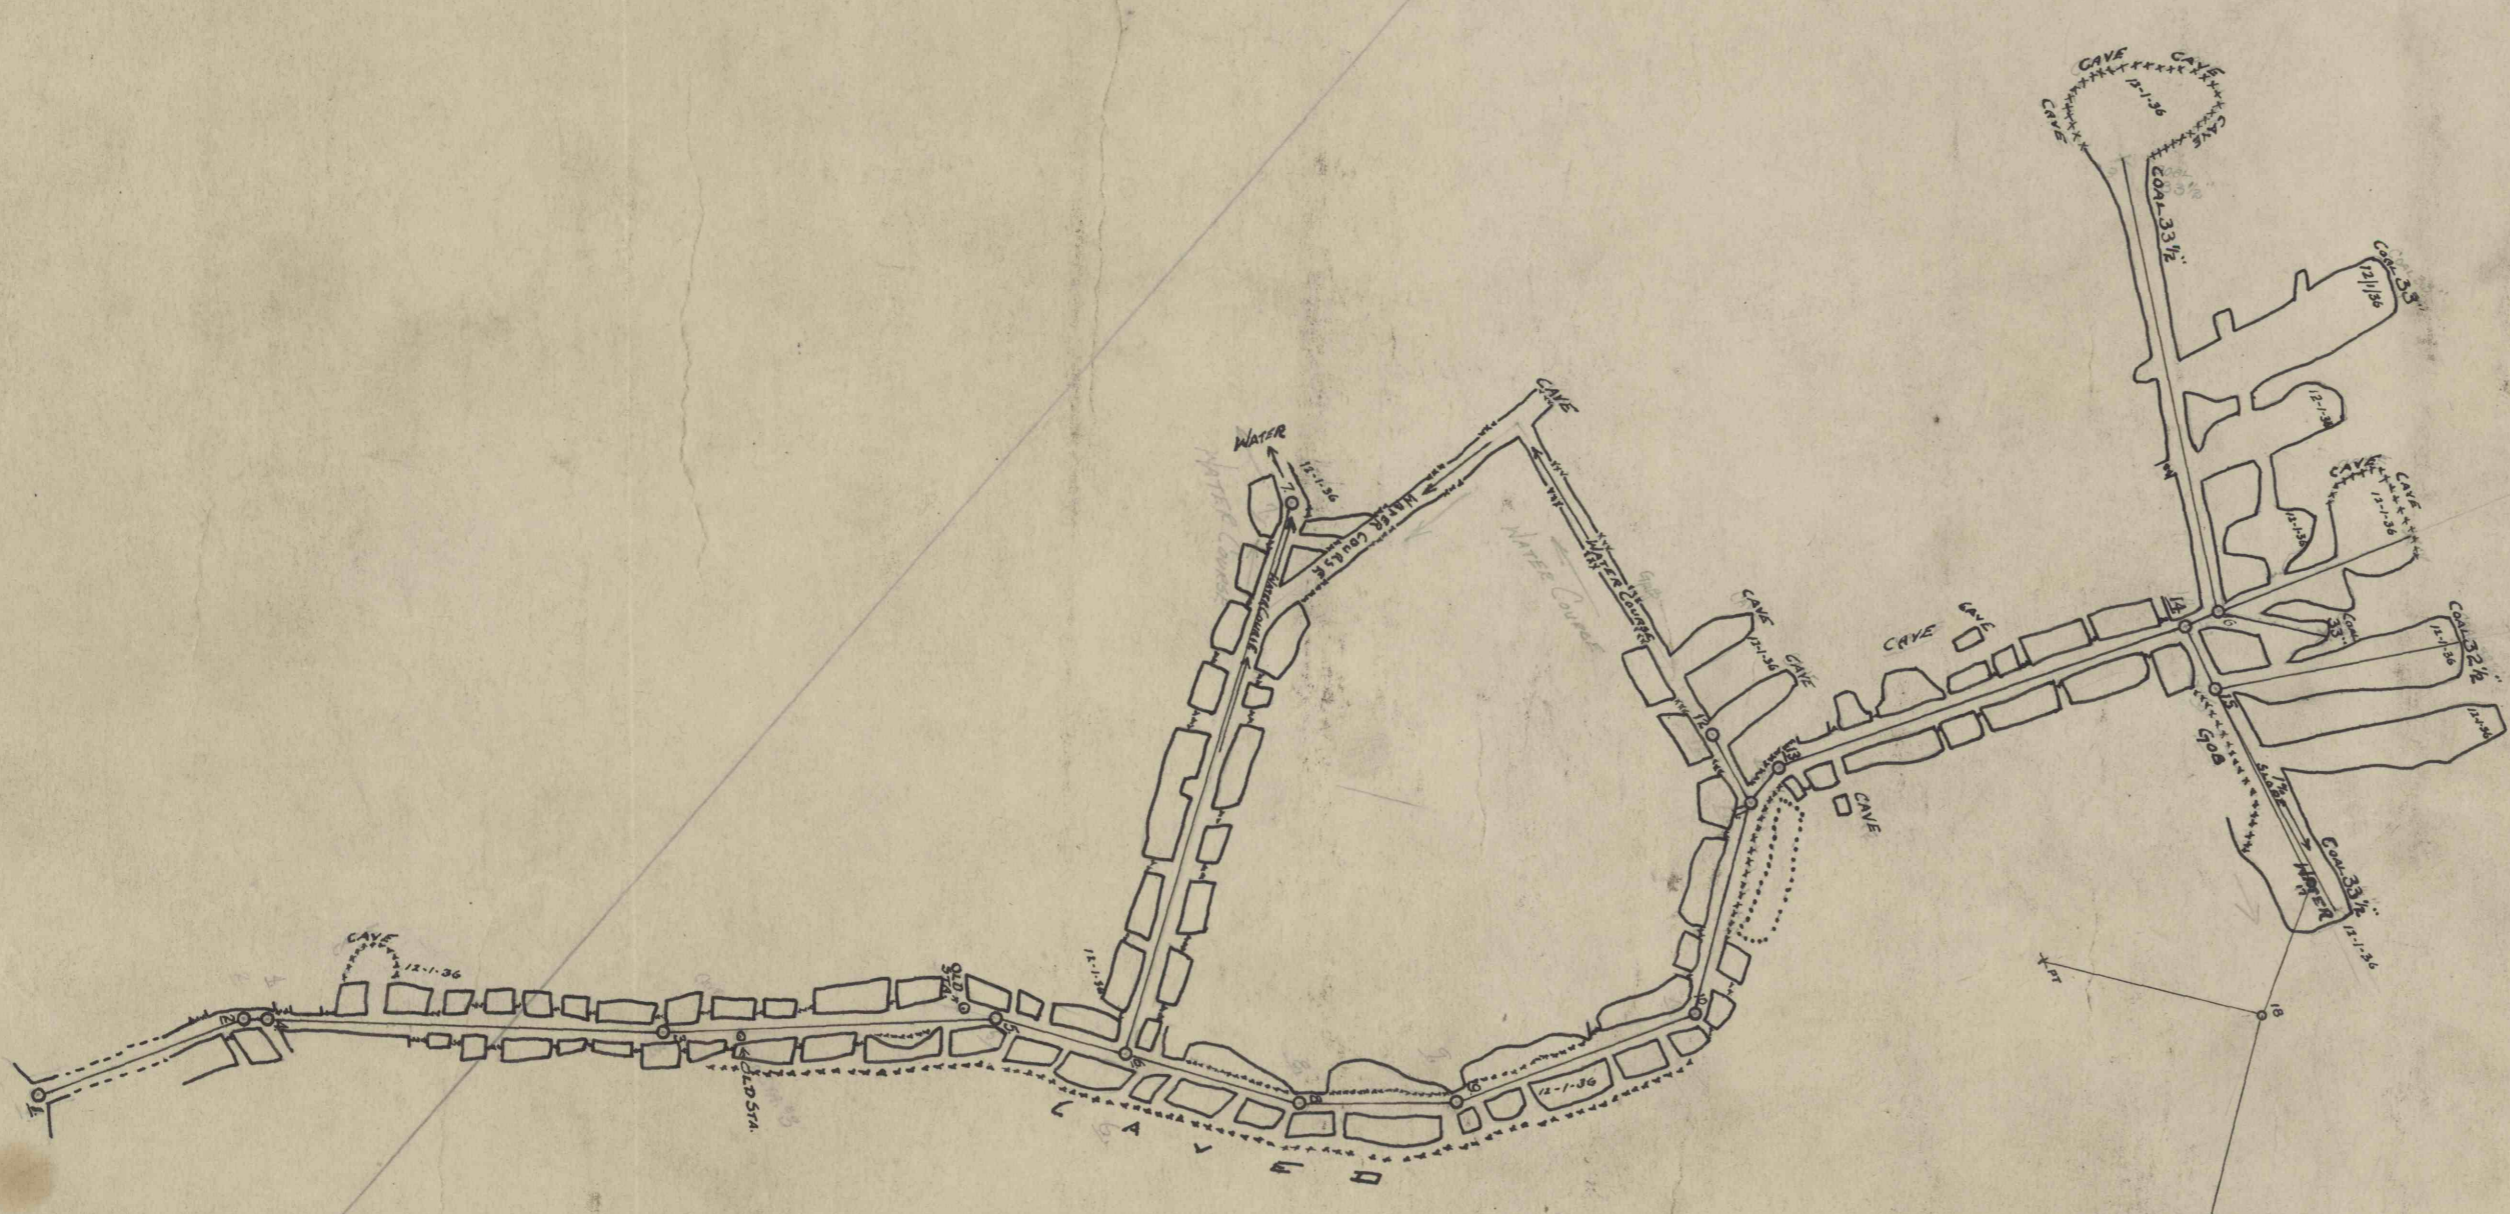

375 Quers, Sub
16, 132

MAPES

D

10528

MAPES

2615