


2786

2786

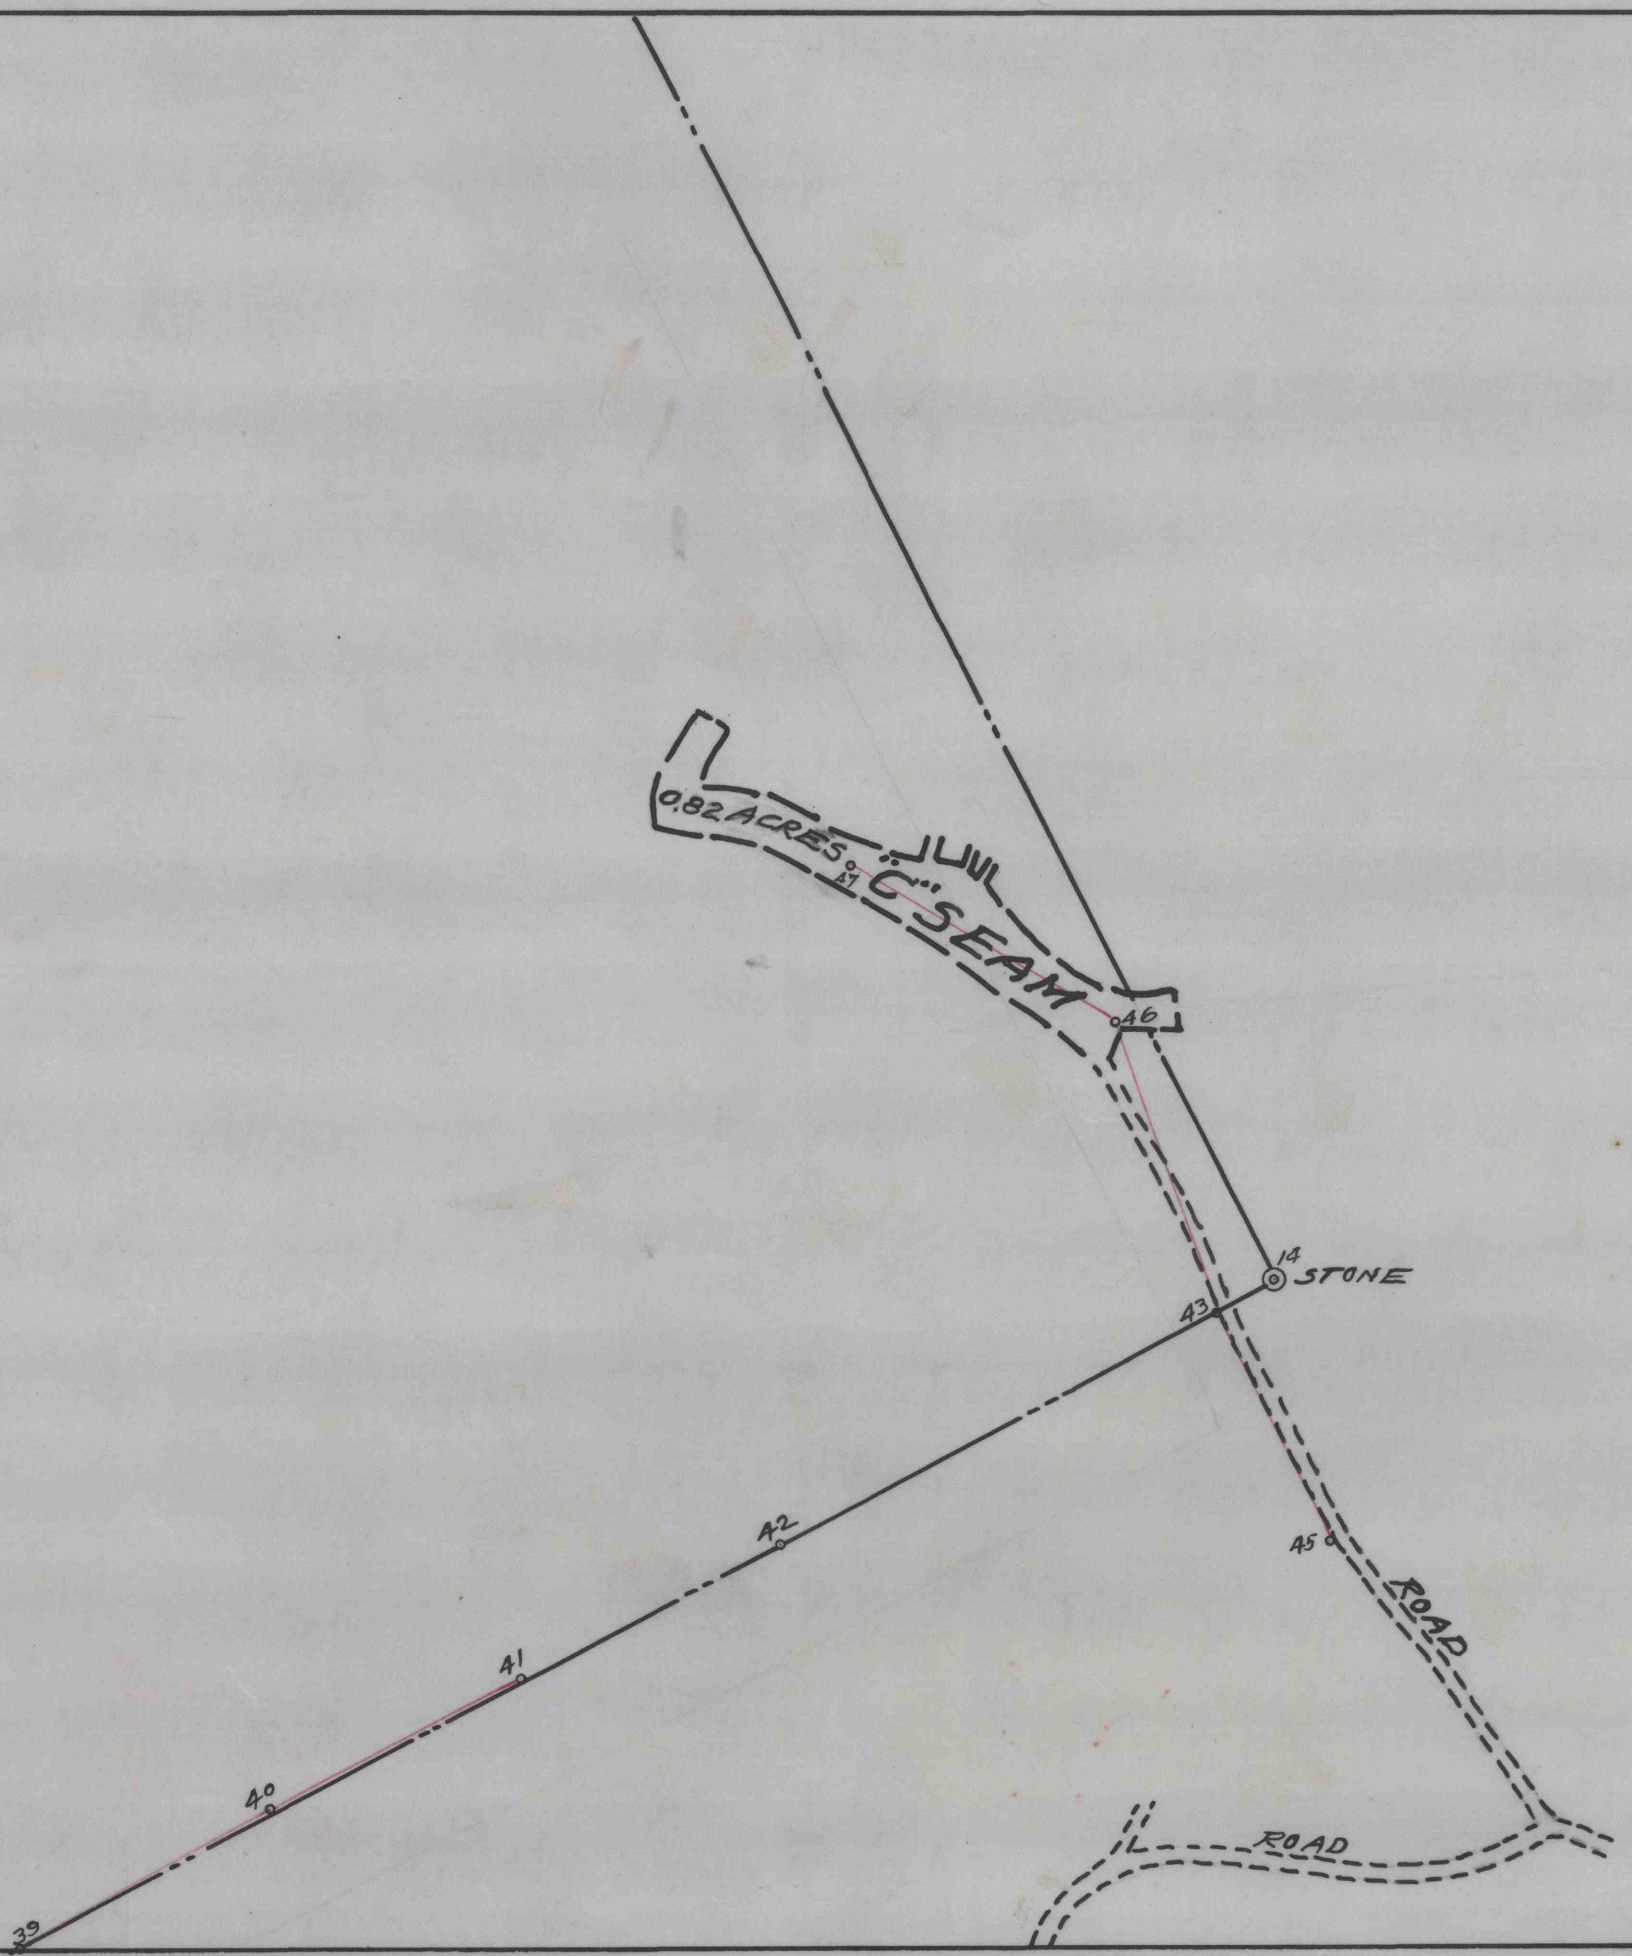

PM
C.D. 216