


273

5610

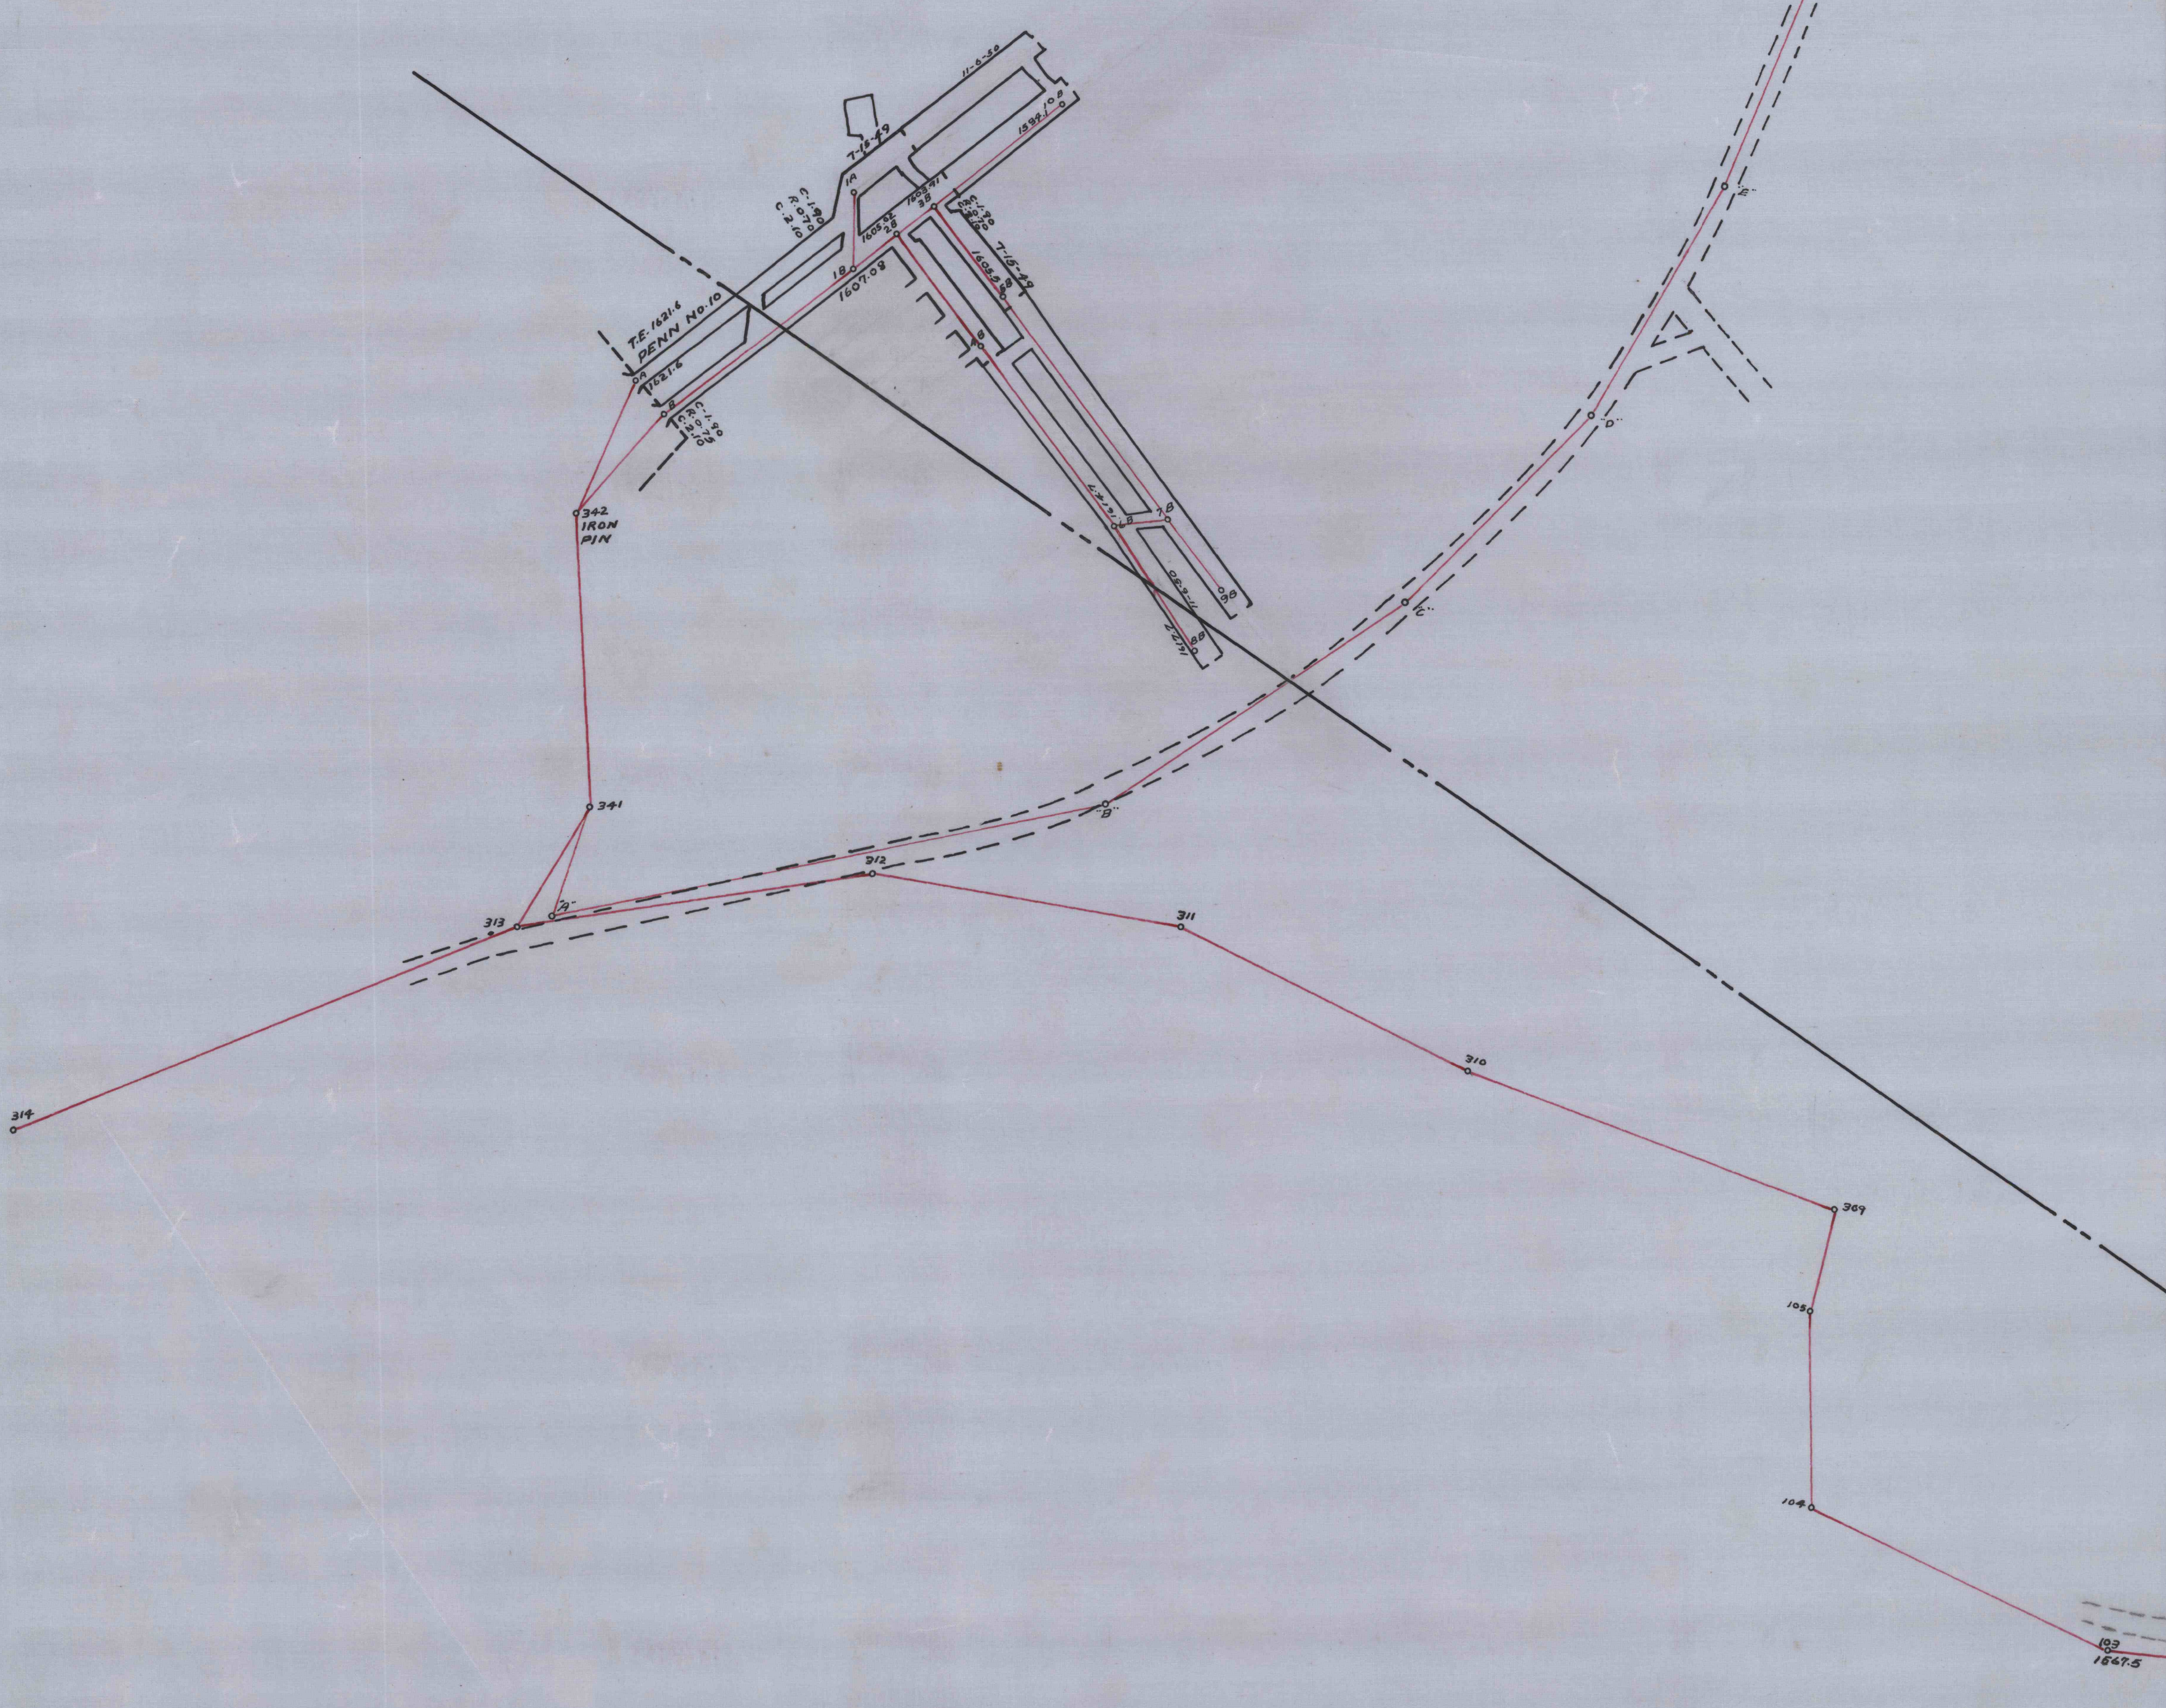

D  
 CD. 252