


12821

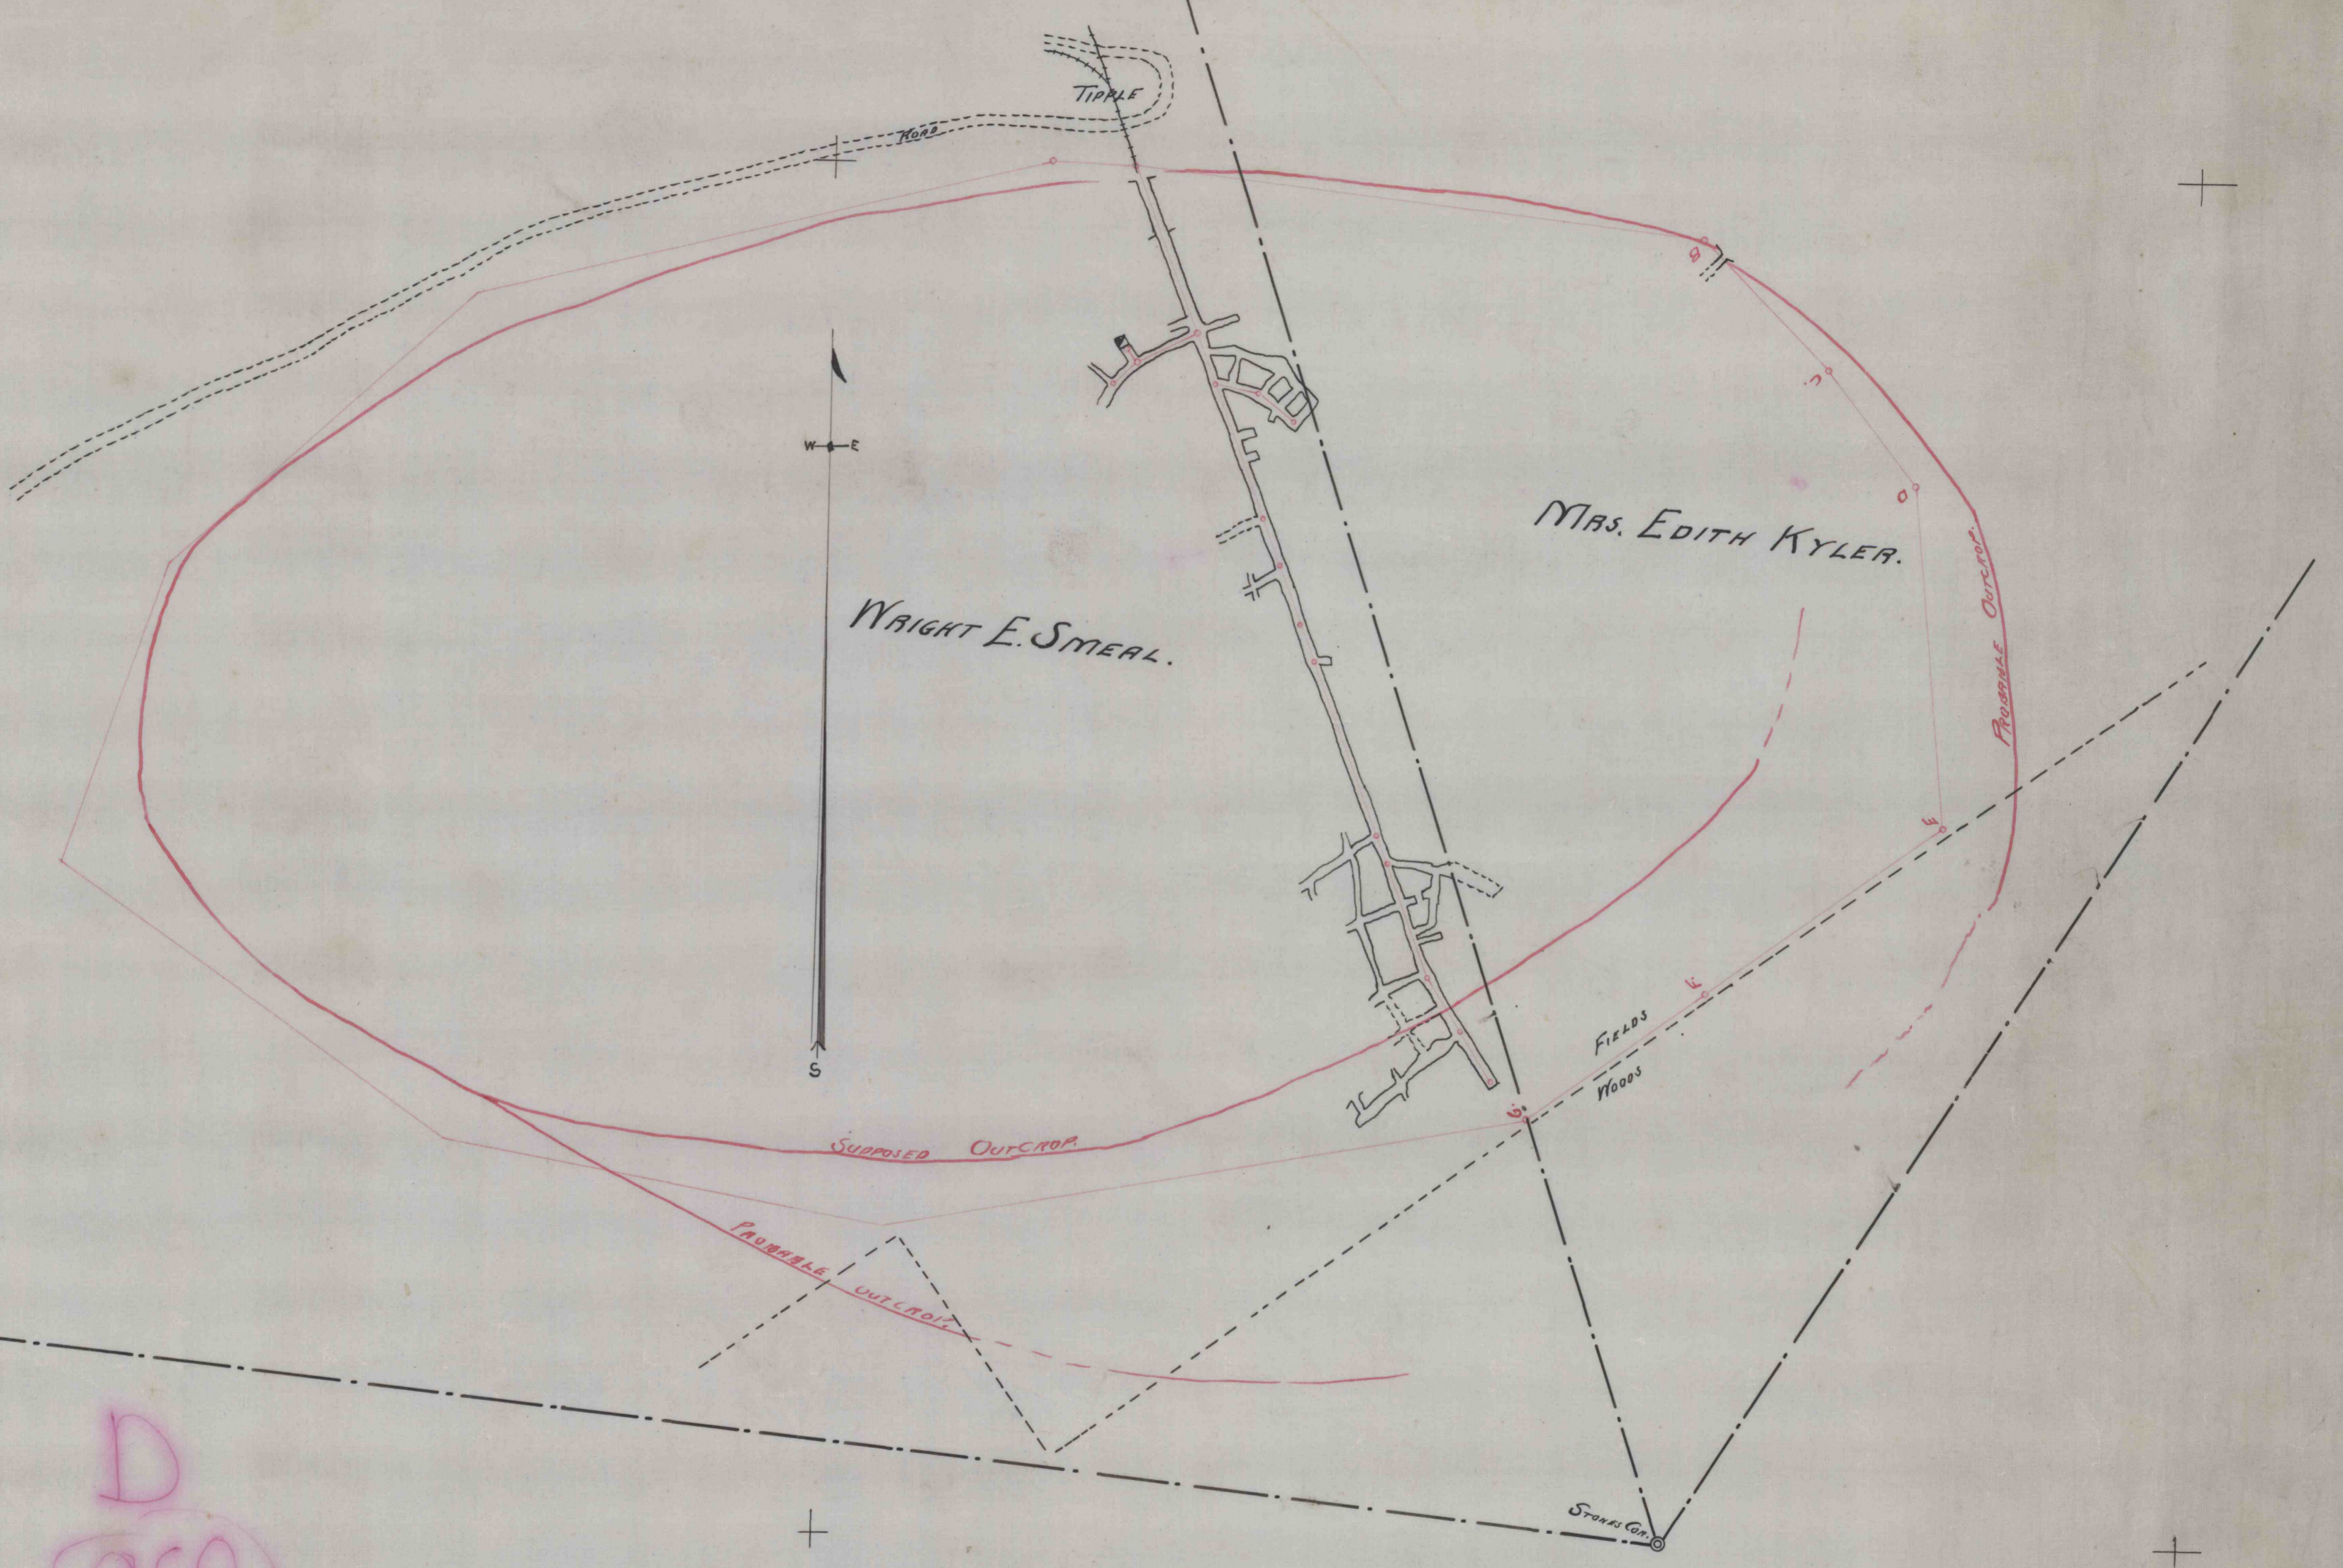

D
960

12821