


AVERAGE SECTION OF
COAL VEIN
UNDER J. E. KIRK EST.
1.216 AC.
SCALE 1/4\"/>

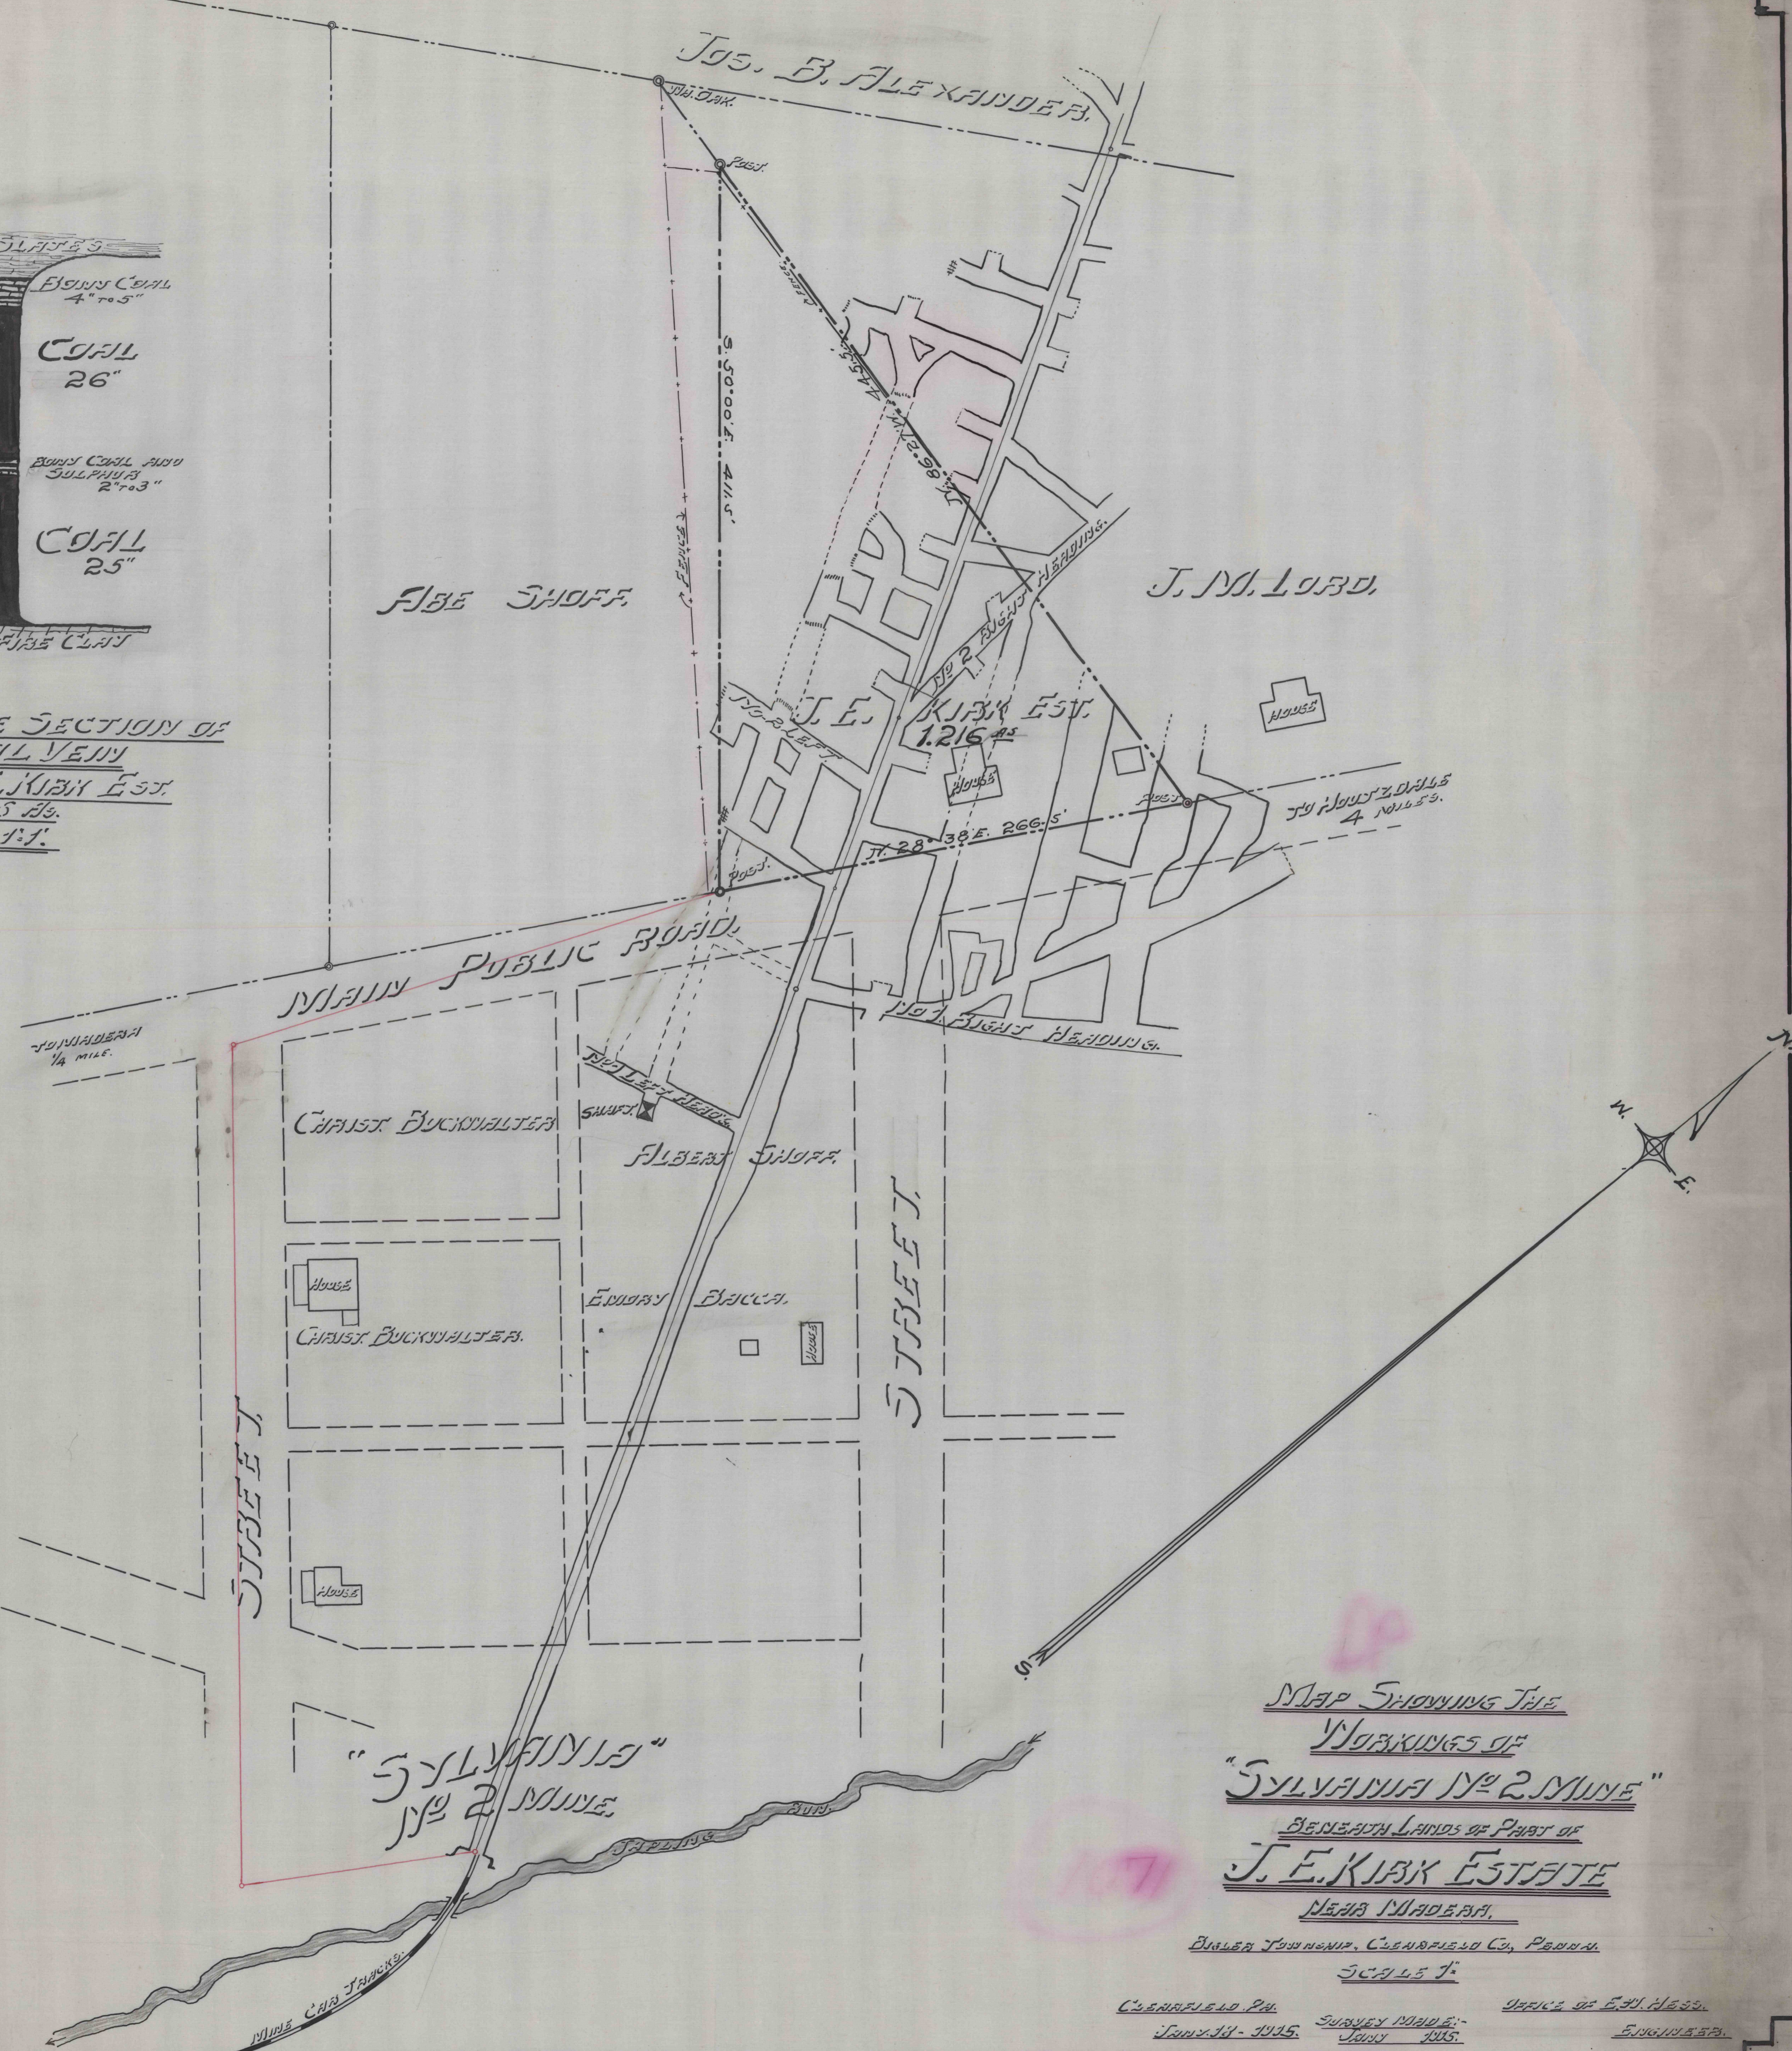

MAP SHOWING THE
WORKINGS OF
"SYLVANIA No. 2 MINE"
BENEATH LANDS OF PART OF
J. E. KIRK ESTATE
NEAR MADEIRA,

BULLER TOWNSHIP, CLEARFIELD CO., PENN.
SCALE 1/4"
CLEARFIELD PA.
JUNY 14 - 1915.
OFFICE OF E. W. HESS,
ENGINEER.
SURVEY MADE:
JUNY 1915.