


11/8
0715

3170

871

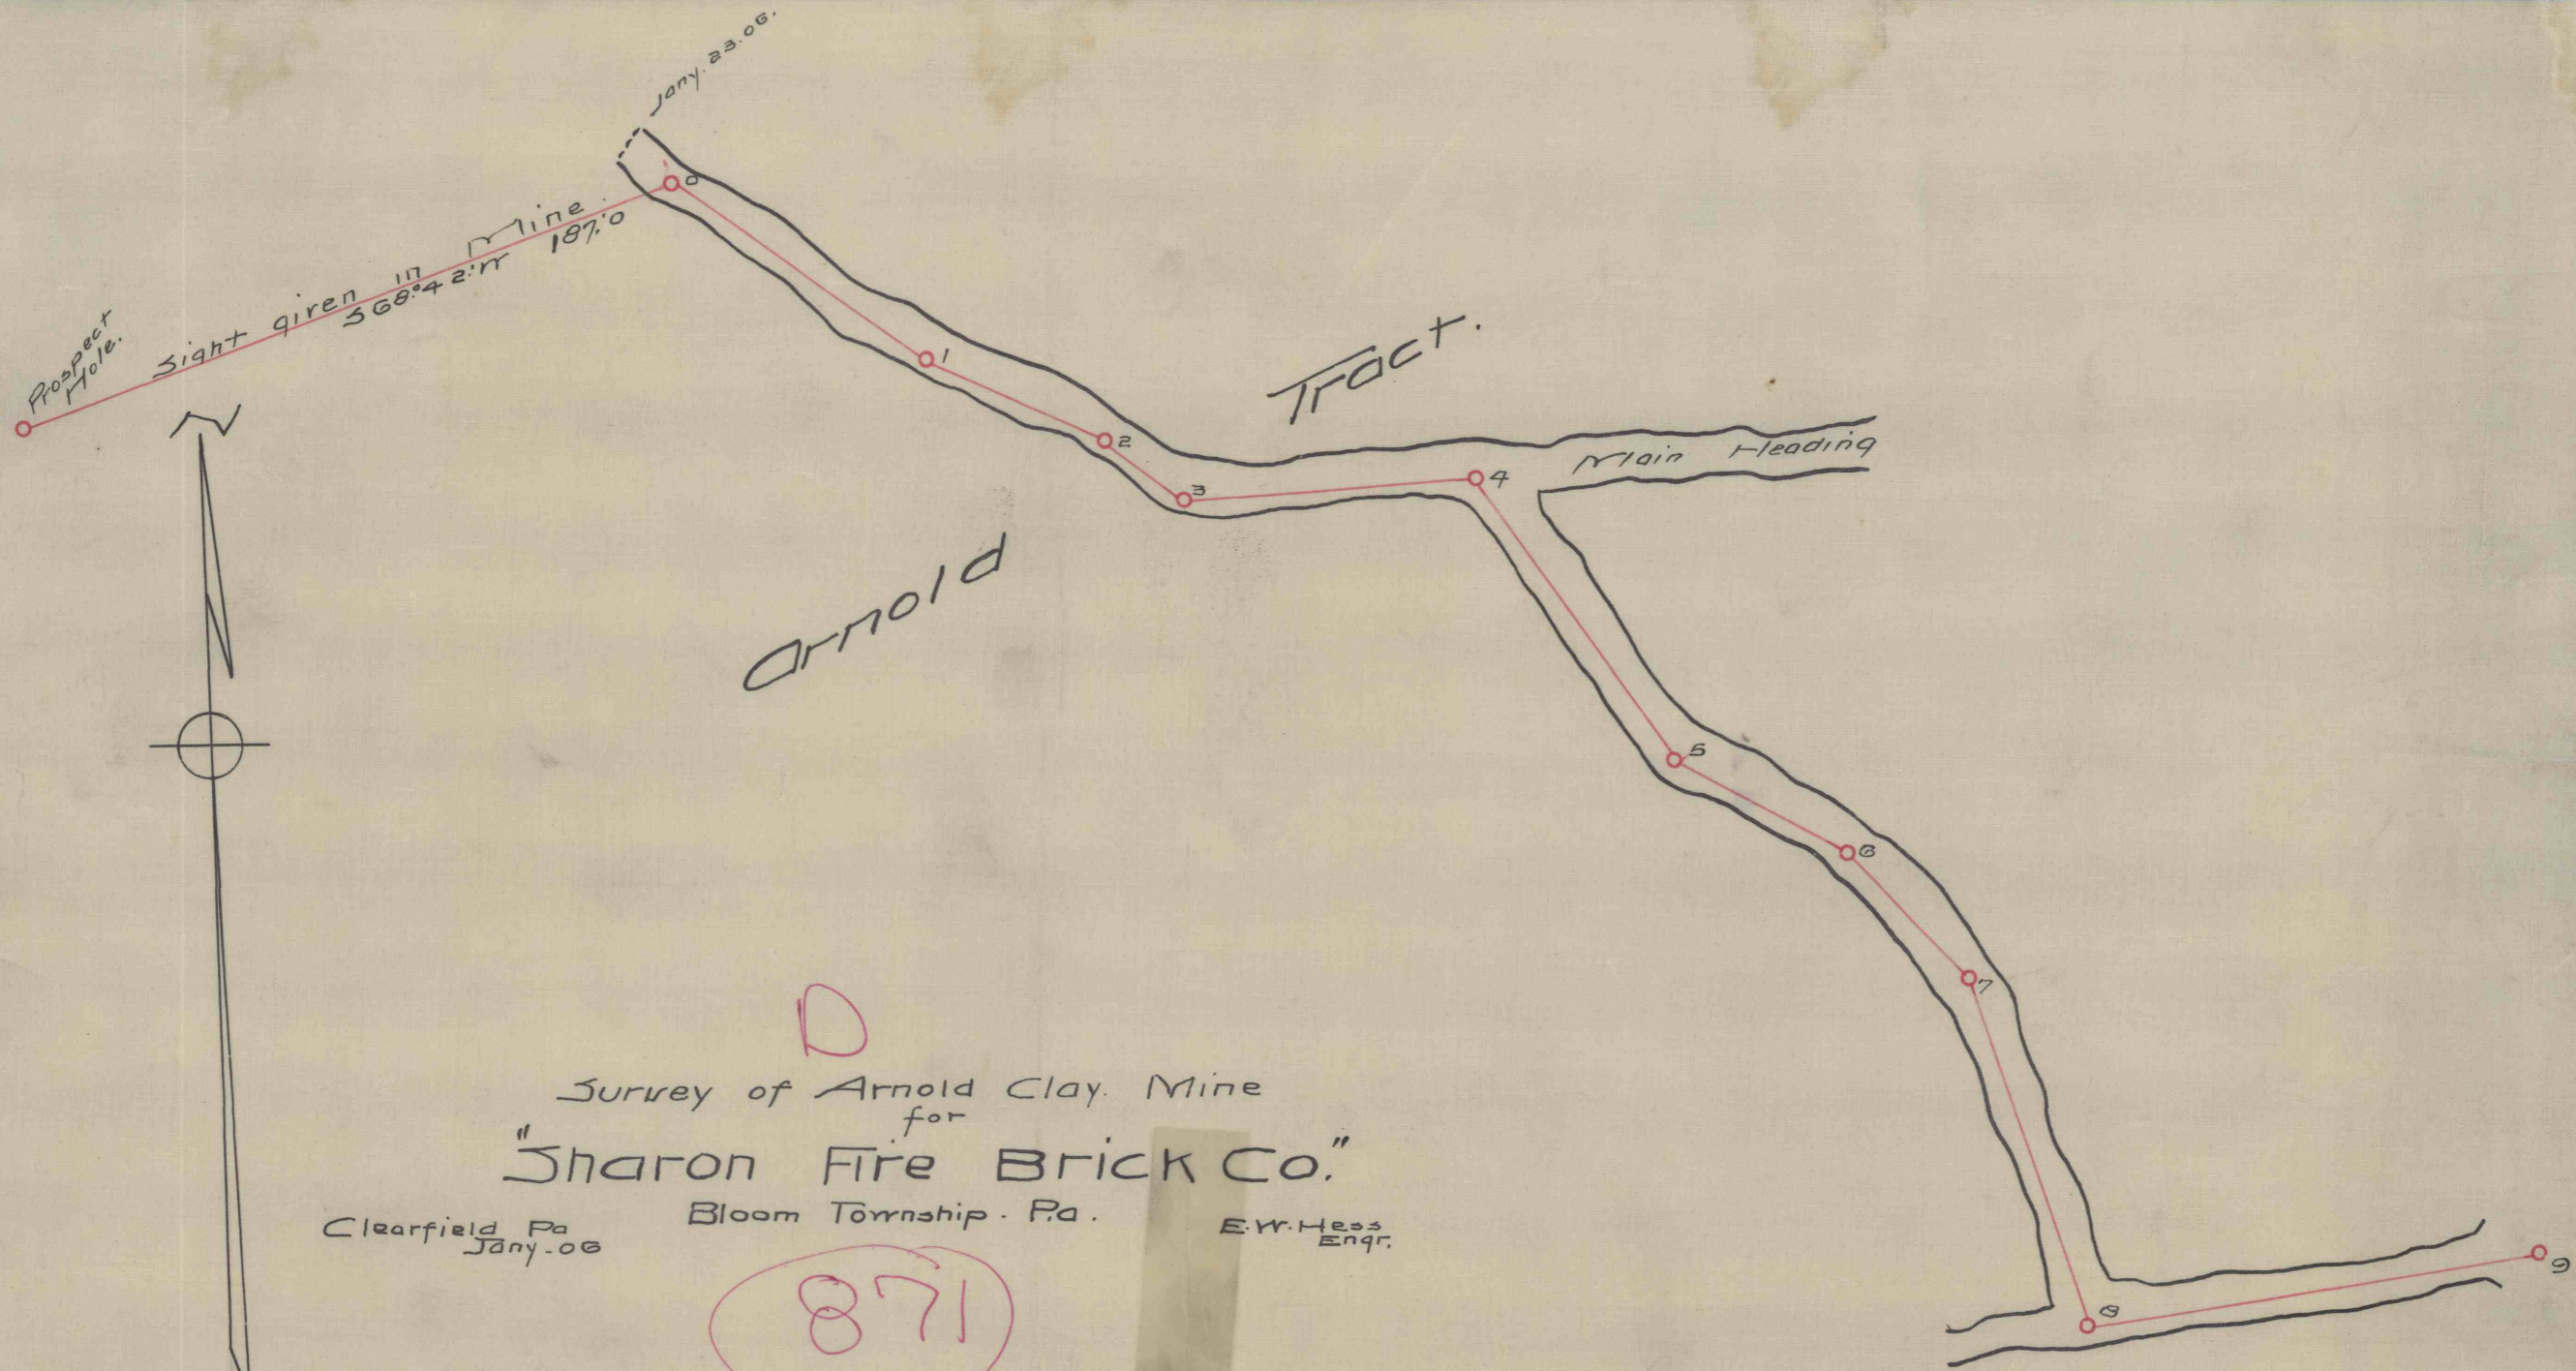

871

871