


5000
East of [unclear]

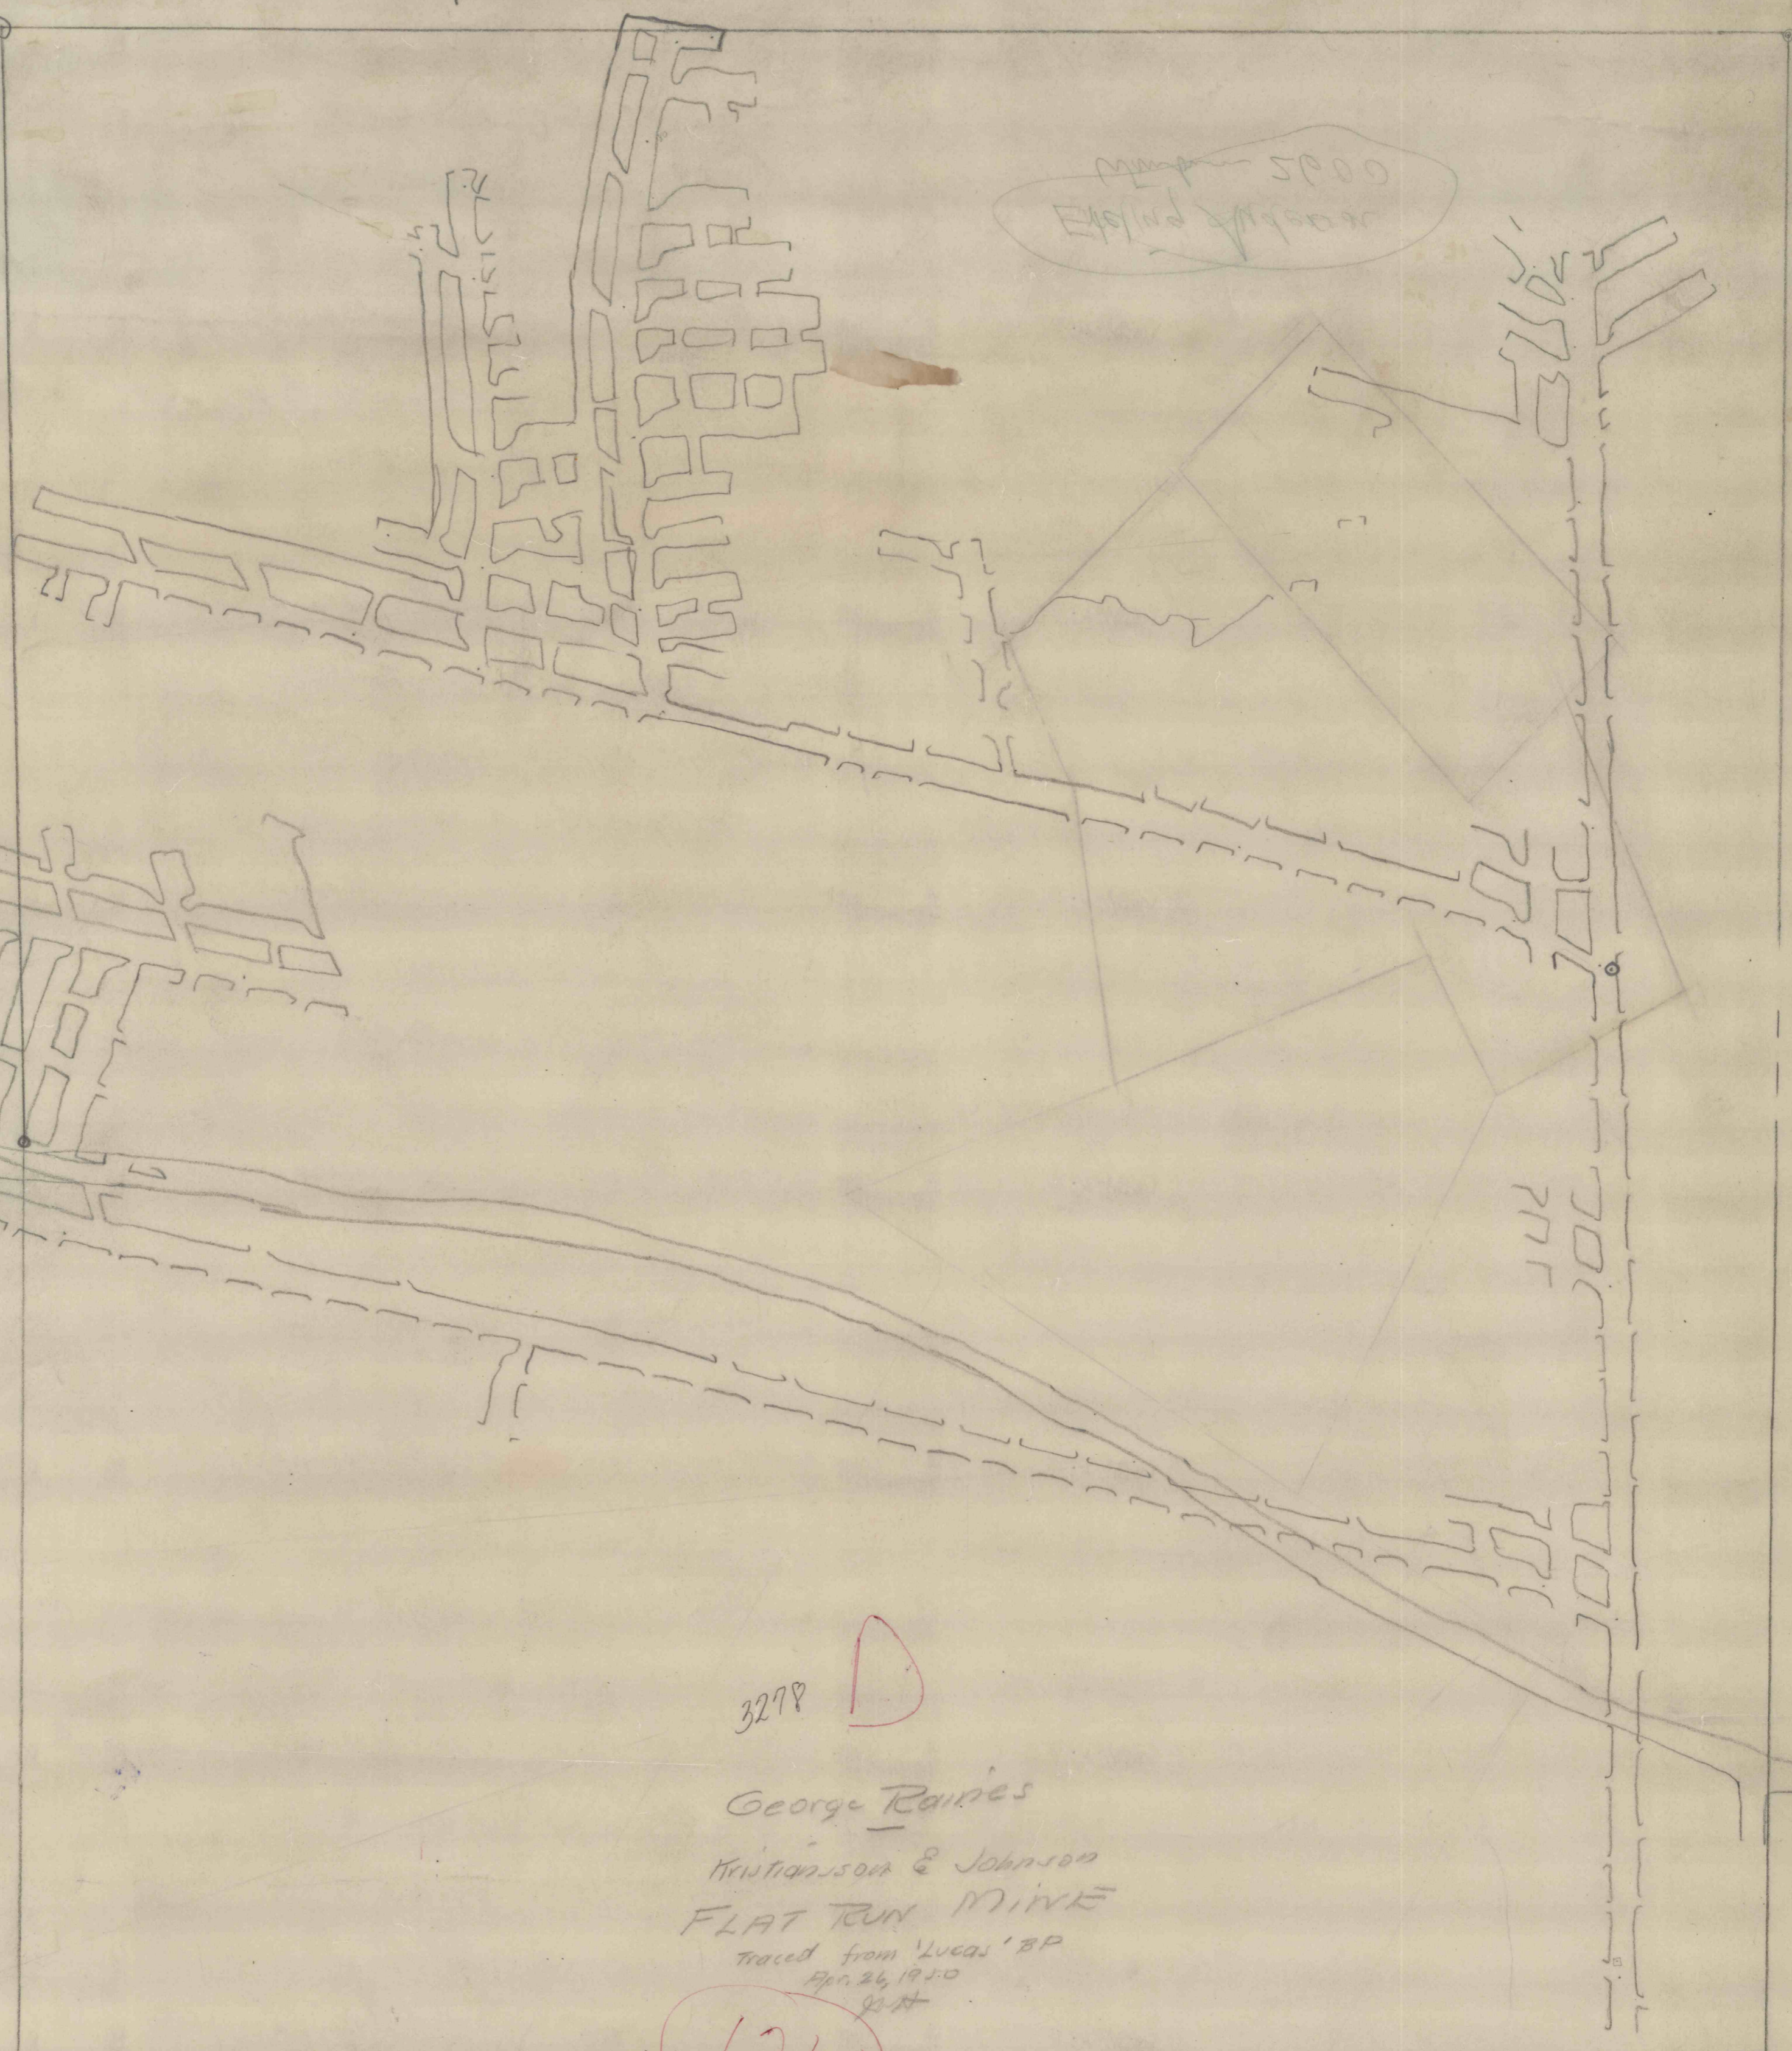

36
3863
7423

36
26.33
62.33

359.60
58.13
301.47

3278 D

George Raines
Kristianson & Johnson
FLAT RUN MINE
Traced from Lucas' BP
G.R.

1215