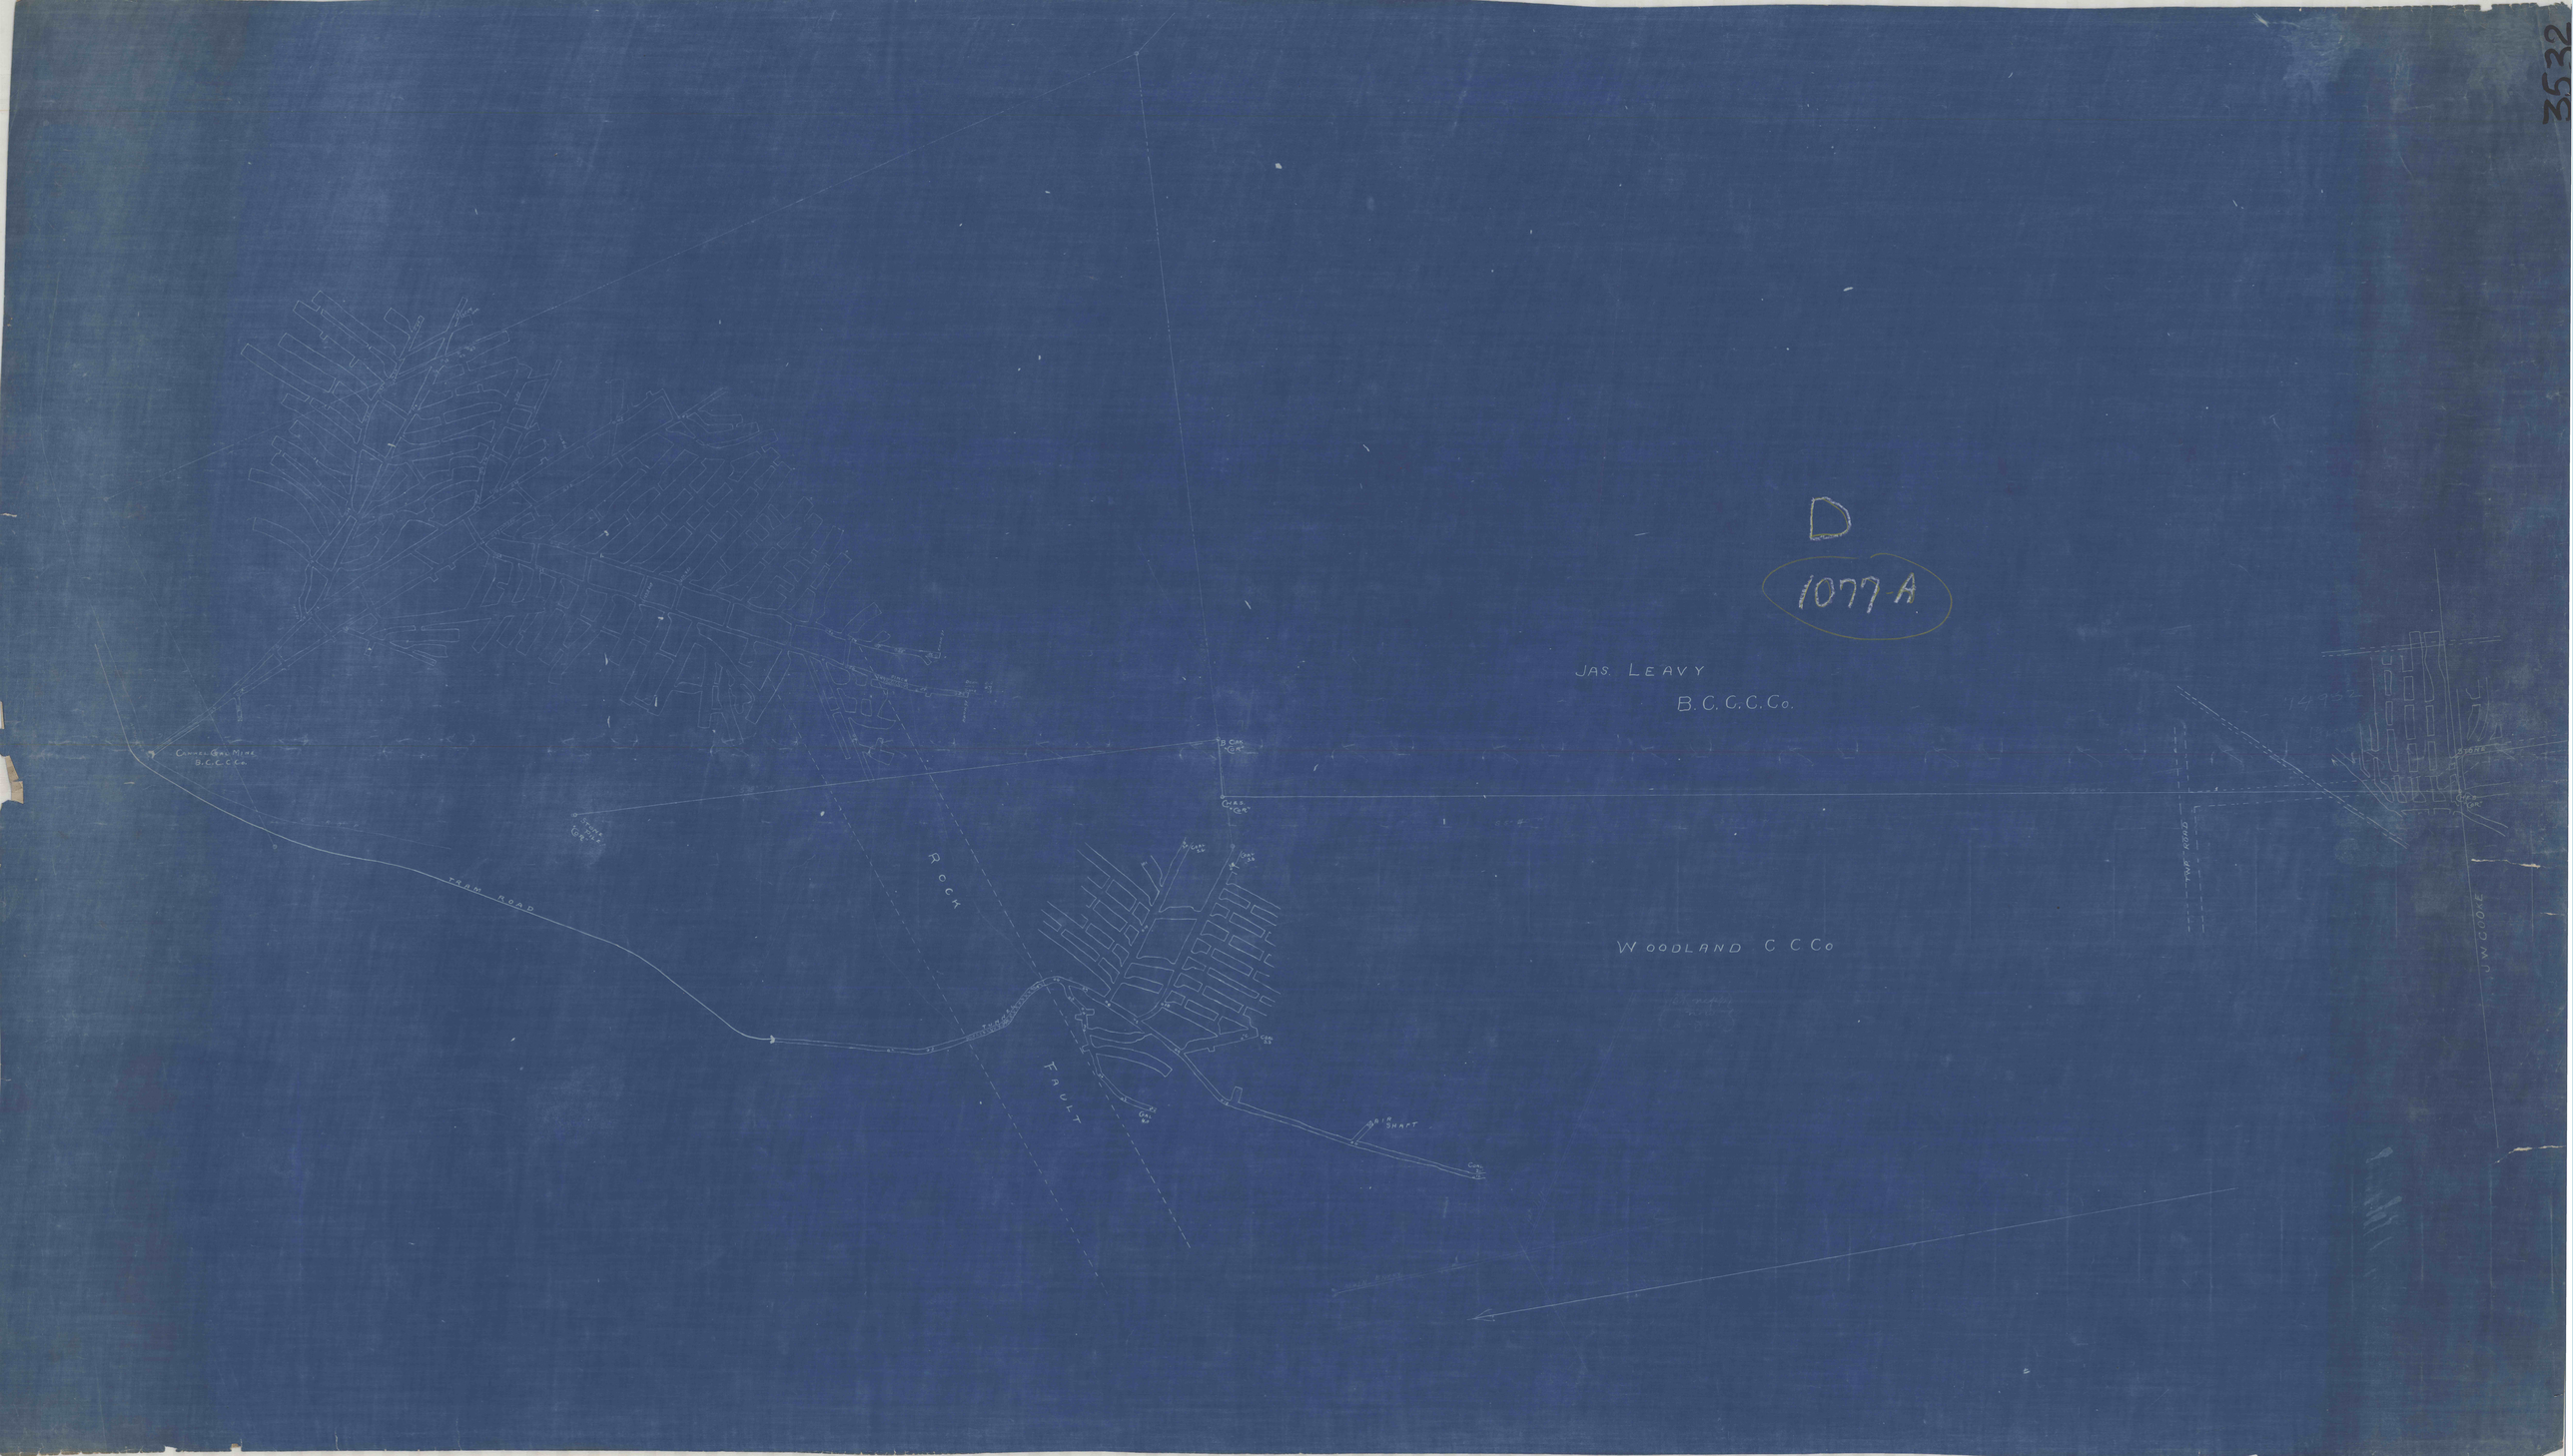
D
1077 A
JAS. LEAVY
B.C.C.C.Co.
B.C.C.Co.
B.CAM
CLK
CHAS.
CLK
TOWN
CLK
TRAM ROAD
ROCK
FAULT
CAMP
CLK
BRIDGE
SHAFT
CAMP
CLK
WOODLAND C C Co
TWP ROAD
J. W. COOKE
STONE
CHAS.
CLK