


3677

C.D. 355

D

Drainless No. 1
Elev. 21.641

Diamond Drill Hole No. 47
Elev. Surface - 1561.33
Bot. of Seam - 1499.41
Coal - 2.5'
Sandstone - 0.7'
Cost - 1.2

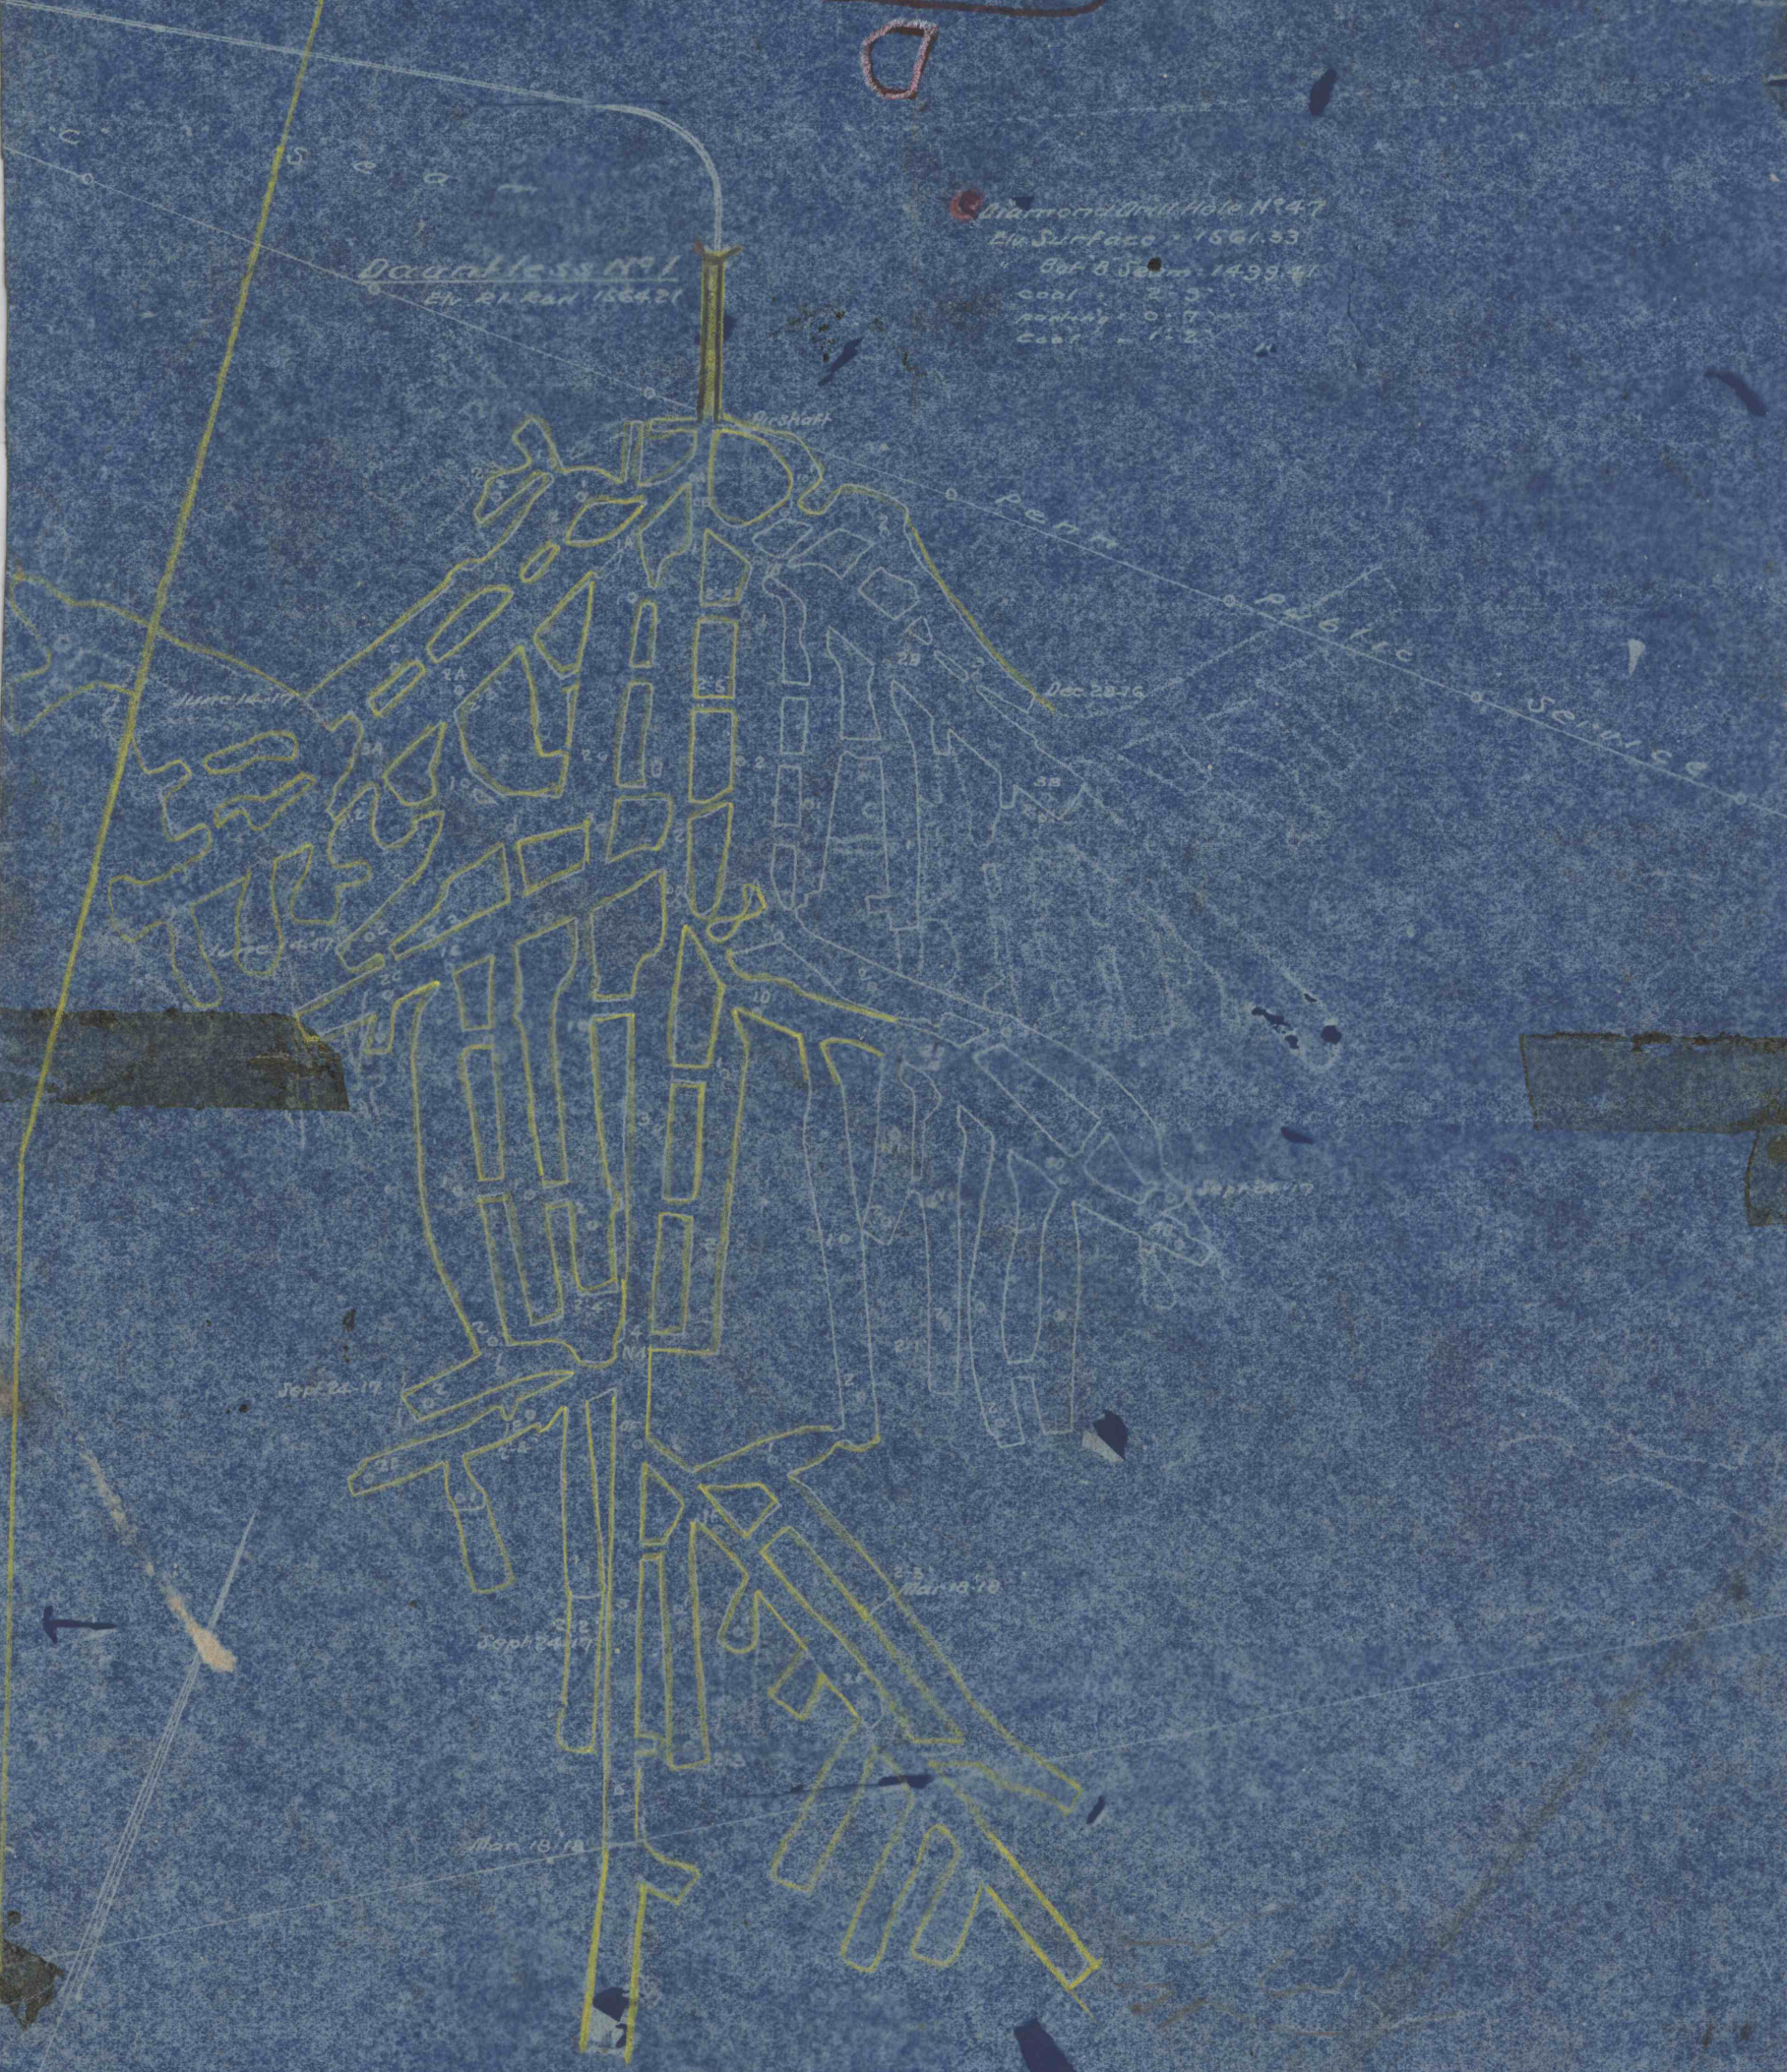

June 16-17

Dec 28-16

Sep 26-17

Mar 18-18

Depth 2417

Mar 18-18

Air shaft

Public

Public

Service

SEA