

3885

IVAN & LESTER WELD

TO UTAHVILLE

TOWNSHIP

EDGAR NEVLING

MARGARET


WILLIAM

GEO & VIVIAN MCOY

BLAKE MCOY
90 ACRES

MOSHANNON SMITHING COAL CO.
NOW
GLEN MAR COAL COMPANY

MOSHANNON SMITHING COAL COMPA
NOW
GLEN MAR COAL COMPANY

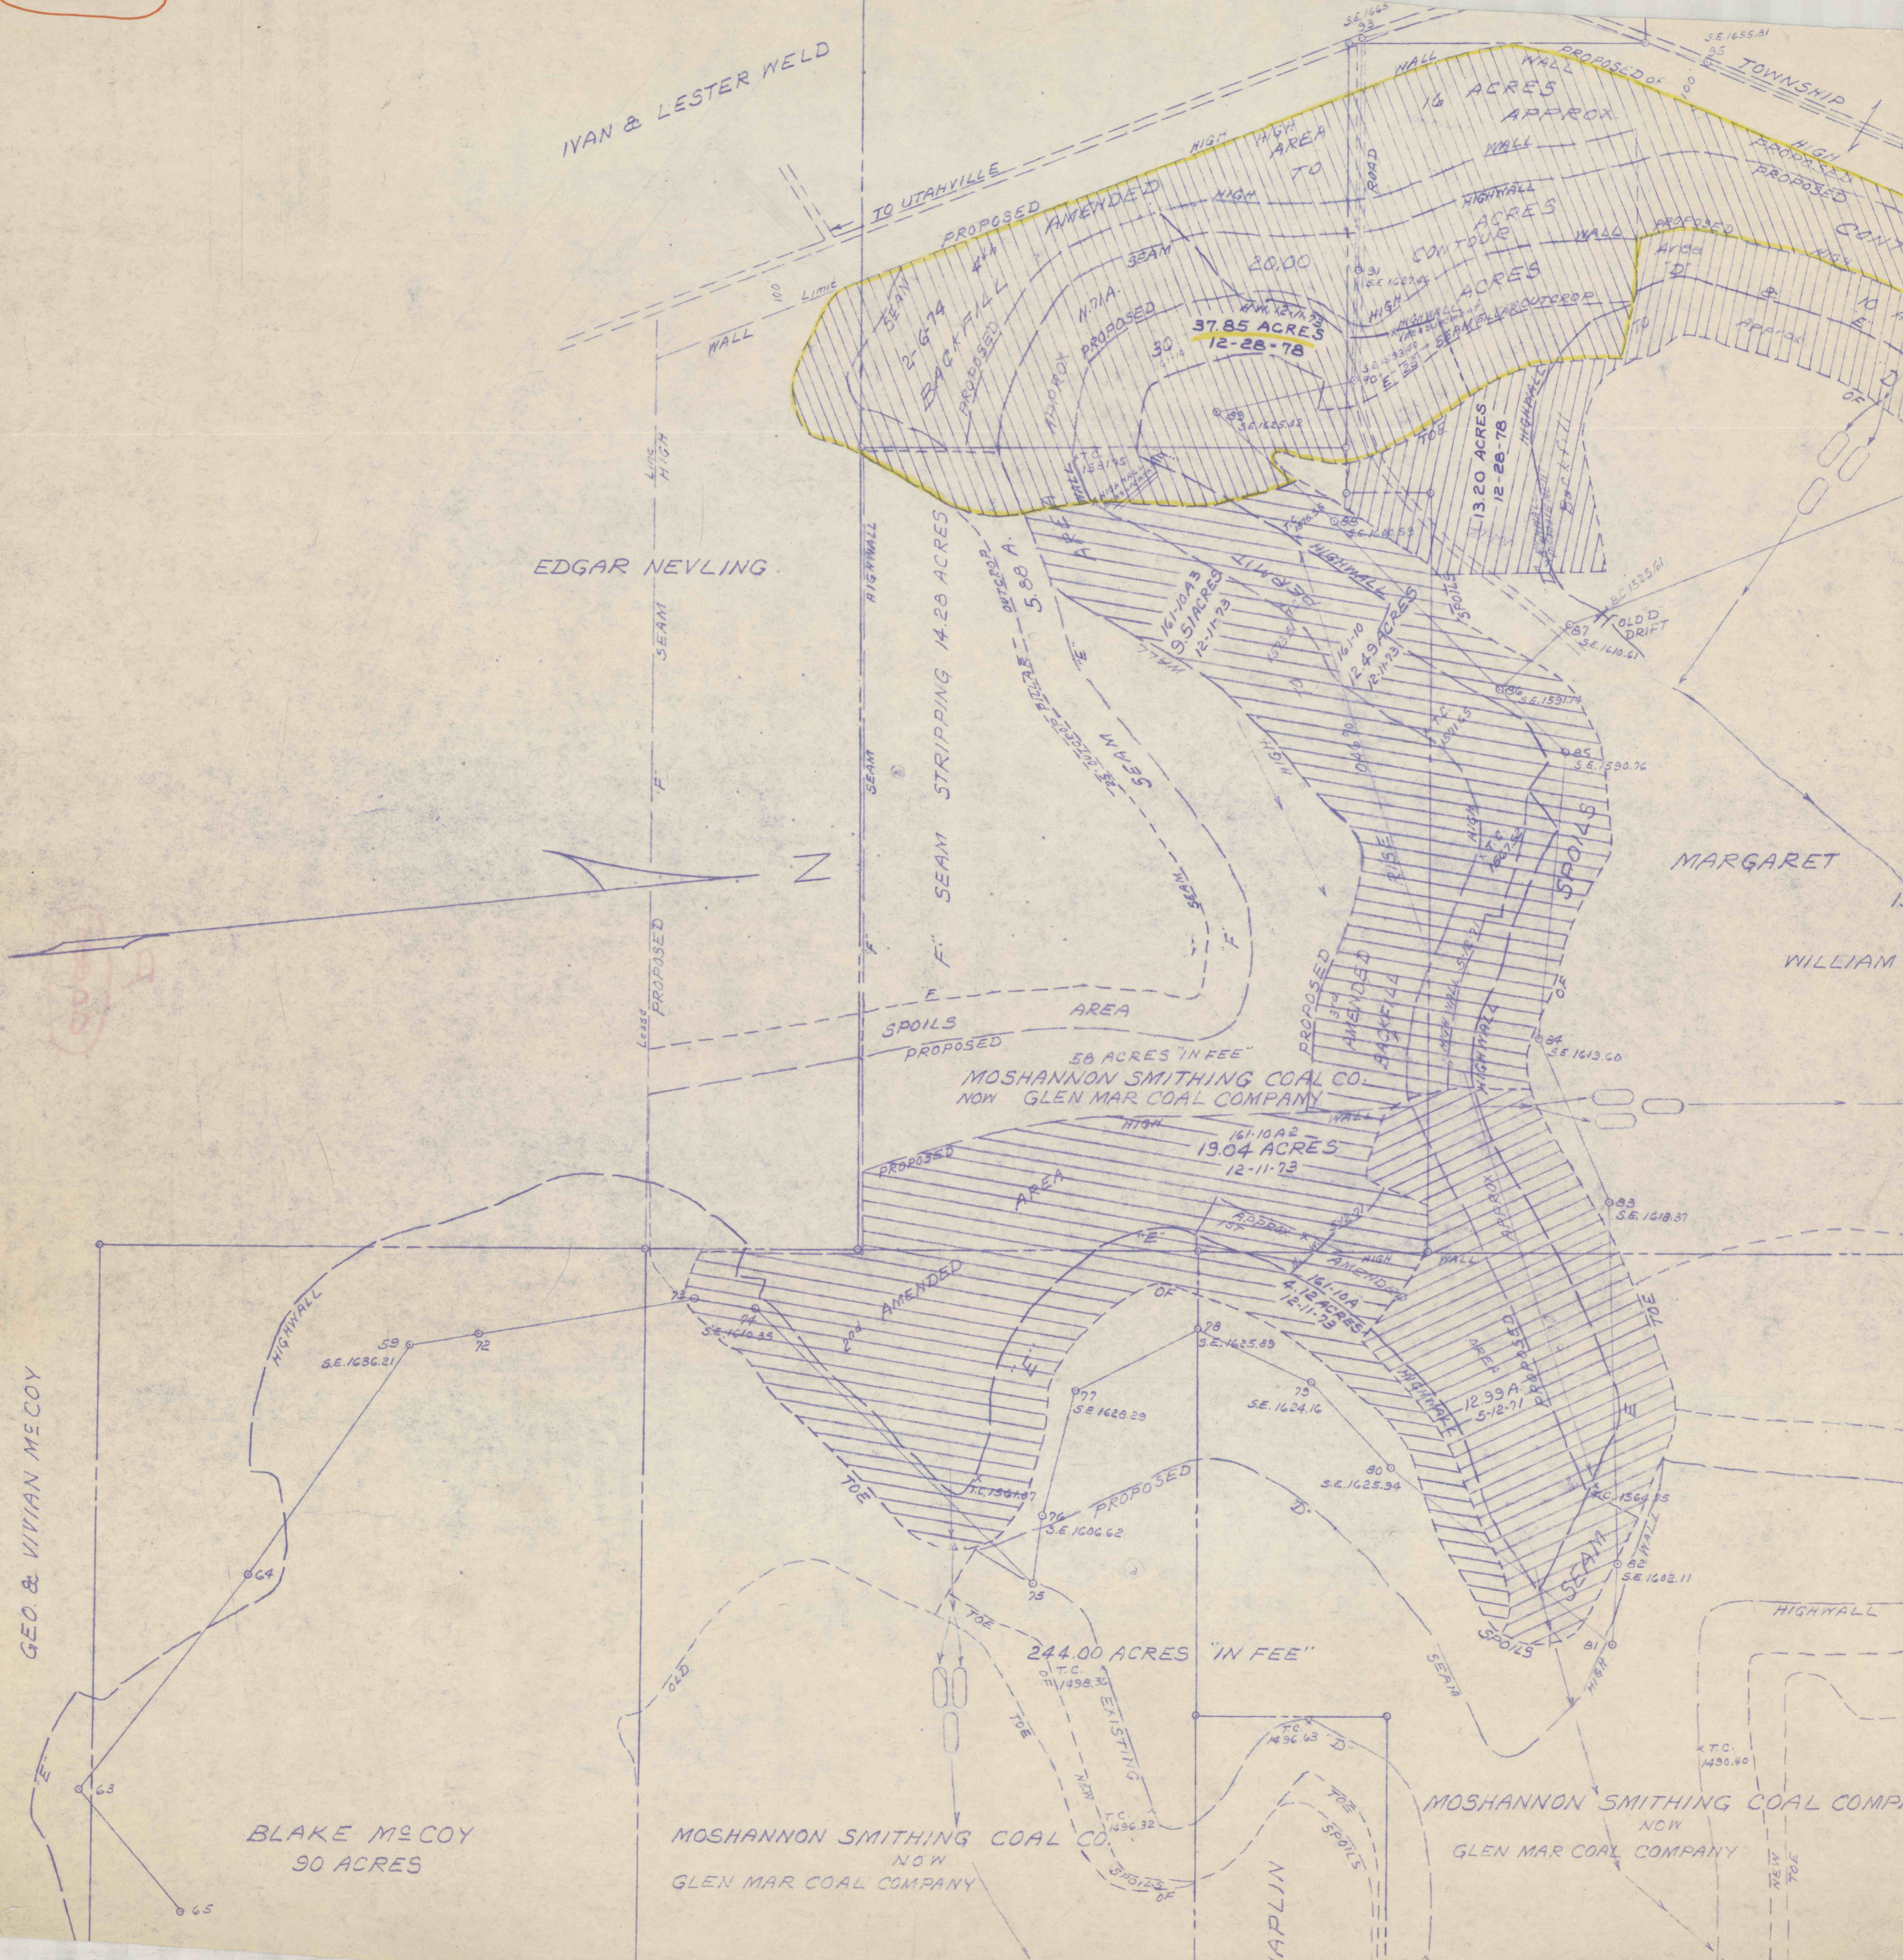

3850