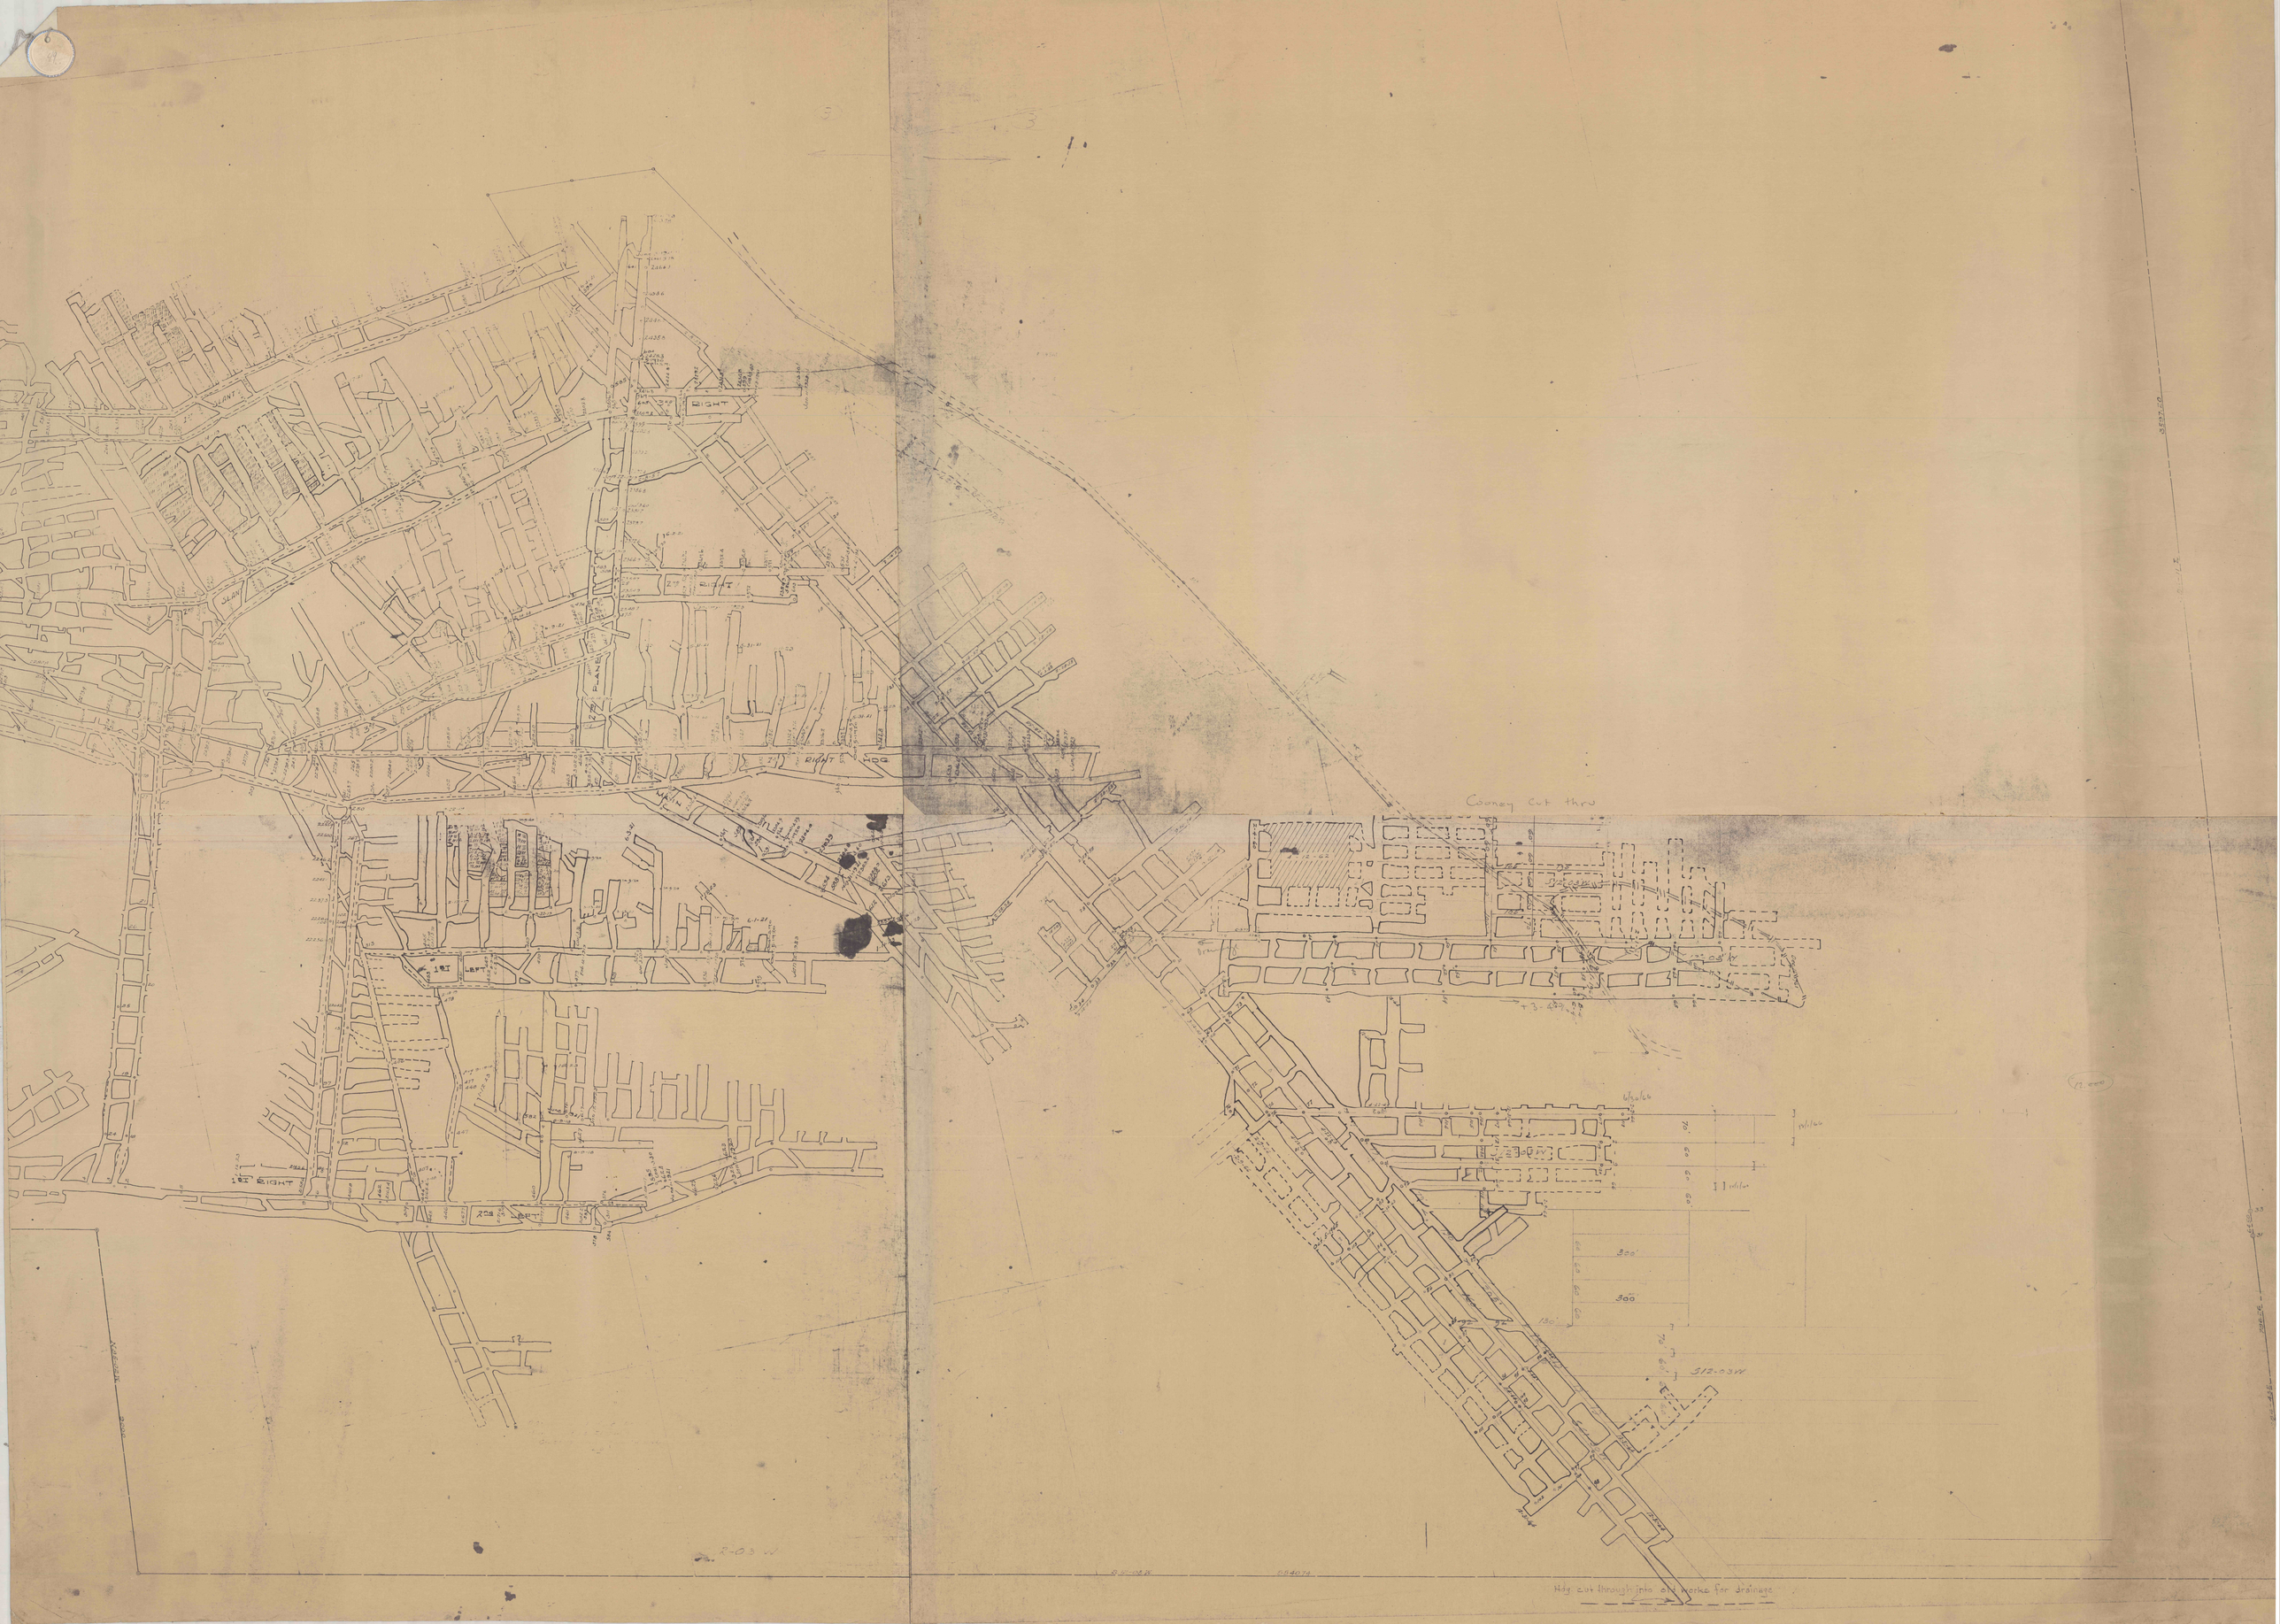

Cooney cut thru
RIGHT
SLANT
PLANE
MAIN
1ST LEFT
1ST RIGHT
2ND LEFT
300'
300'
512-03W
Hdg. cut through into old works for drainage