

Geo. Wescott
TRACT


CALEB FOLK
TRACT



PETERS OYIENS (Surface)
BEECH CREEK COAL & COKE CO. (Coal)

Christopher O'Connor
A.M.S.

Probable
OUTCROP

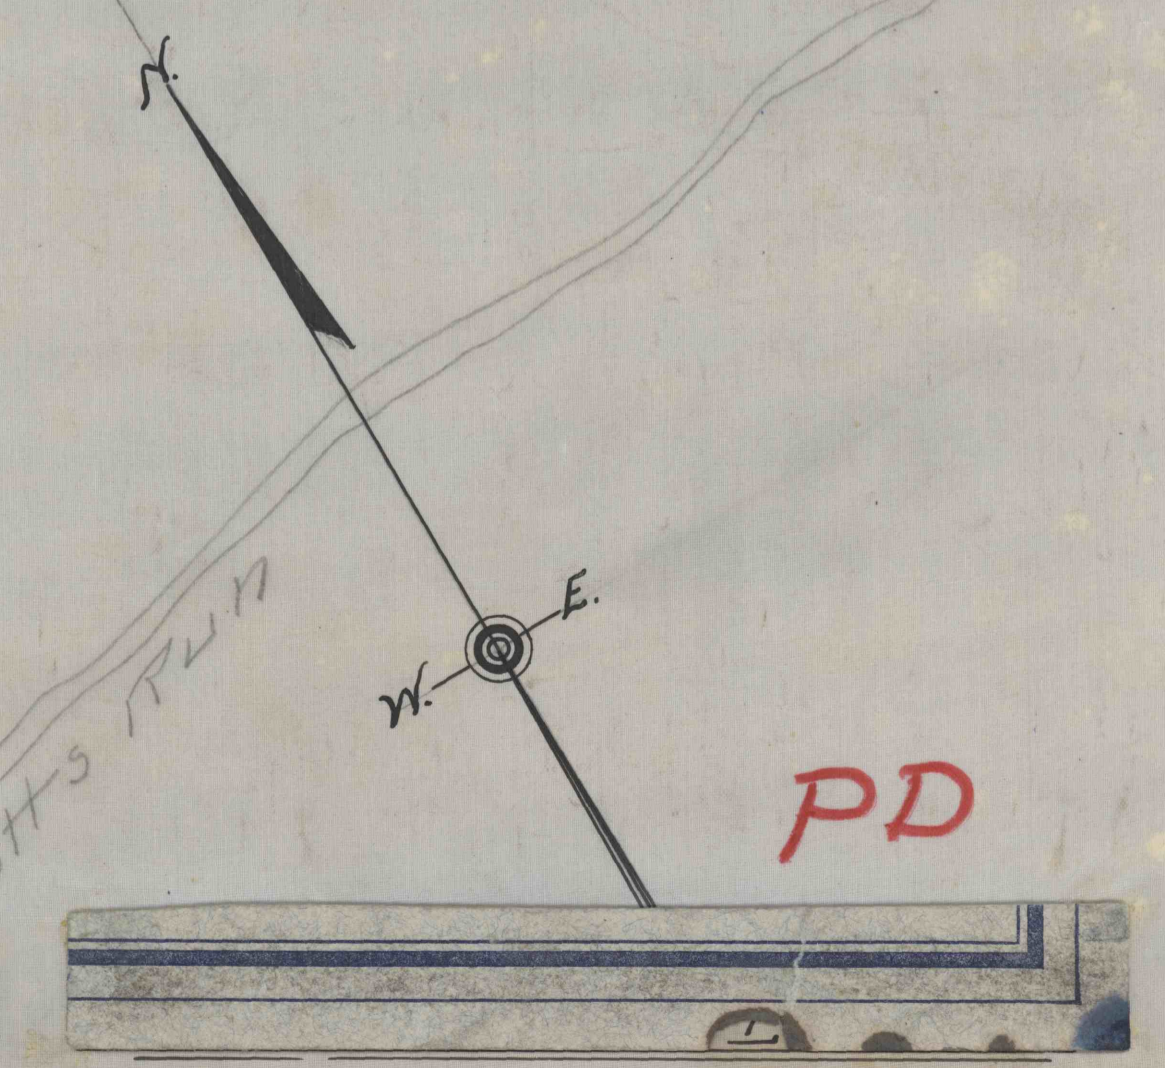

MAP OF KELLY MINES,
 KNOX TOWNSHIP CLEARFIELD CO. PA.
 Clearfield Pa.
 Mar. 10-1913
 Re-surveys
 Dec. 28-1915

Office of E.W. Hess,
 Engineer.

1391

2525

2522