



S.G.S.C. DAVIS

J. SWITH EST

P. FLYNN  
GILL SURFACE


A. C. SWITH II

SHOYLE TRACT  
SAMBRIH SANDKELISS

D. SAMPLE

P. FLYNN  
Geo. McGAFFEY EST SURFACE

D.W. DILLON

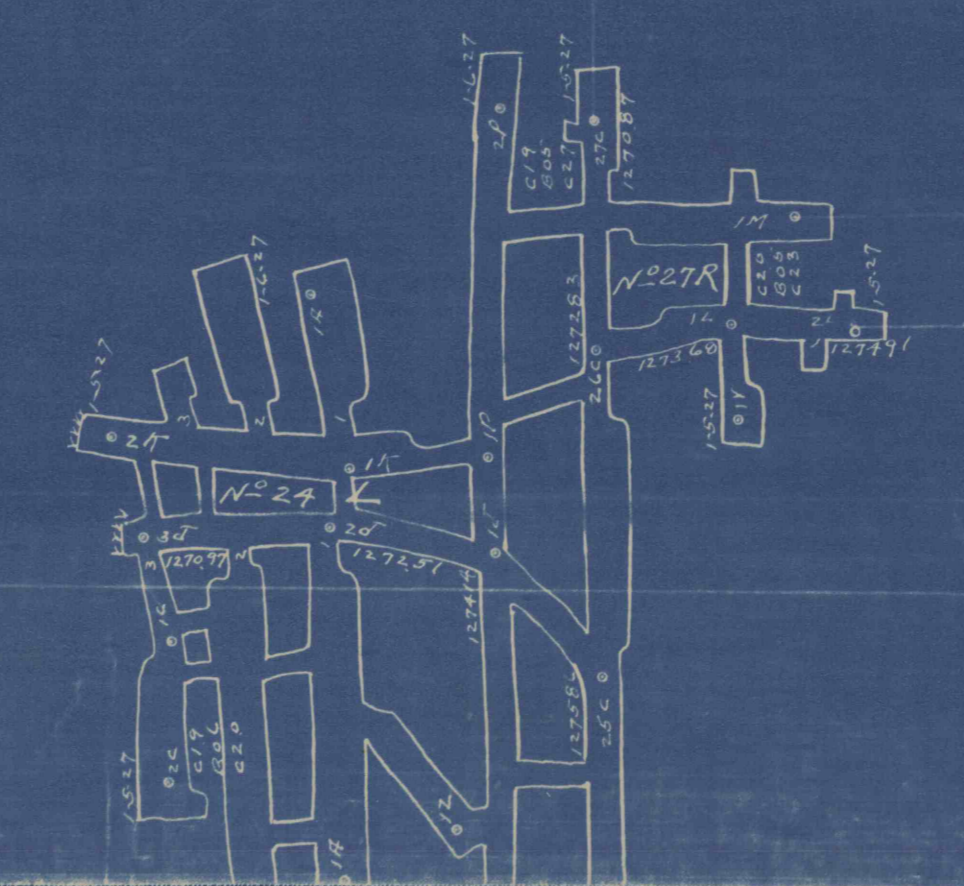

6783  
6784