


# FERNWOOD SHAFT

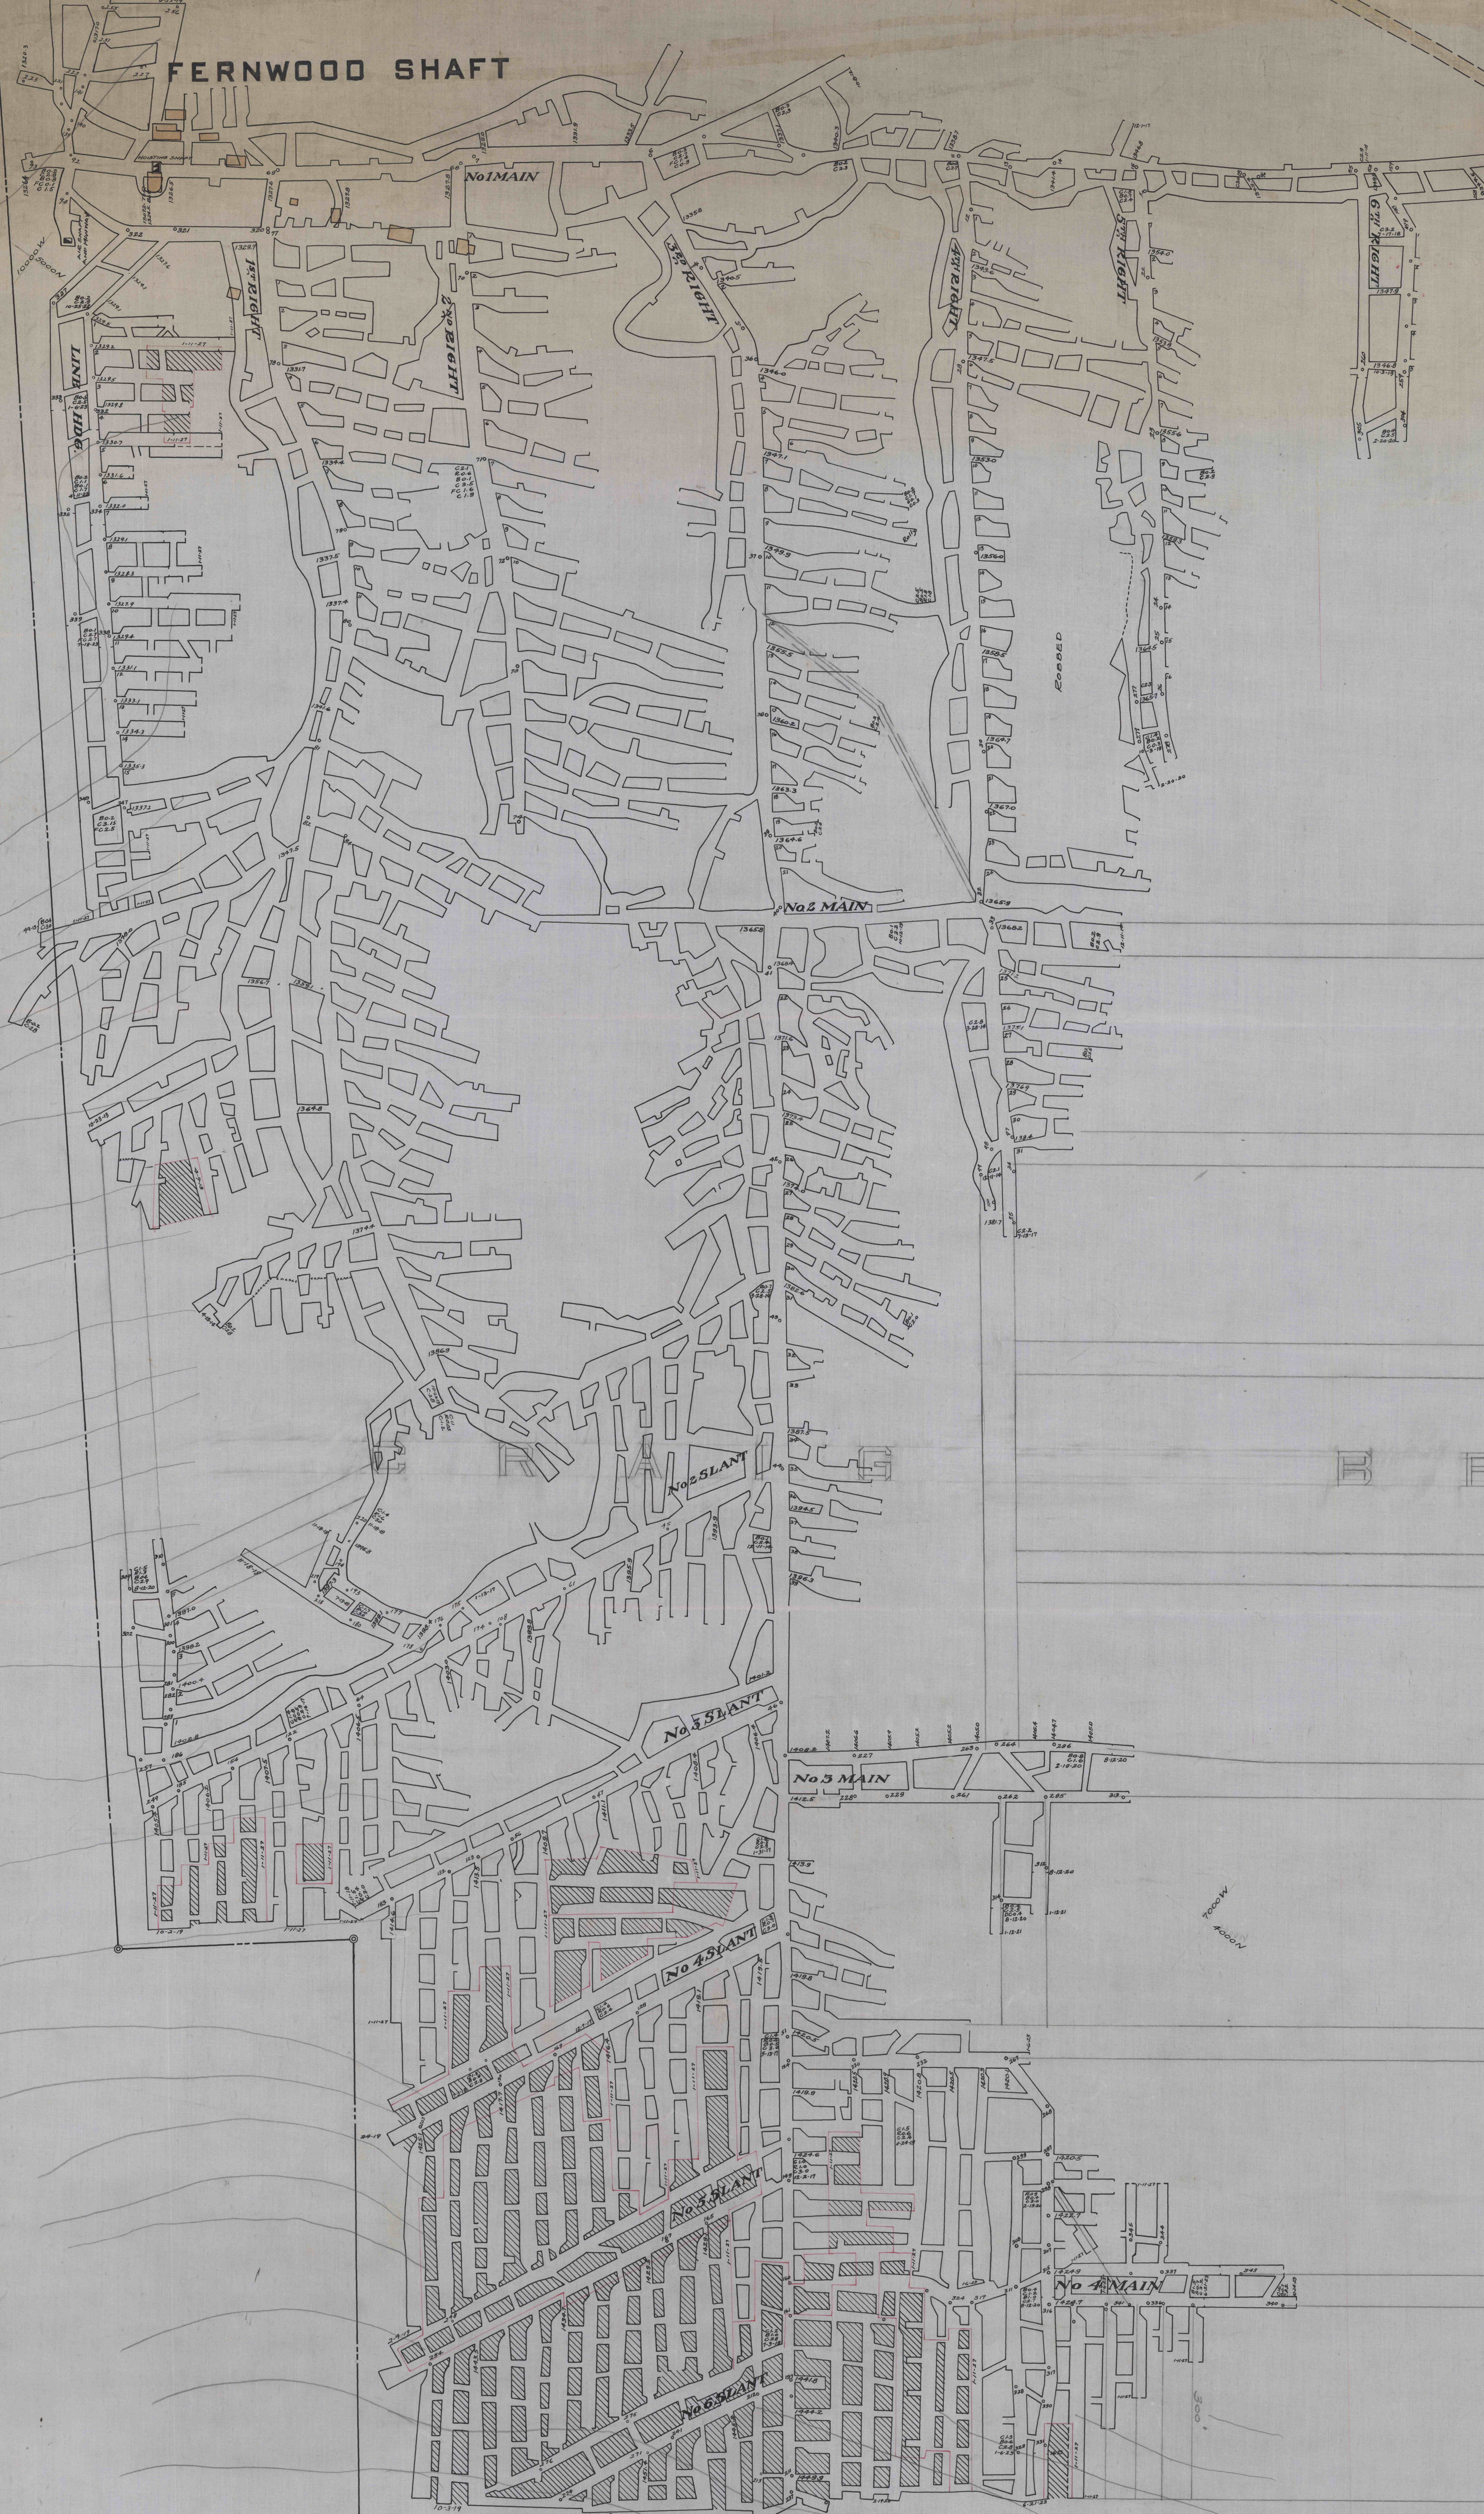

7019

8010  
PLOT D

D  
8010