


ADAM PINTO FARM  
GENERAL REFRACTORIES CO. MINERAL RIGHTS.

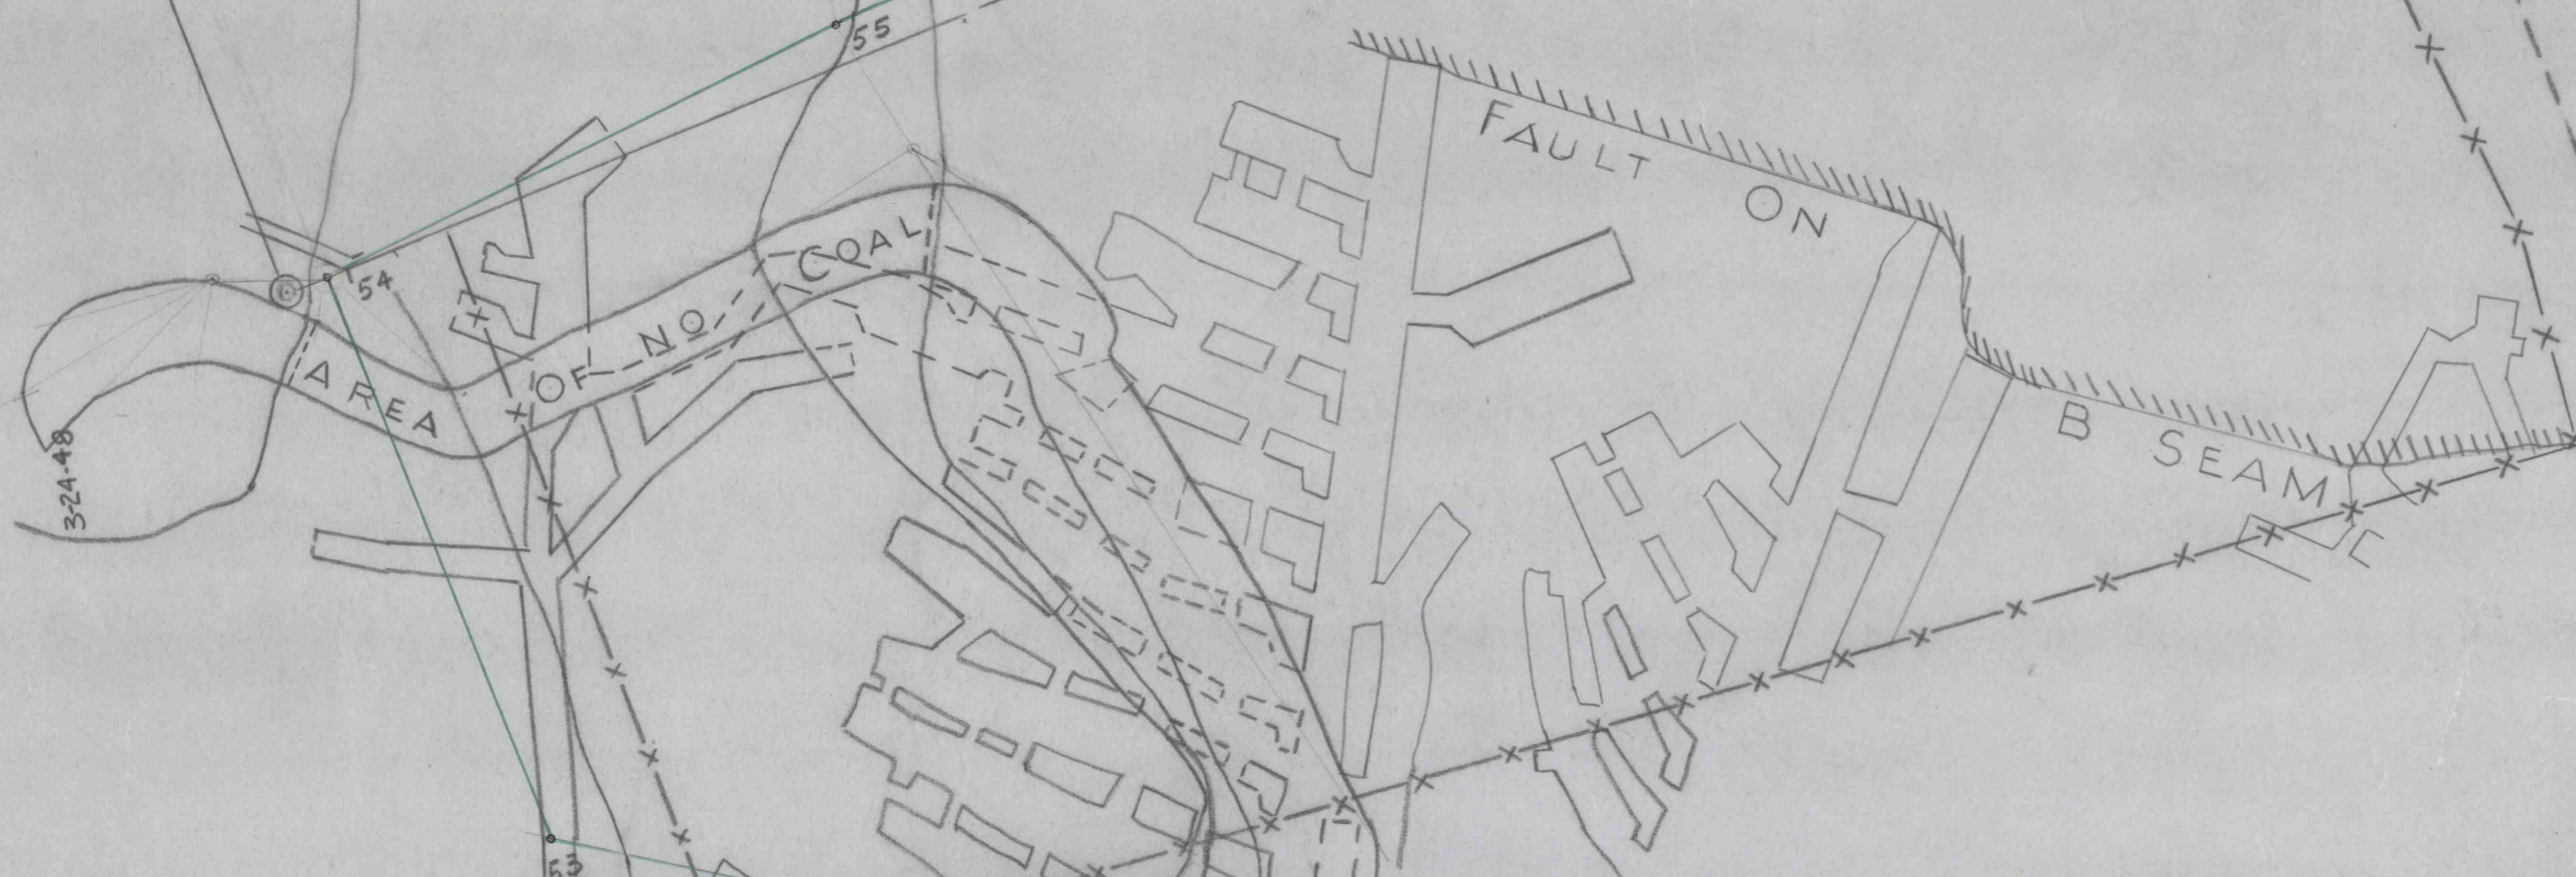

SAMUEL HAMBLE  
KITTANING

J. B. NEVLING ESTATE.

FAULT

SARA #1 MINE

CRAIG BROTHERS

JOHN S. BLAIR TRACT.

7014

7015

PMD