

TRACT 3592

TR. 4377

BARRY & MASON TR



TRACT 1239

TRACT 13

TRACT 2009

MINNS

TRACT 3584

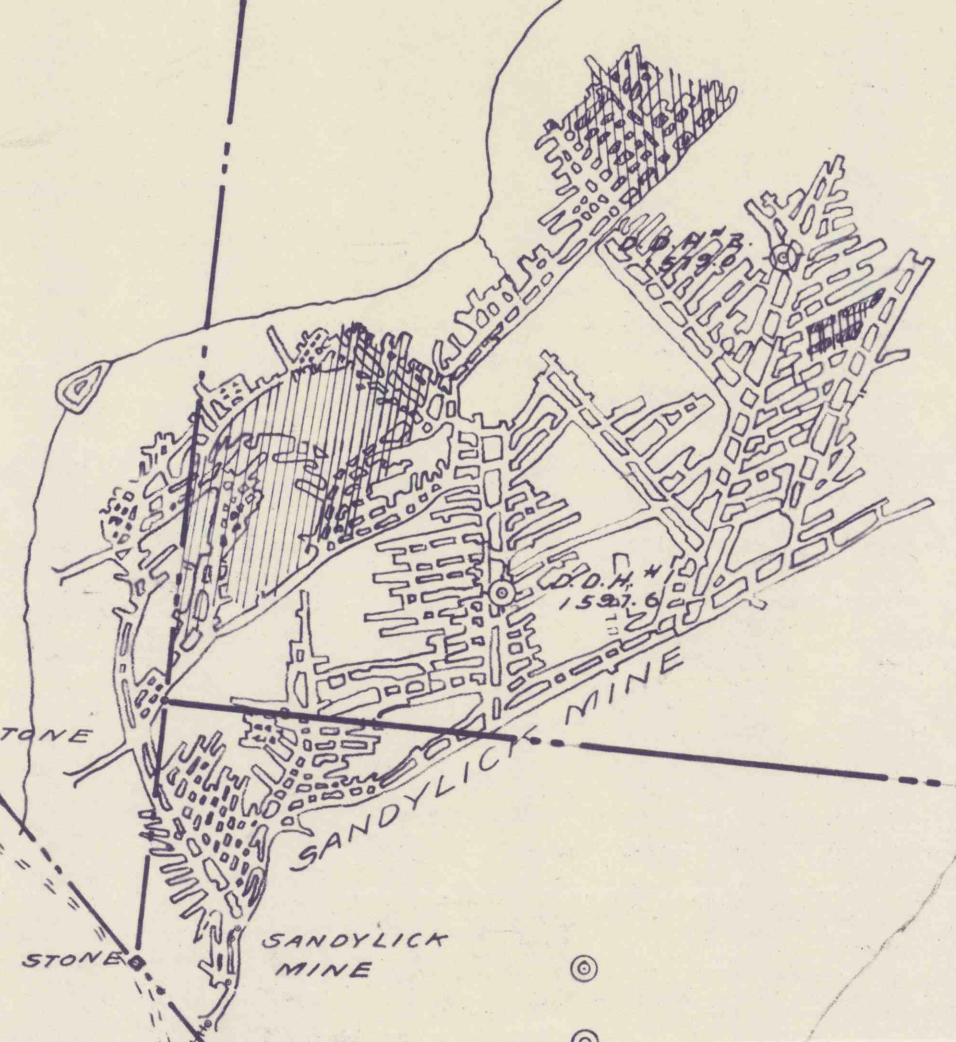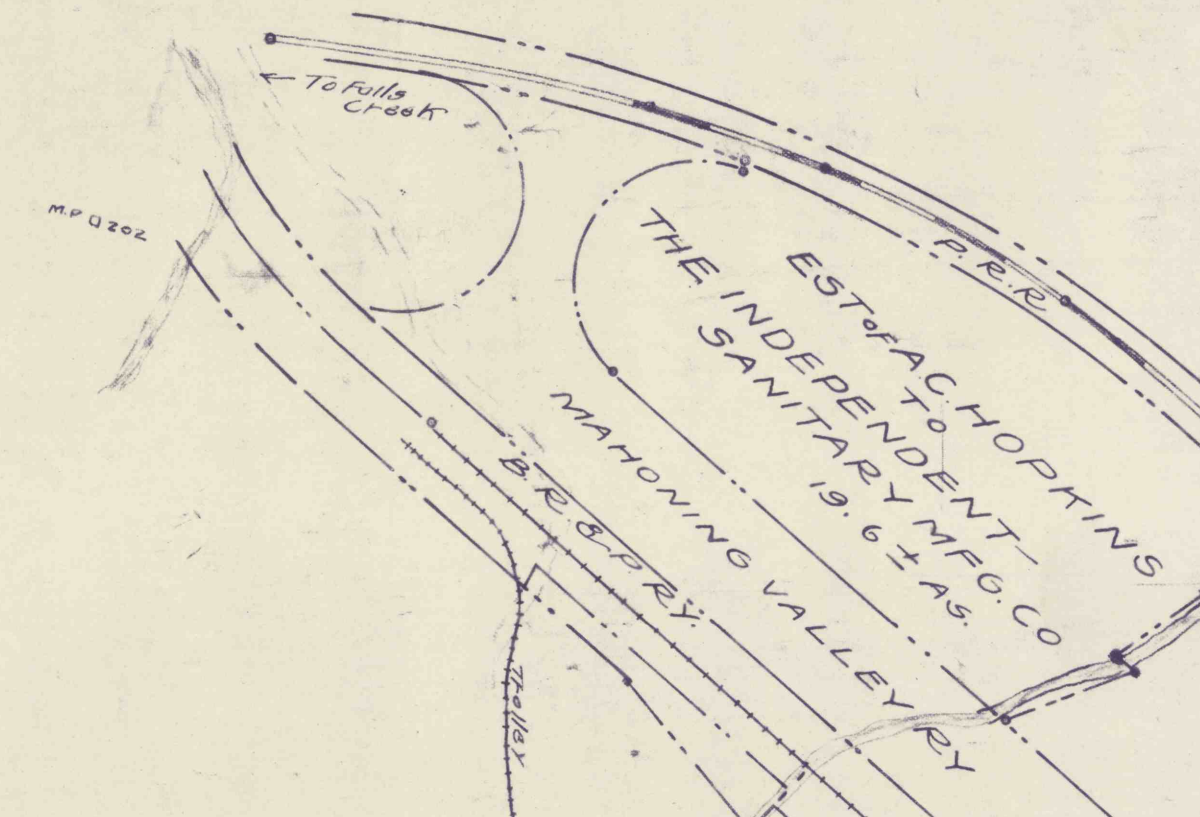

OFFICE OF
 ENGINEER
 DUBOIS, PA
 MAP NO. 9-31-21
 1-9-22