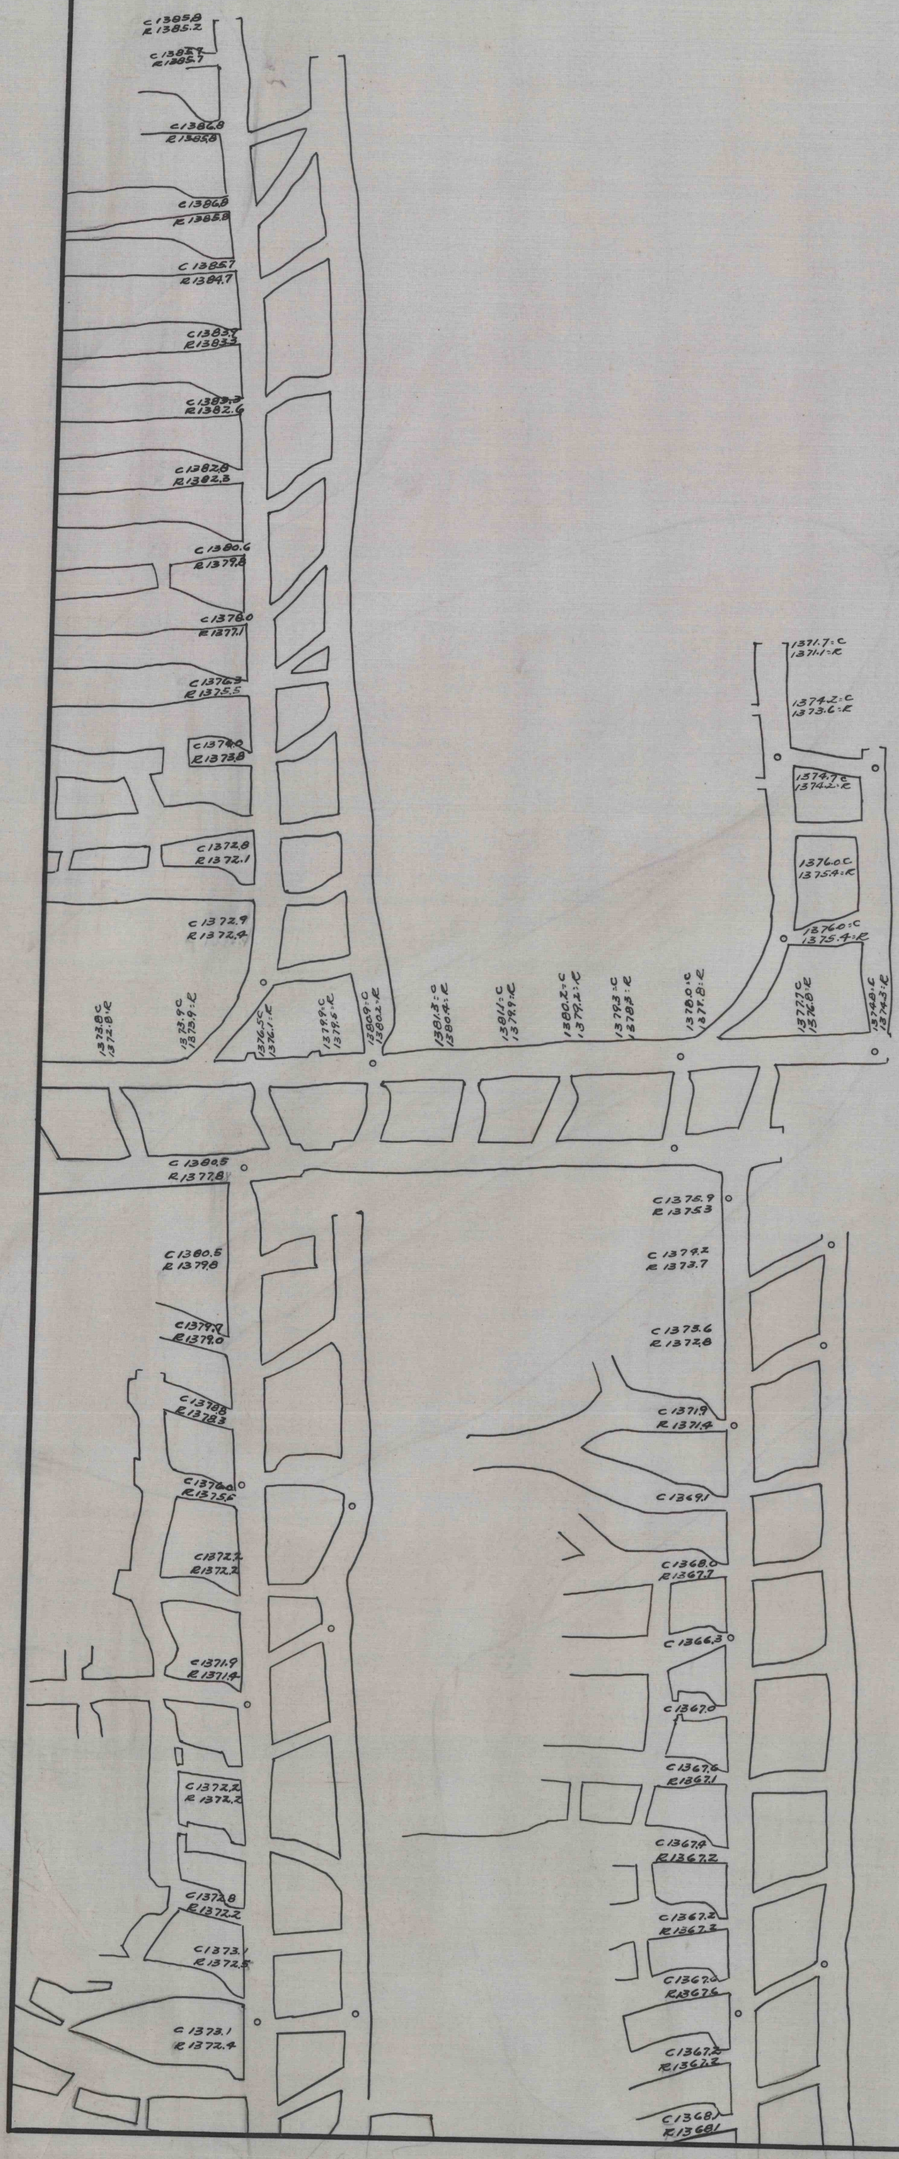
C 1385.8
R 1385.2
C 1386.8
R 1385.8
C 1386.8
R 1385.8
C 1385.7
R 1384.7
C 1382.8
R 1382.3
C 1380.6
R 1379.8
C 1378.0
R 1377.1
C 1372.8
R 1372.1
C 1372.9
R 1372.4
1371.7:C
1371.1:R
1374.2:C
1373.6:R
1376.0:C
1375.4:R
1376.0:C
1375.4:R
C 1380.5
R 1377.8
C 1380.5
R 1379.8
C 1375.9
R 1375.3
C 1374.2
R 1373.7
C 1373.6
R 1372.8
C 1371.9
R 1371.4
C 1369.1
C 1368.0
R 1367.7
C 1366.3
C 1367.0
C 1367.6
R 1367.1
C 1367.4
R 1367.2
C 1367.2
R 1367.2
C 1367.0
R 1367.6
C 1367.2
R 1367.2
C 1368.1
R 1368.1
C 1372.2
R 1372.2
C 1371.9
R 1371.4
C 1372.2
R 1372.2
C 1372.8
R 1372.2
C 1373.1
R 1372.4