


8117

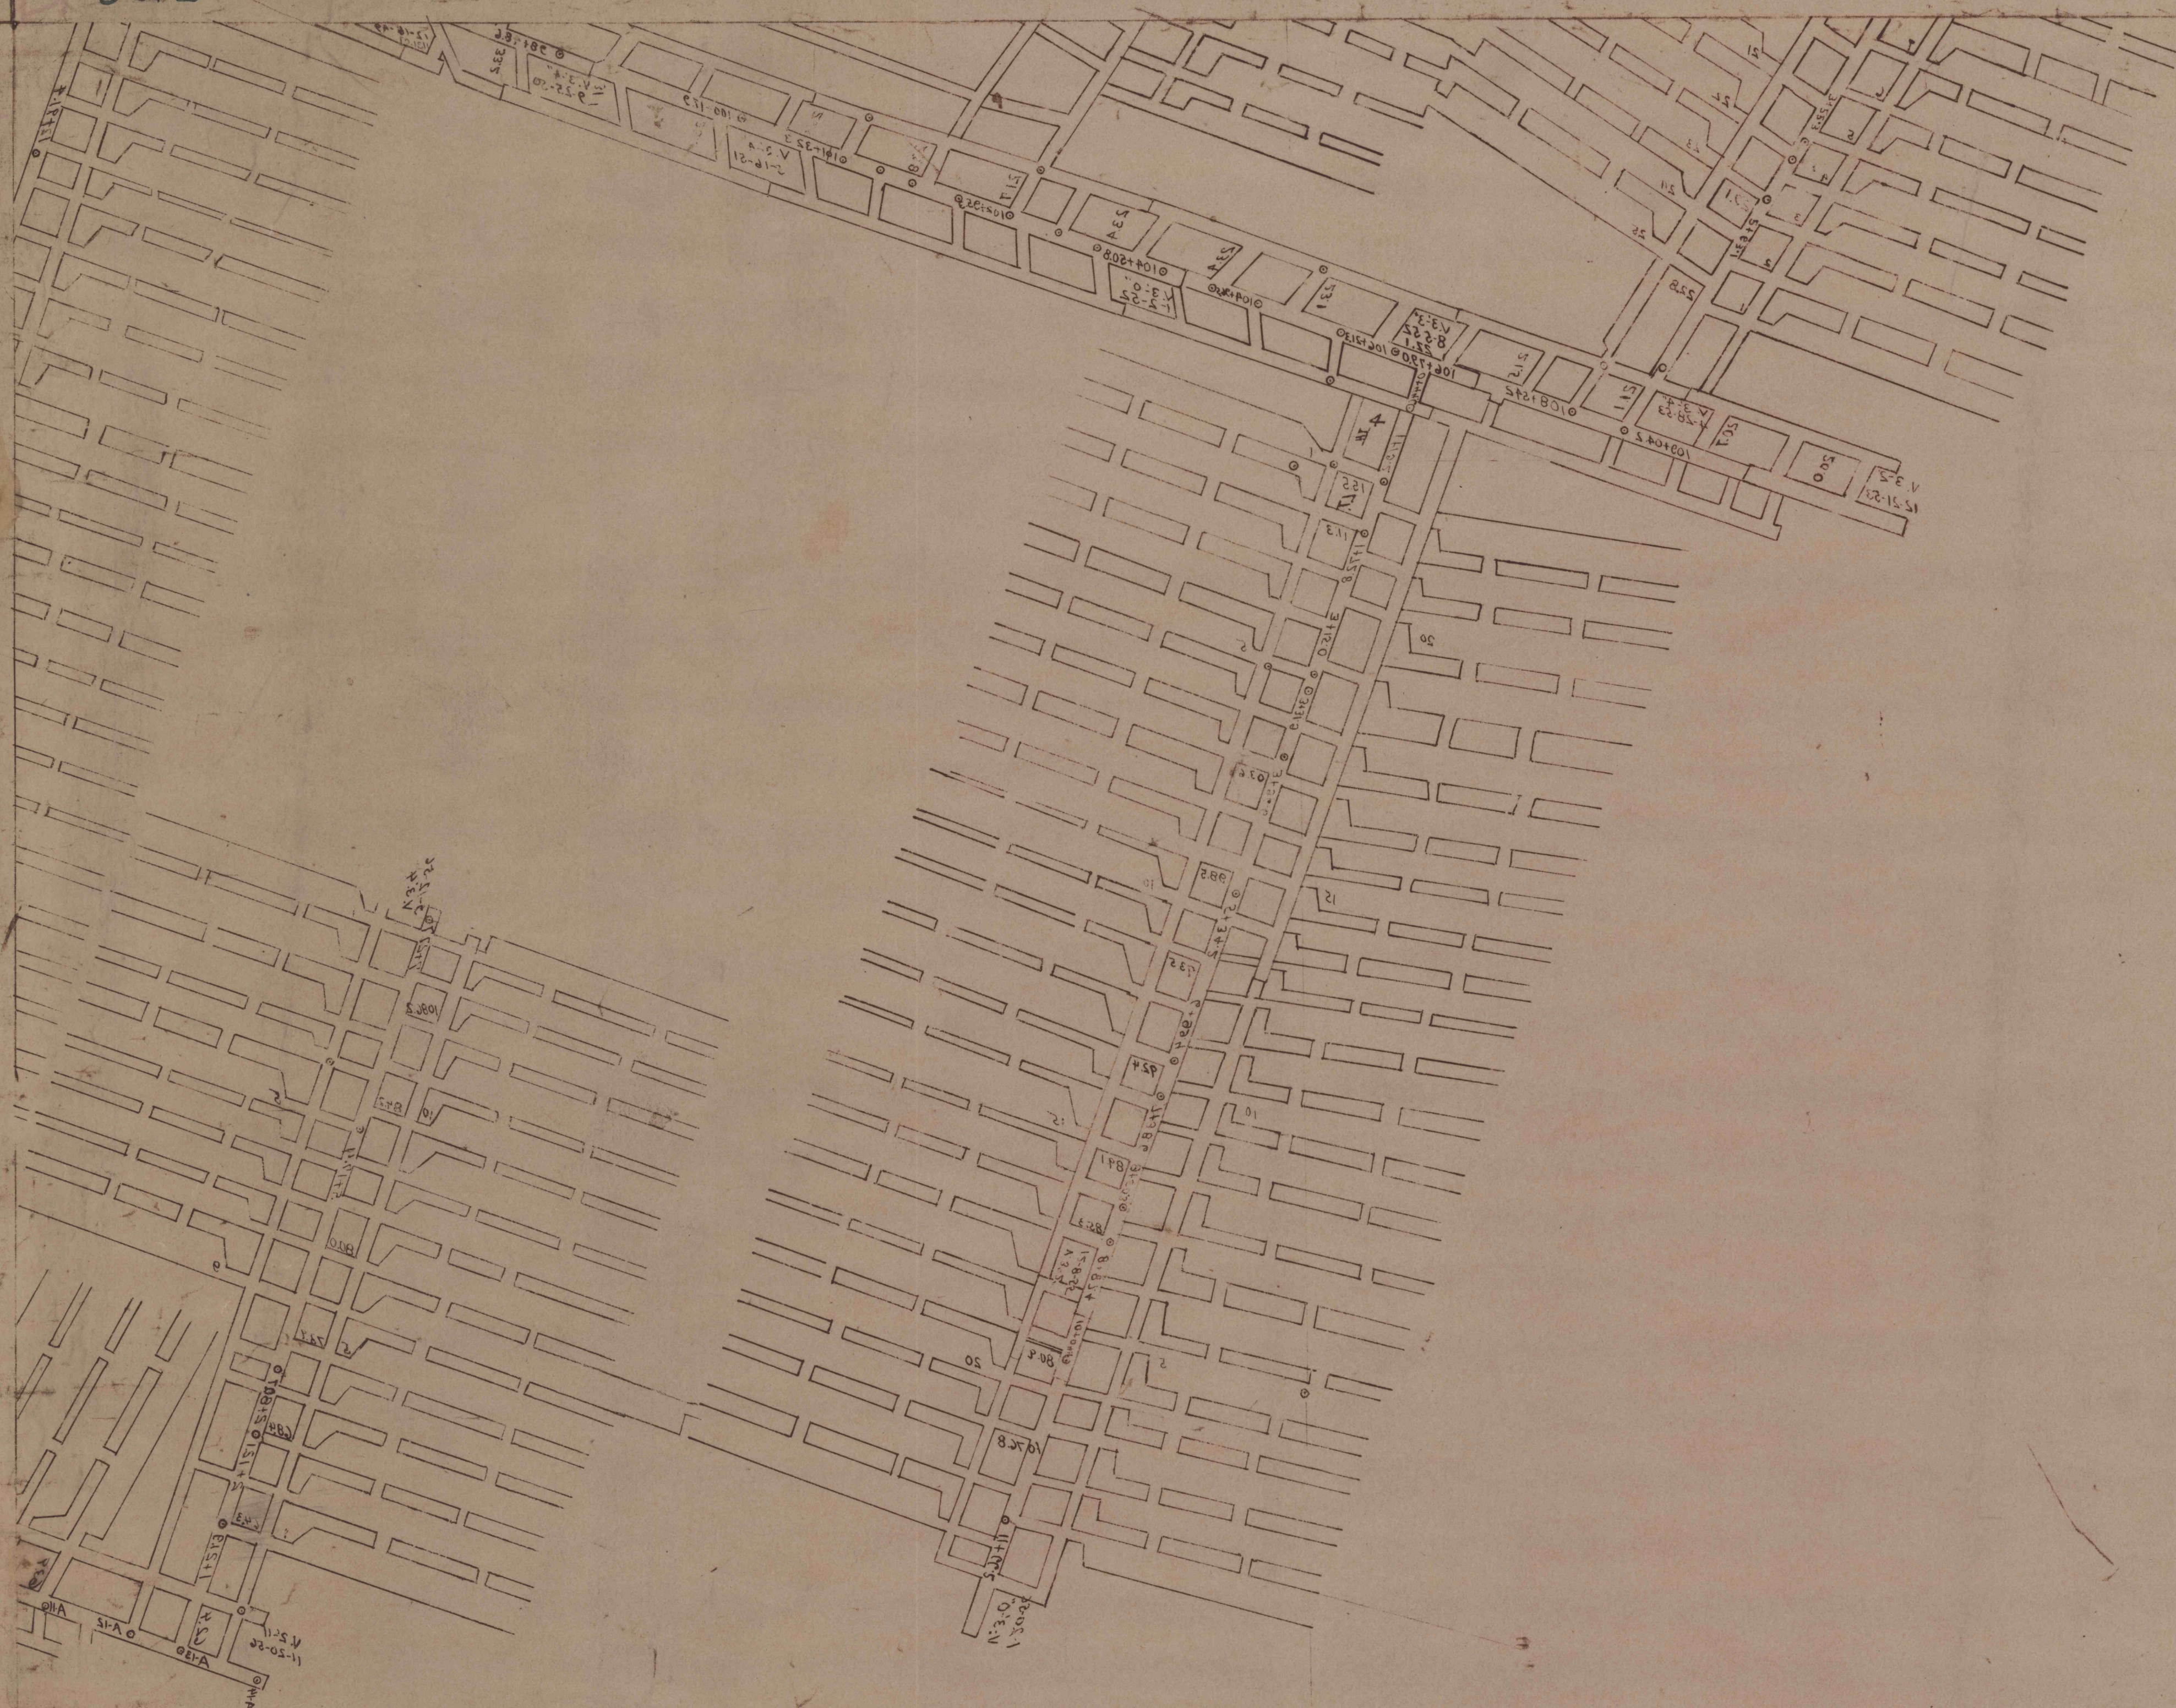

D