
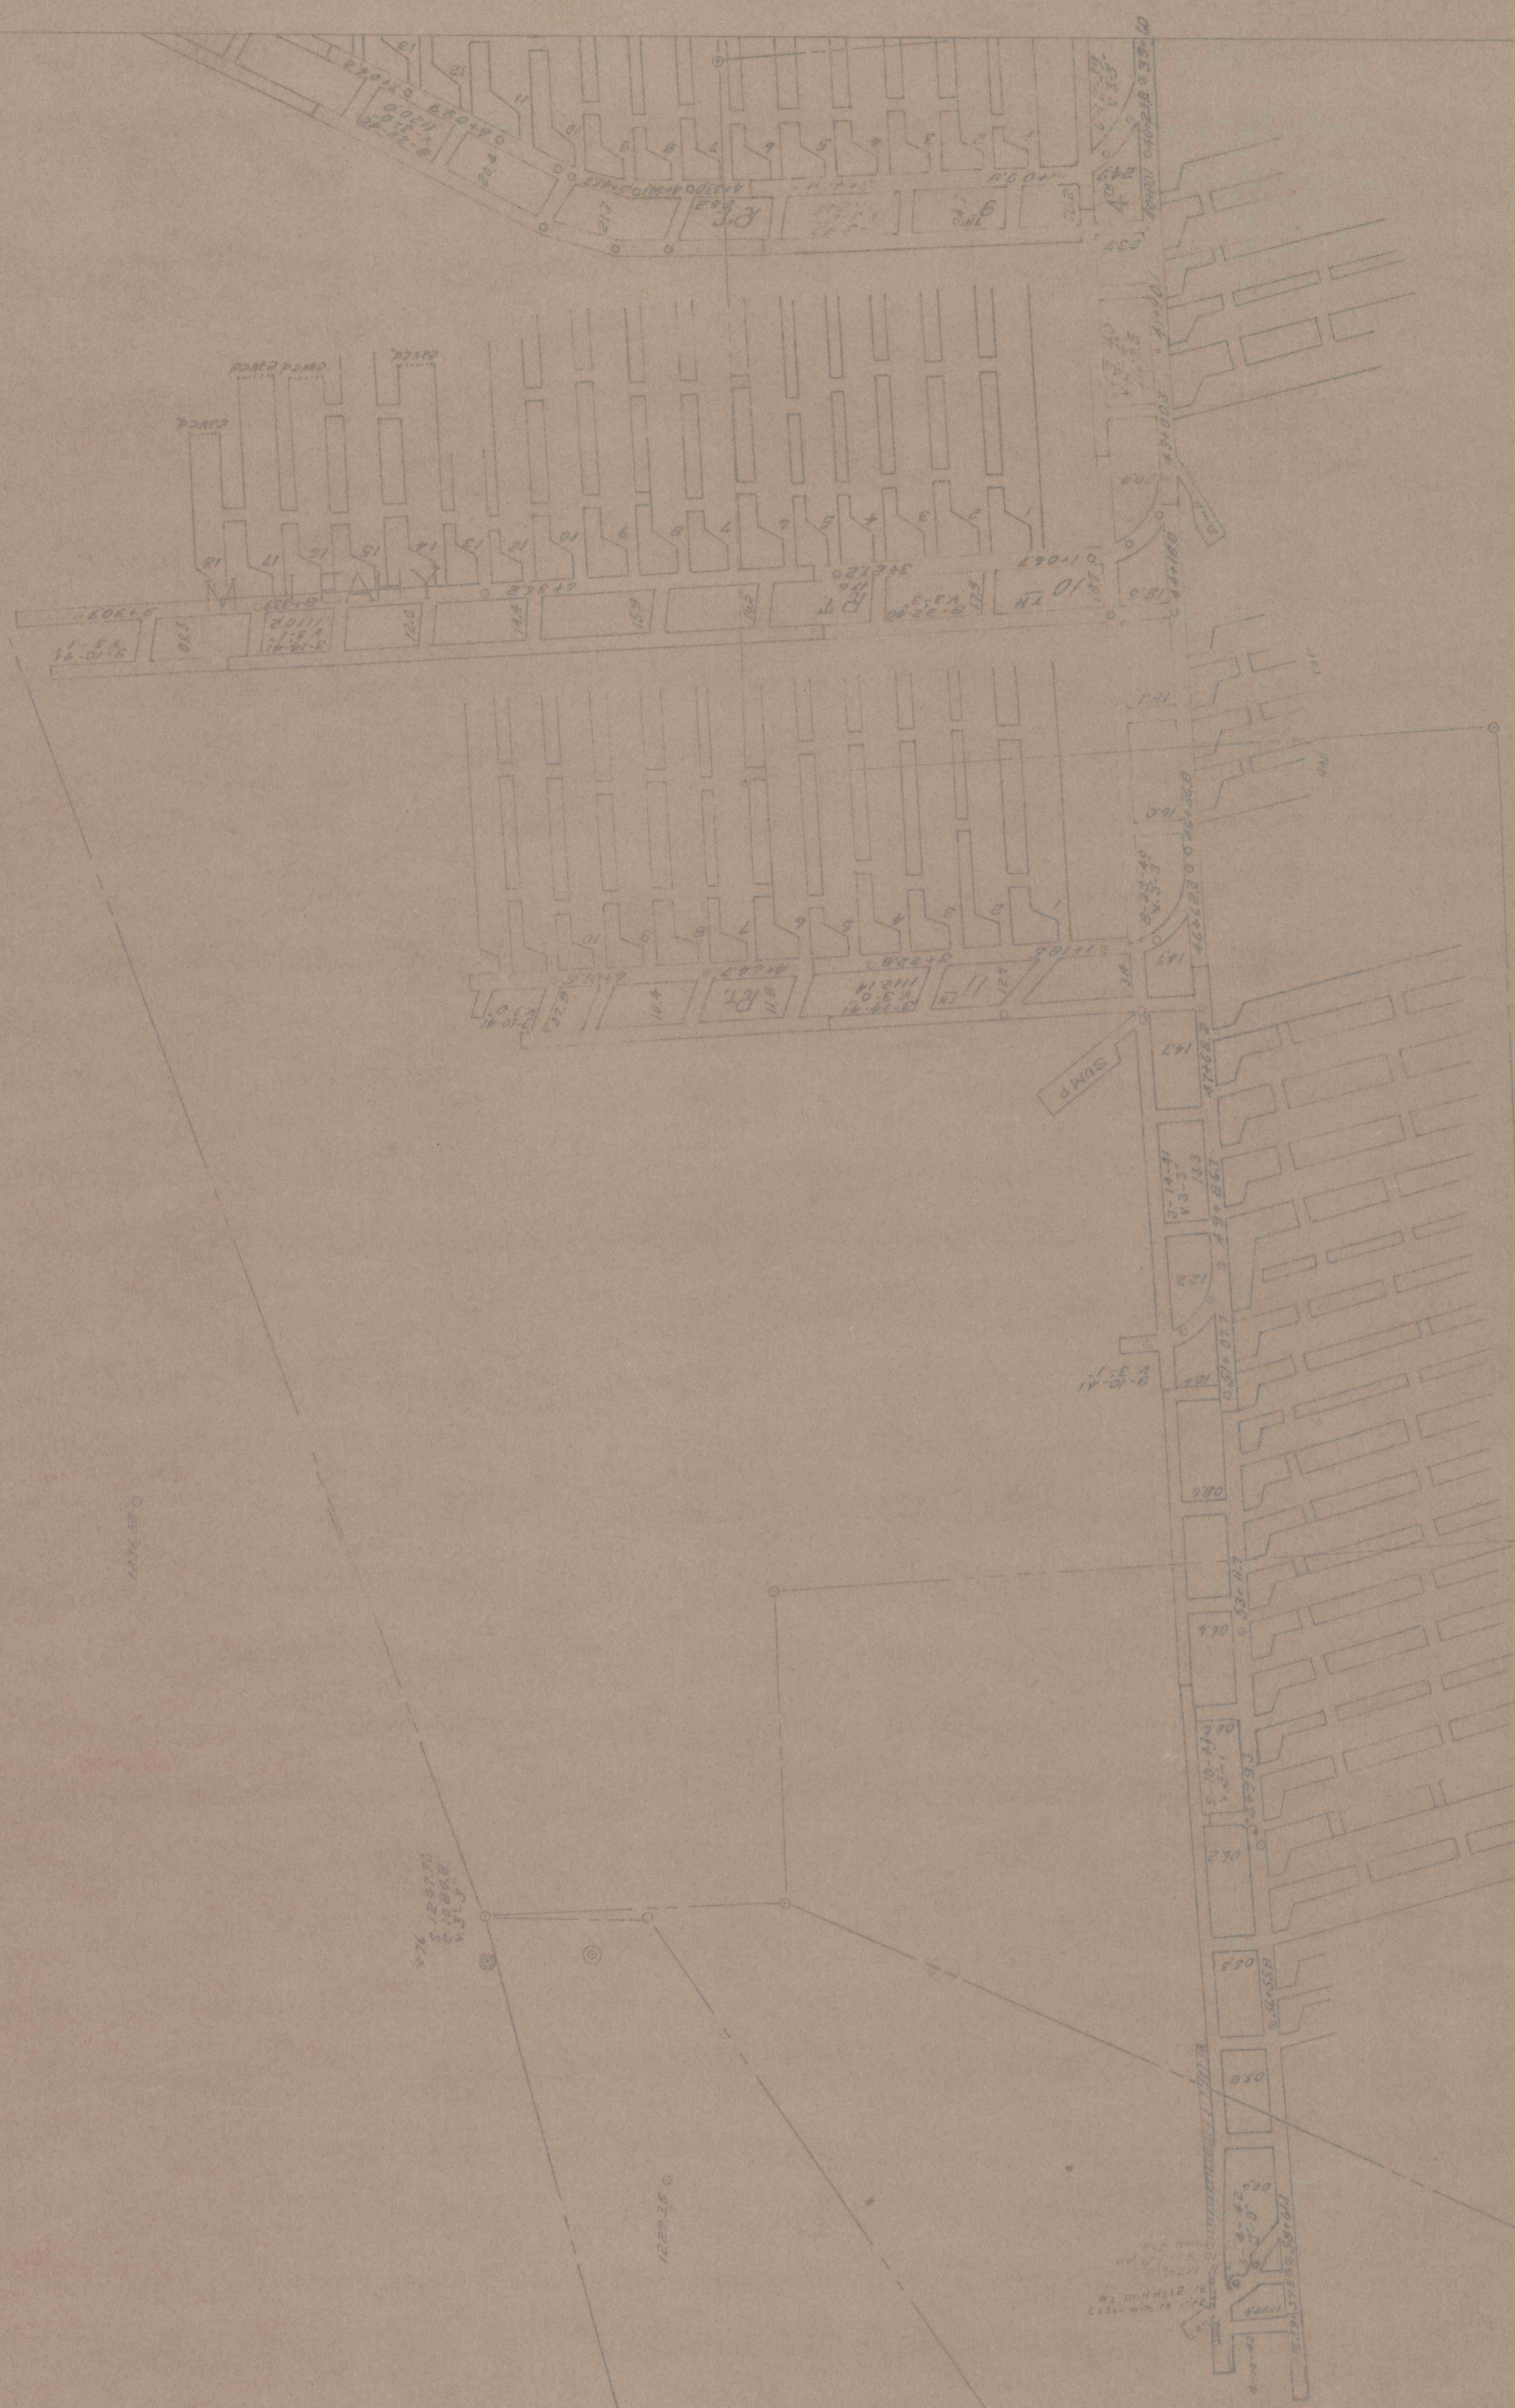


5117

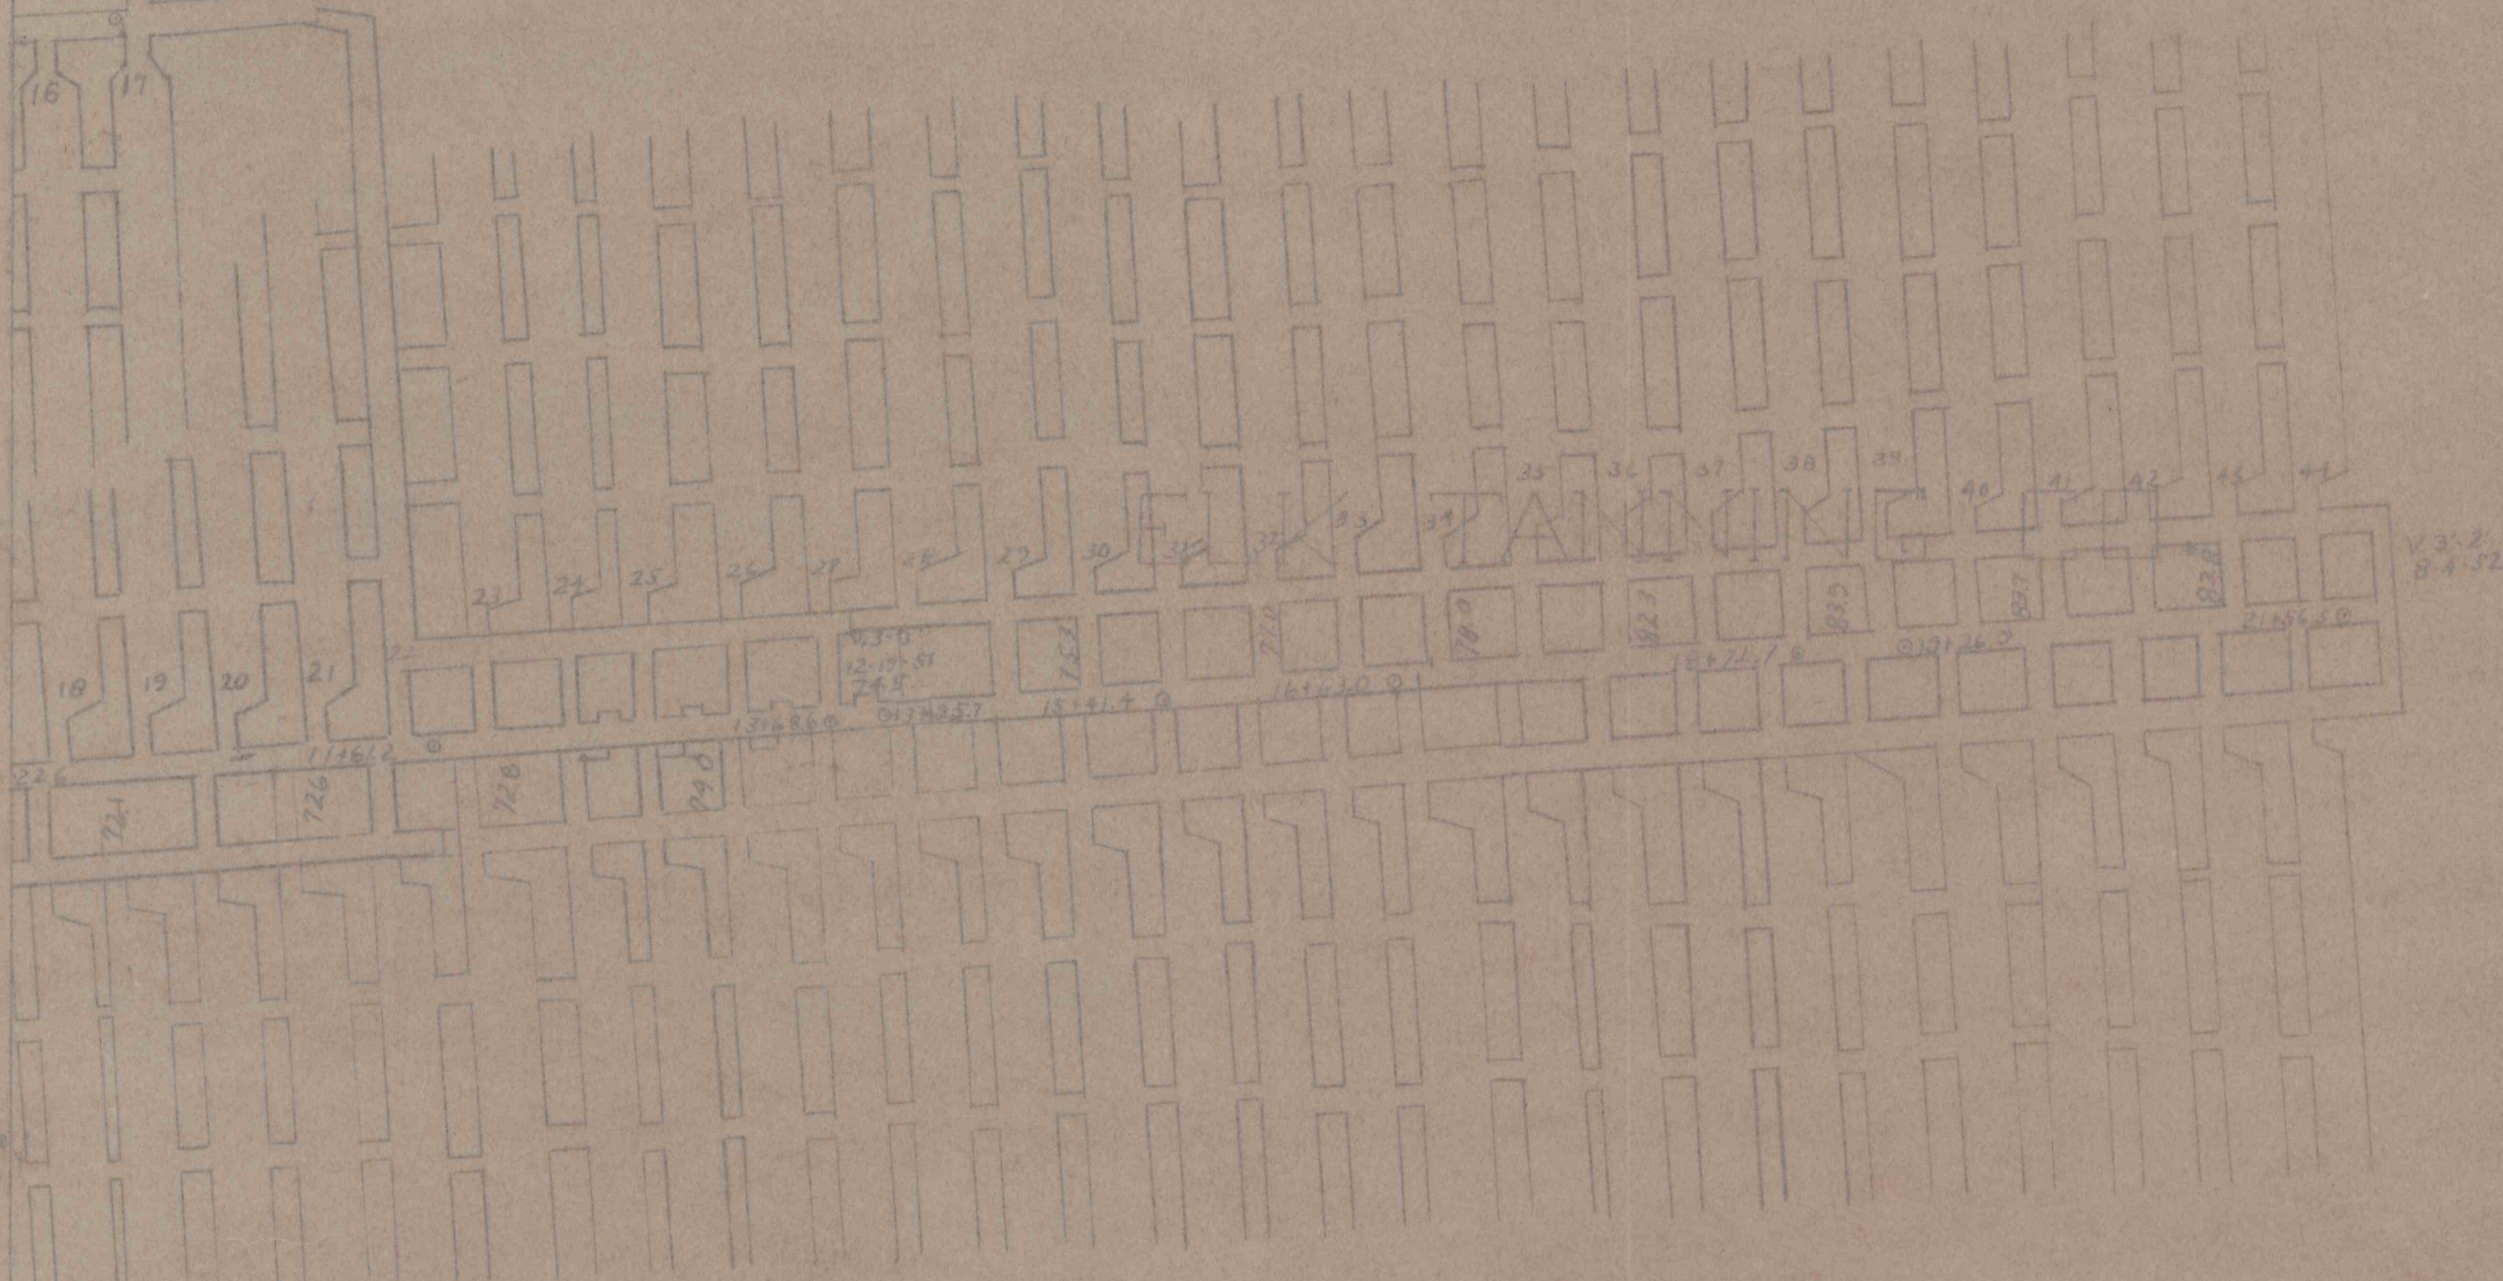

E HEWITT

M LEAHY

C KING

G.W. BLISS

W.J. LANNICK

10 - 15 - 1944
11 - 15 - 1944
12 - 15 - 1944

7177

5117